



**GUARD RAIL REQUIRED**  
 LEFT  
 STA. 214171 to 215118 = 24 ft  
 " 216193 to 217117 = 27 "

**RIGHT**  
 STA. 214191 to 215115 = 24 ft  
 " 216199 to 217117 = 27 "

TOTAL THIS SHEET: 96 ft

**NEW CULVERTS REQUIRED**  
 STA. 215103 4x3' Reinforced Concrete Box  
 Class A Conc. (1-2-4) 13 1/2 cy  
 Reinf. Steel 925 lb

STA. 217105 18" Conc. or Cast Iron Pipe Culvert Length 32 ft  
 Class B Conc. (1-2-4) 27 cy  
 Reinf. Steel 33 lb

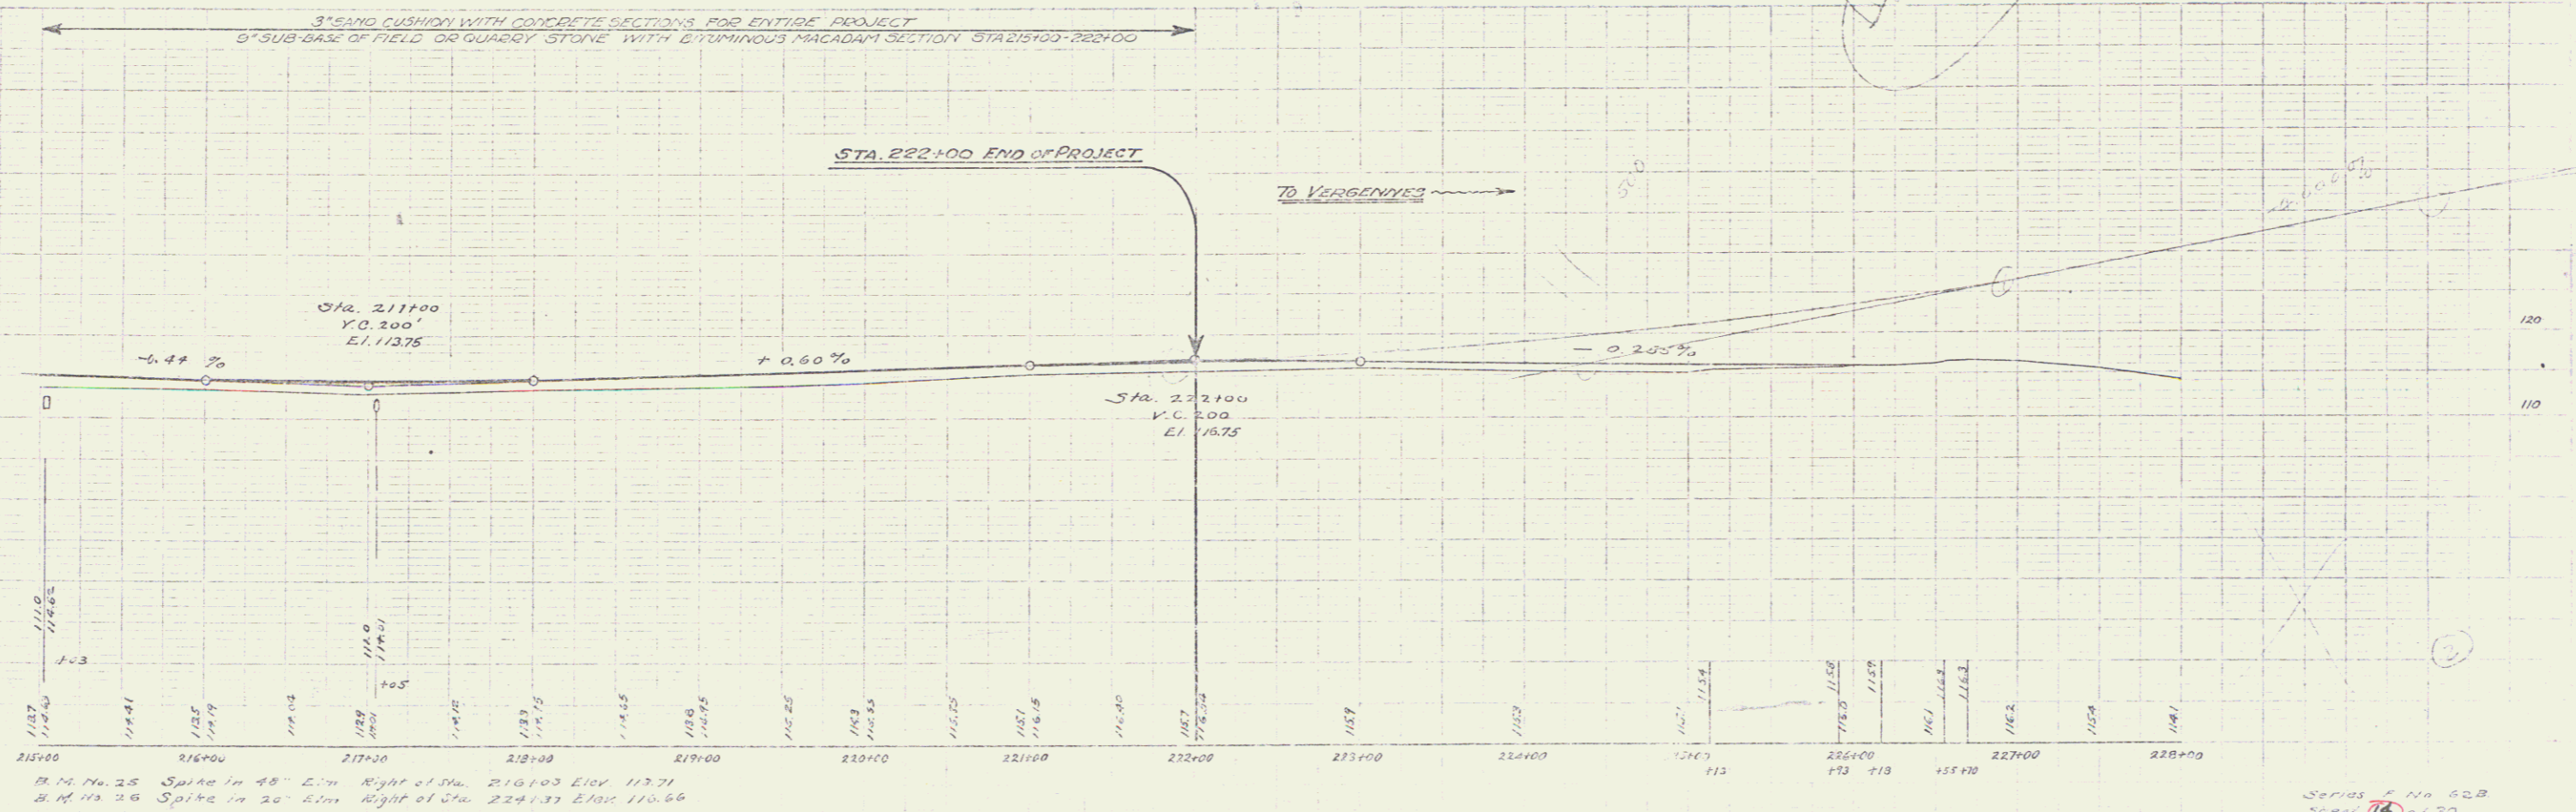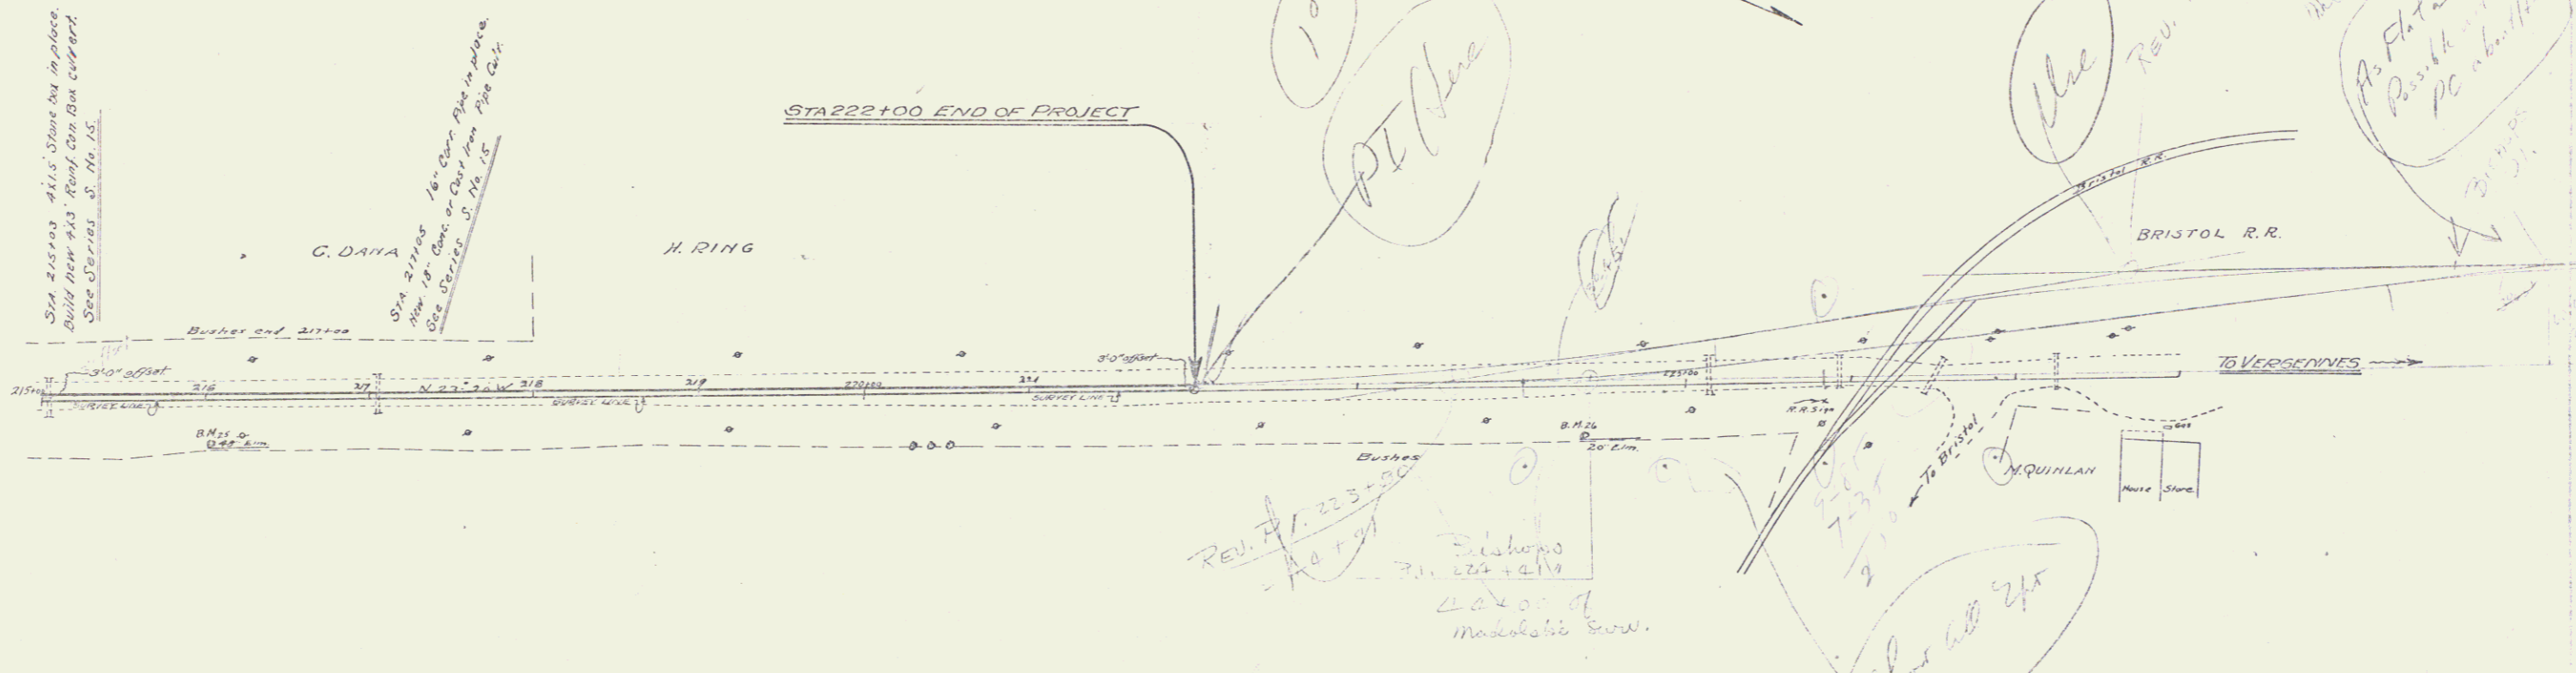

B.M. No. 25 Spike in 40' Lim Right of Sta. 216103 Elev. 117.71  
 B.M. No. 26 Spike in 20' Lim Right of Sta. 224131 Elev. 116.66

SERIES # NO. 62B  
 SHEET 16 of 30