
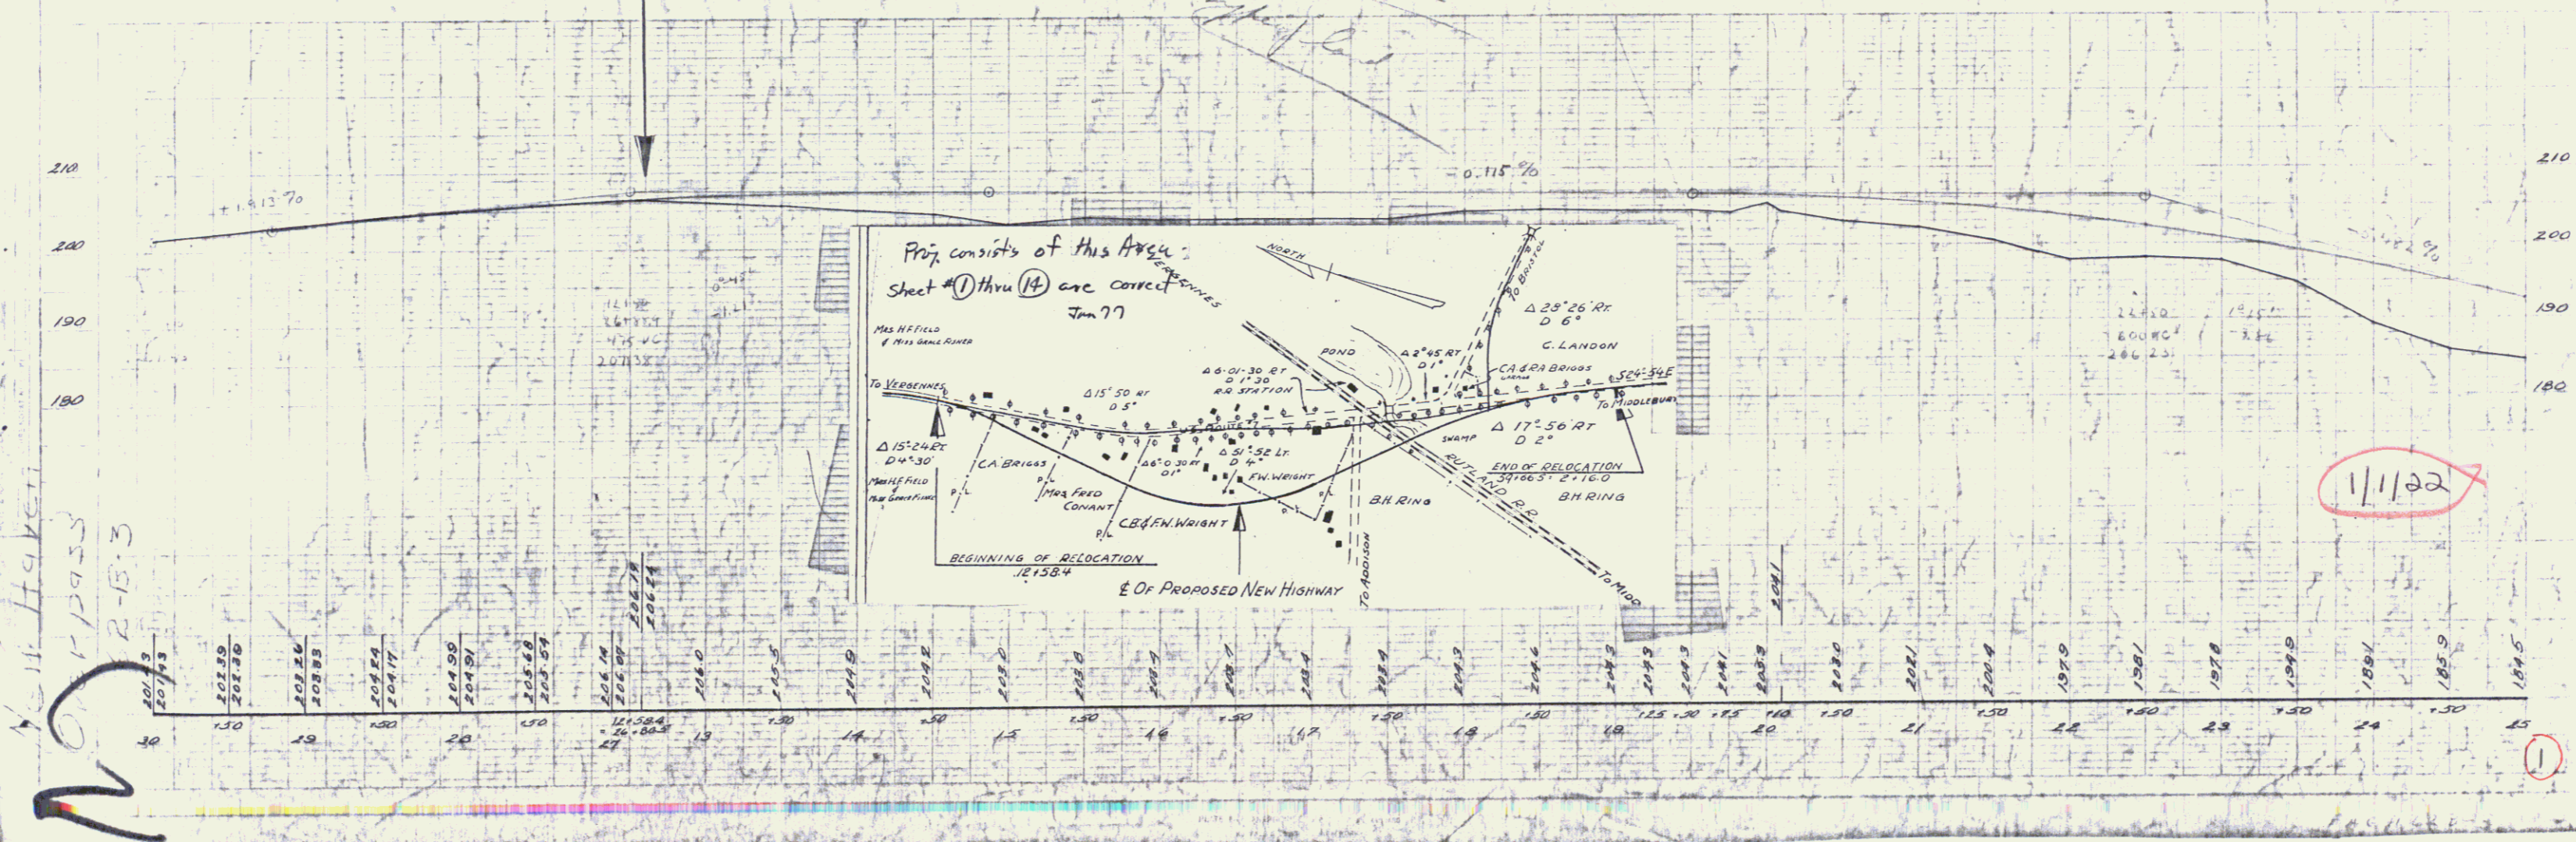


Town: NEW HAVEN
Route: US 75

Pin # 99R453

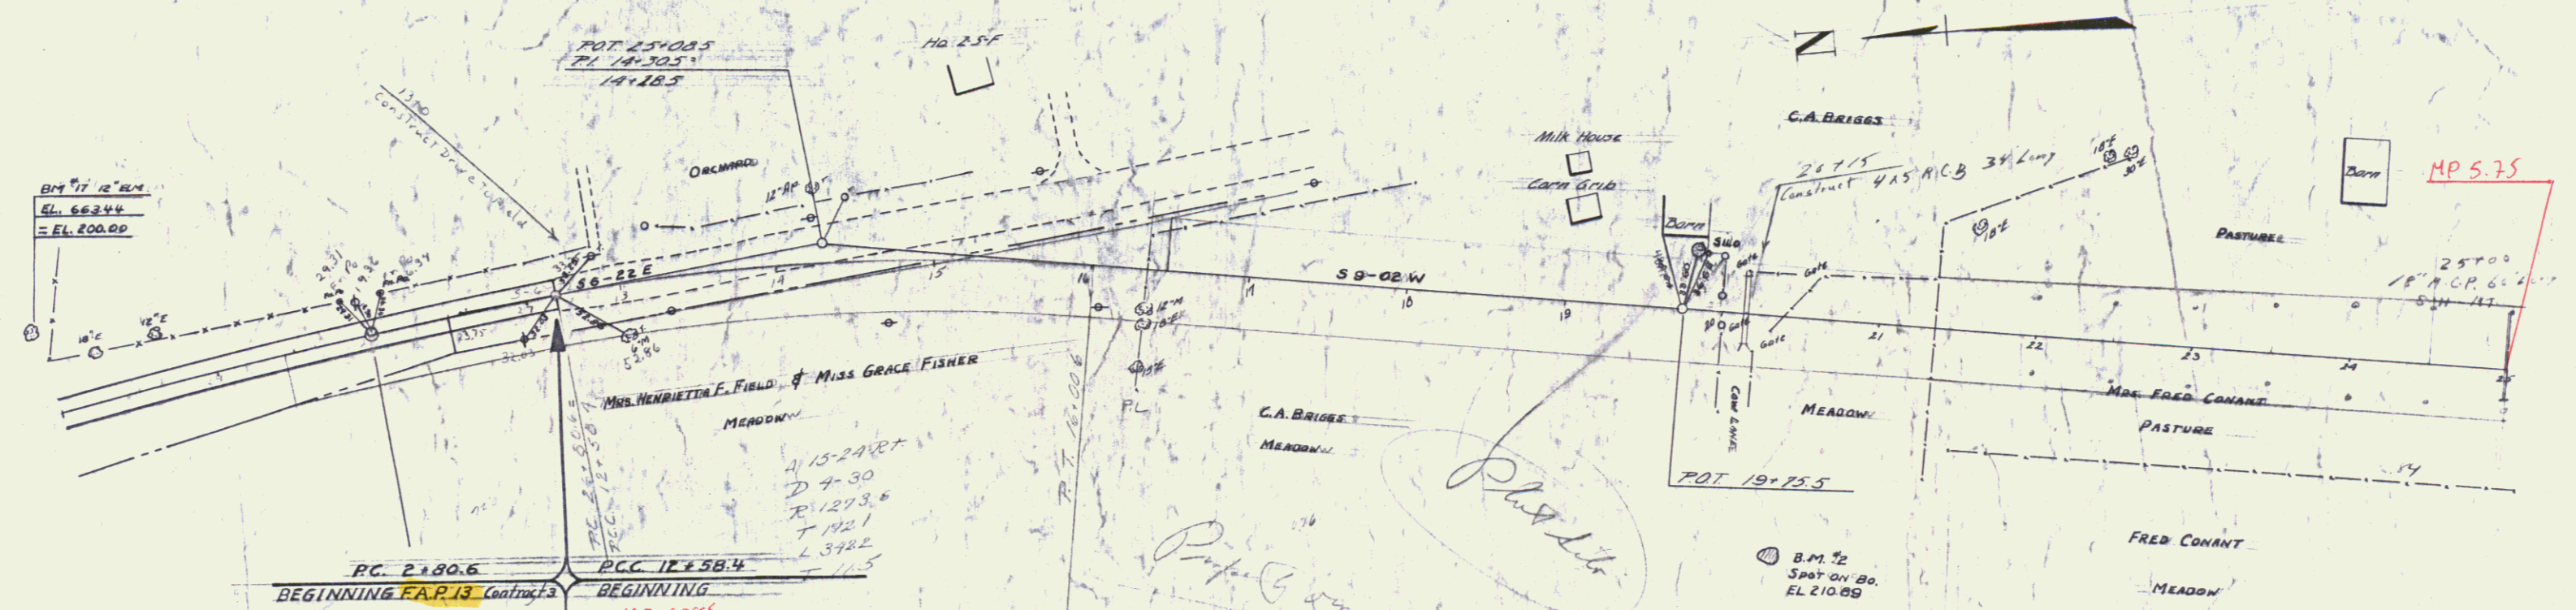

New Haven
Pin # 99R453

1/1/22

1