
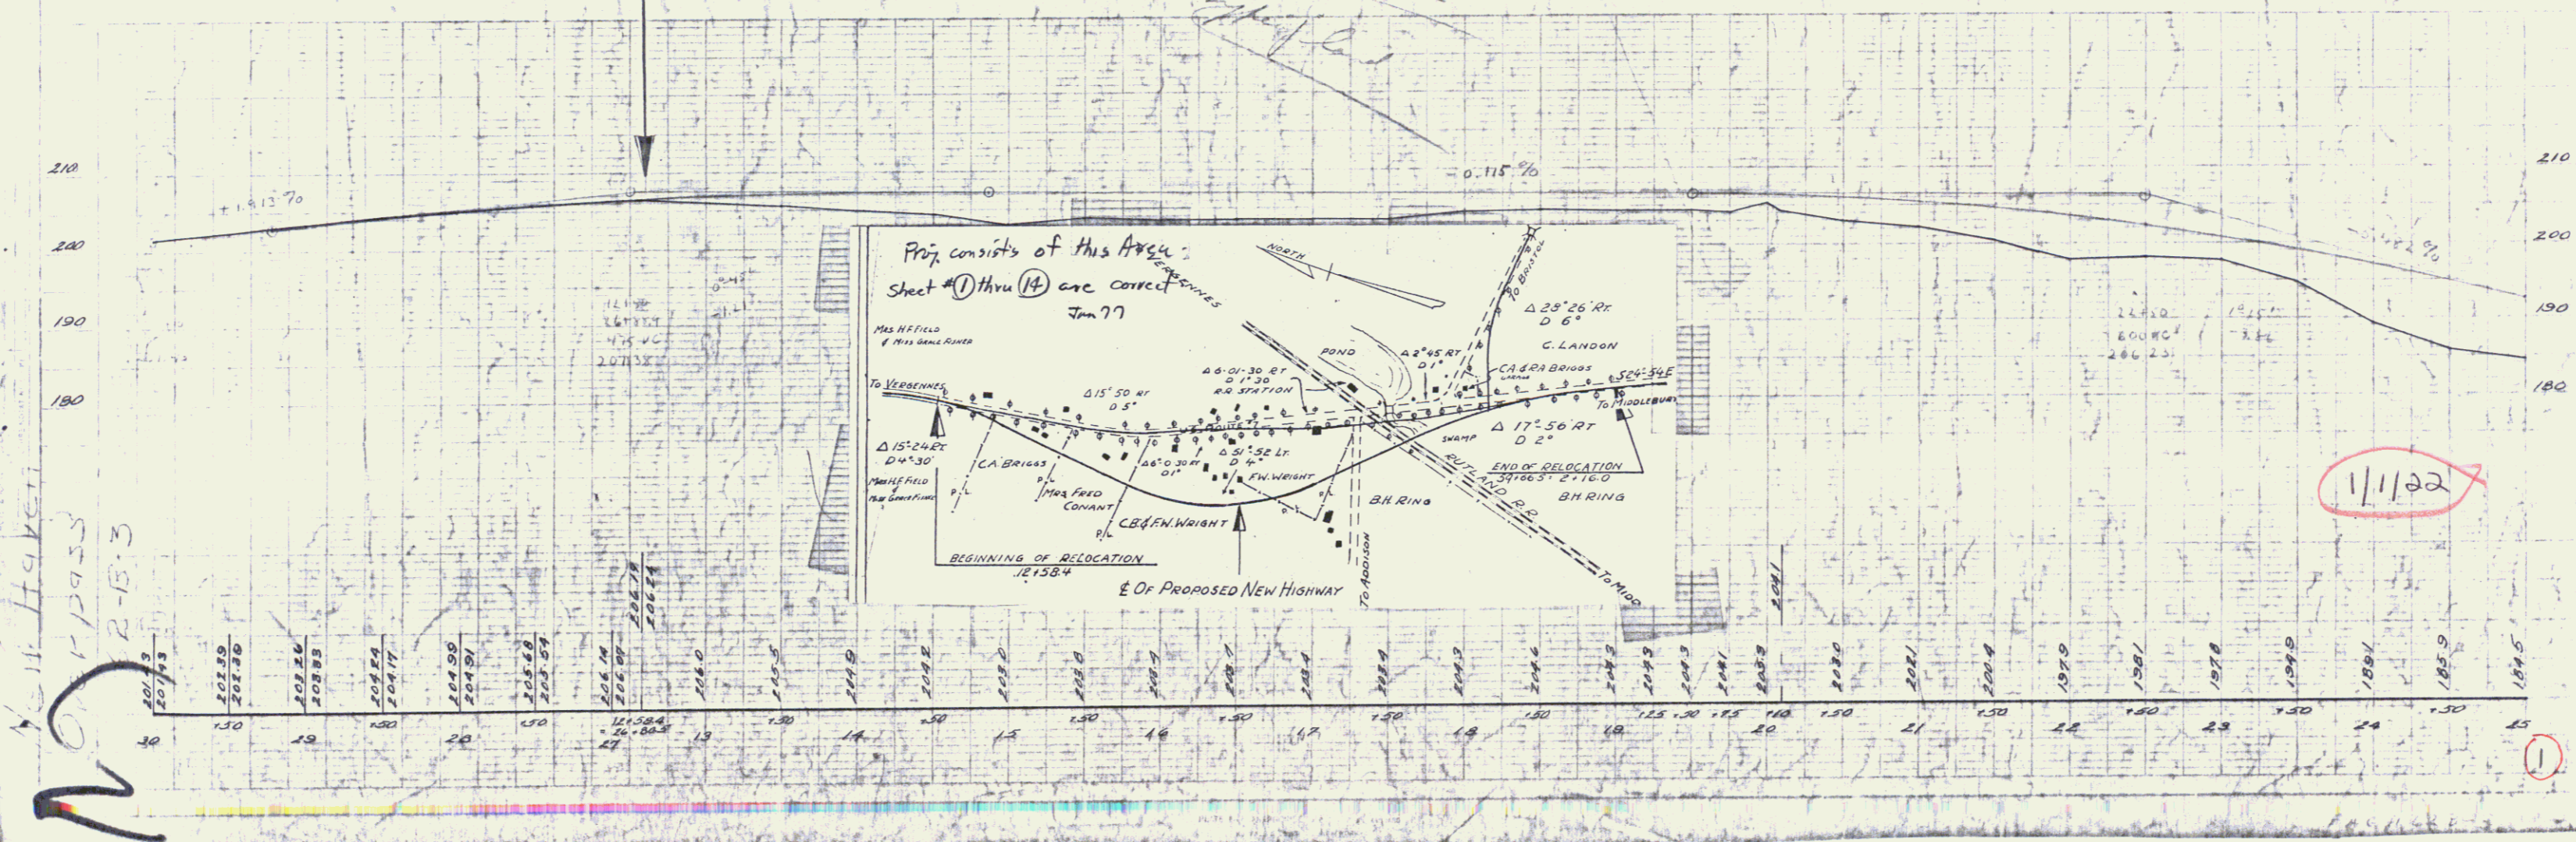


Town: NEW HAVEN
Route: US 75

Pin # 99R453

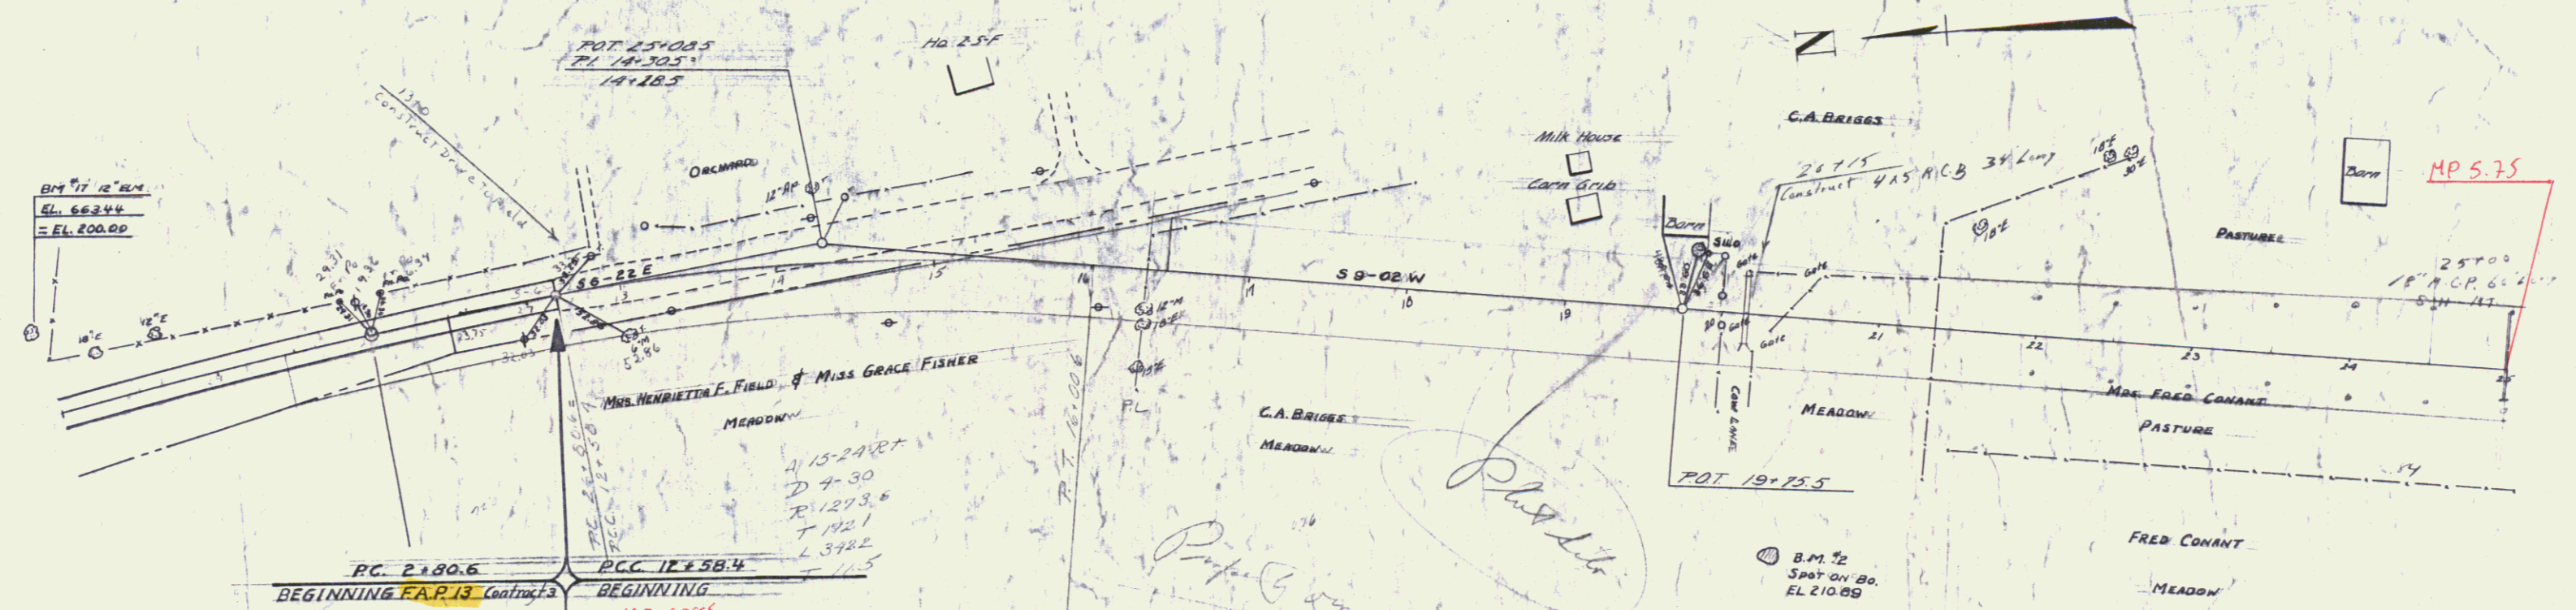

New Haven
Route 75
2-15-3

1

