

3

Survey
Date 10/10/10
Page 35



Map
Scale
Feet

Notes

10/10/10

10/10/10

10/10/10

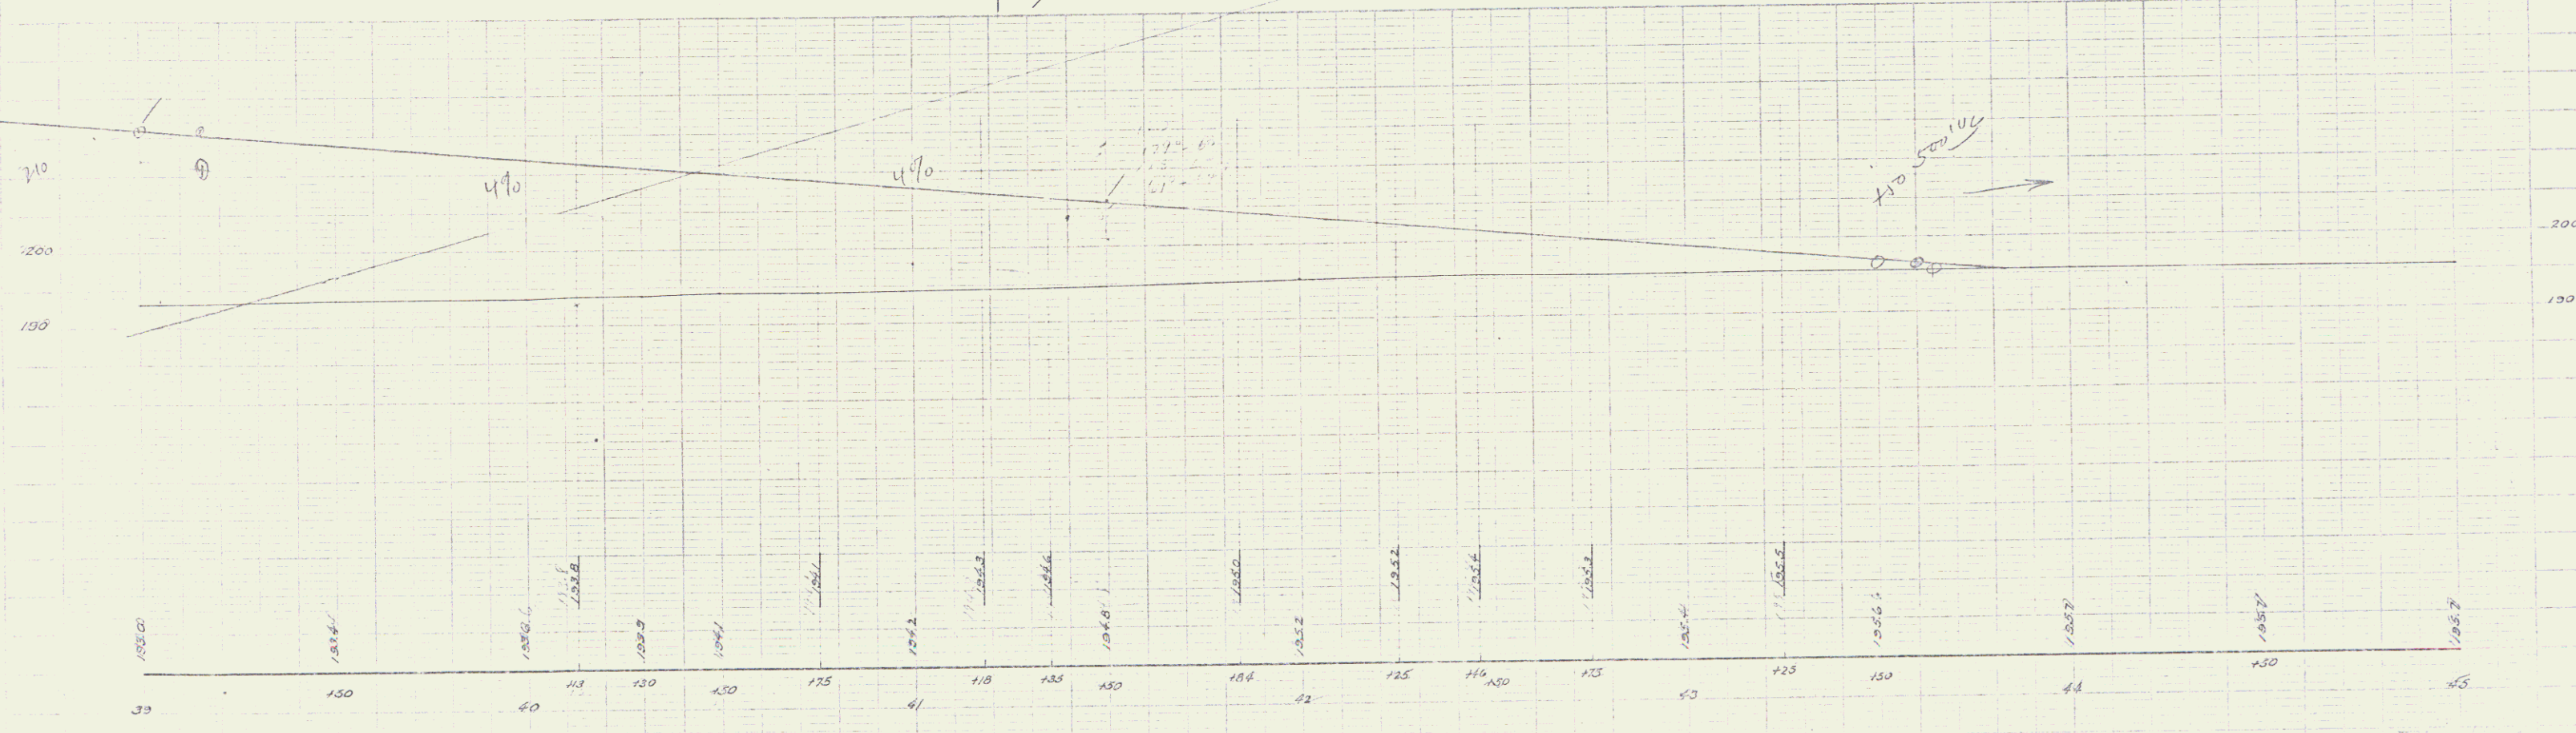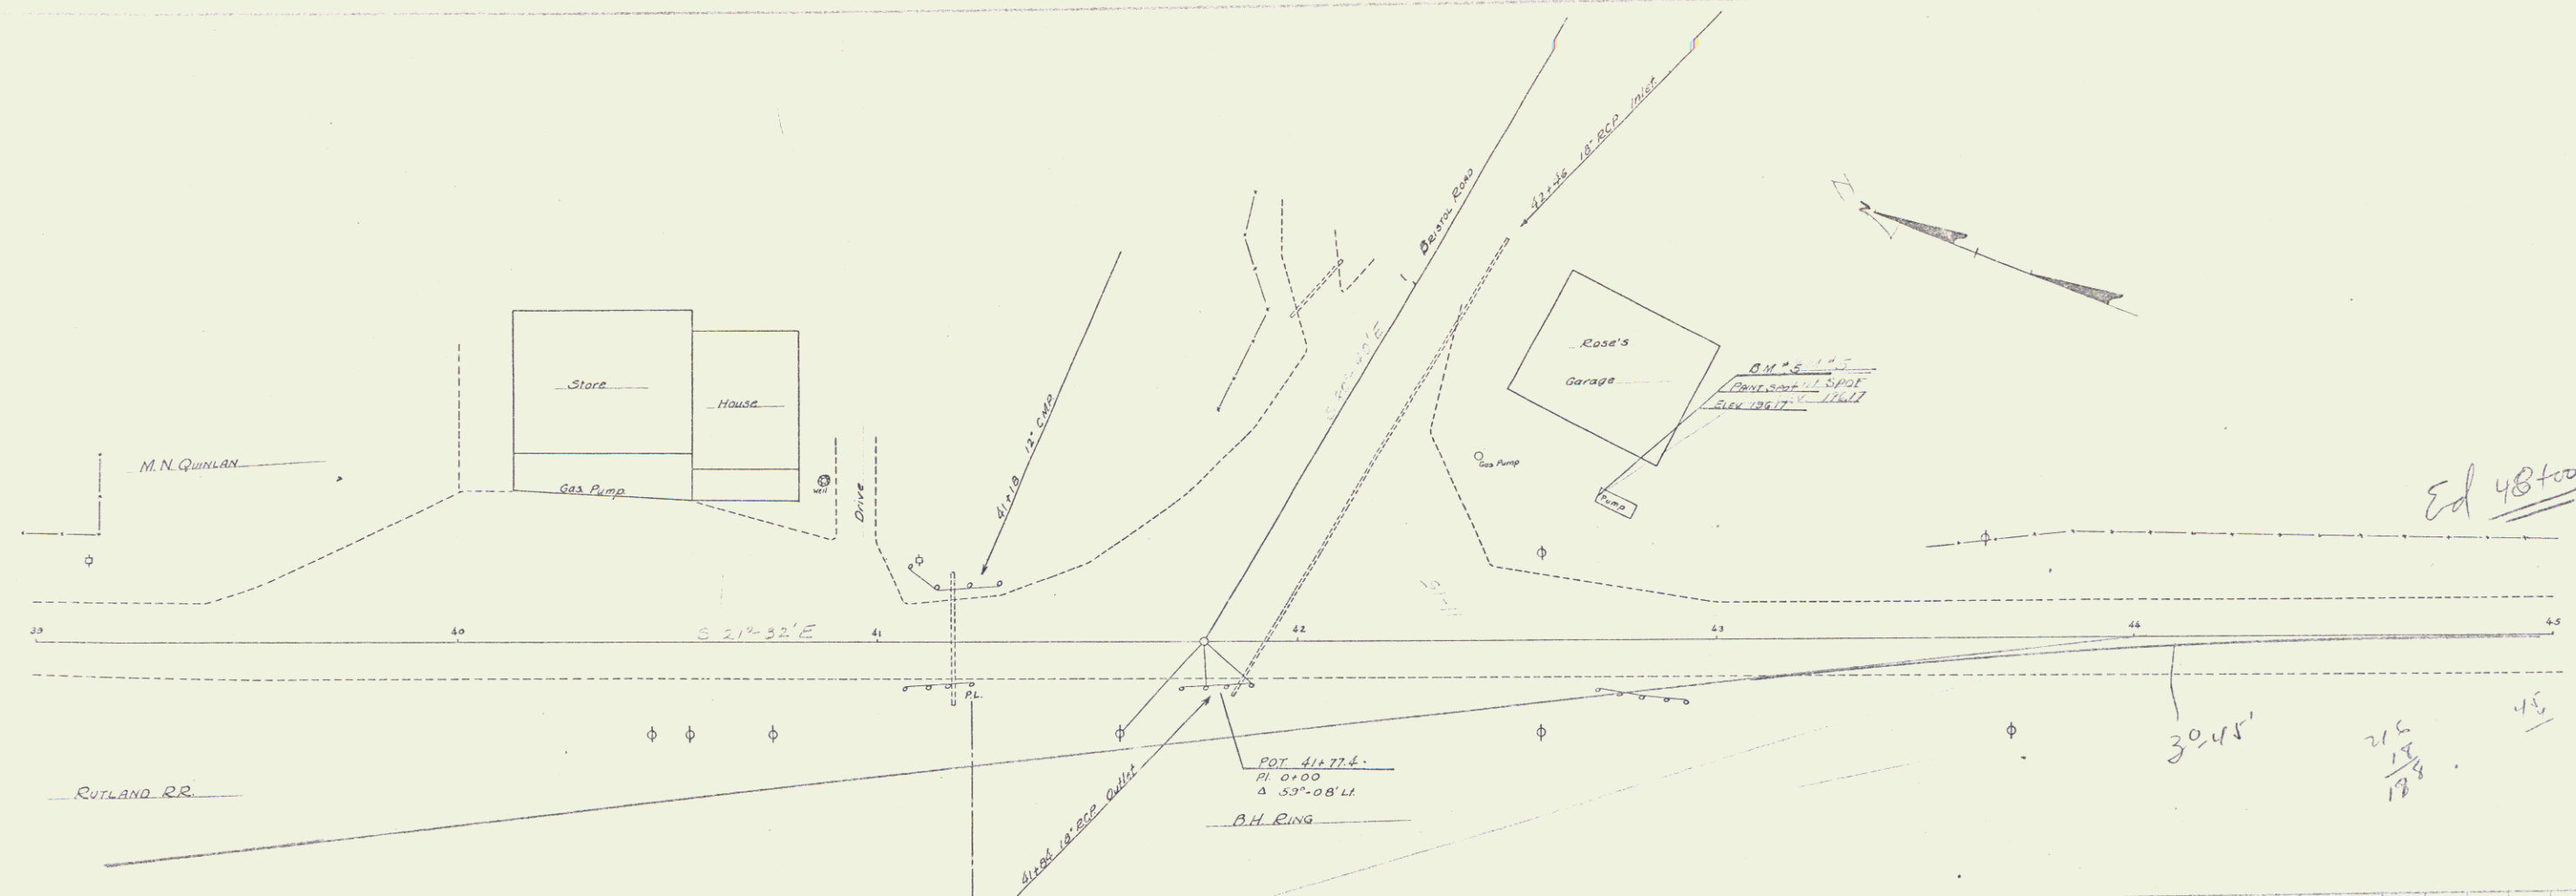

B.M. 3 PAINT SPOT ON GAS PUMP FDT. 33 FT LT STA 42+71 ELEV. 196.17

7

19