
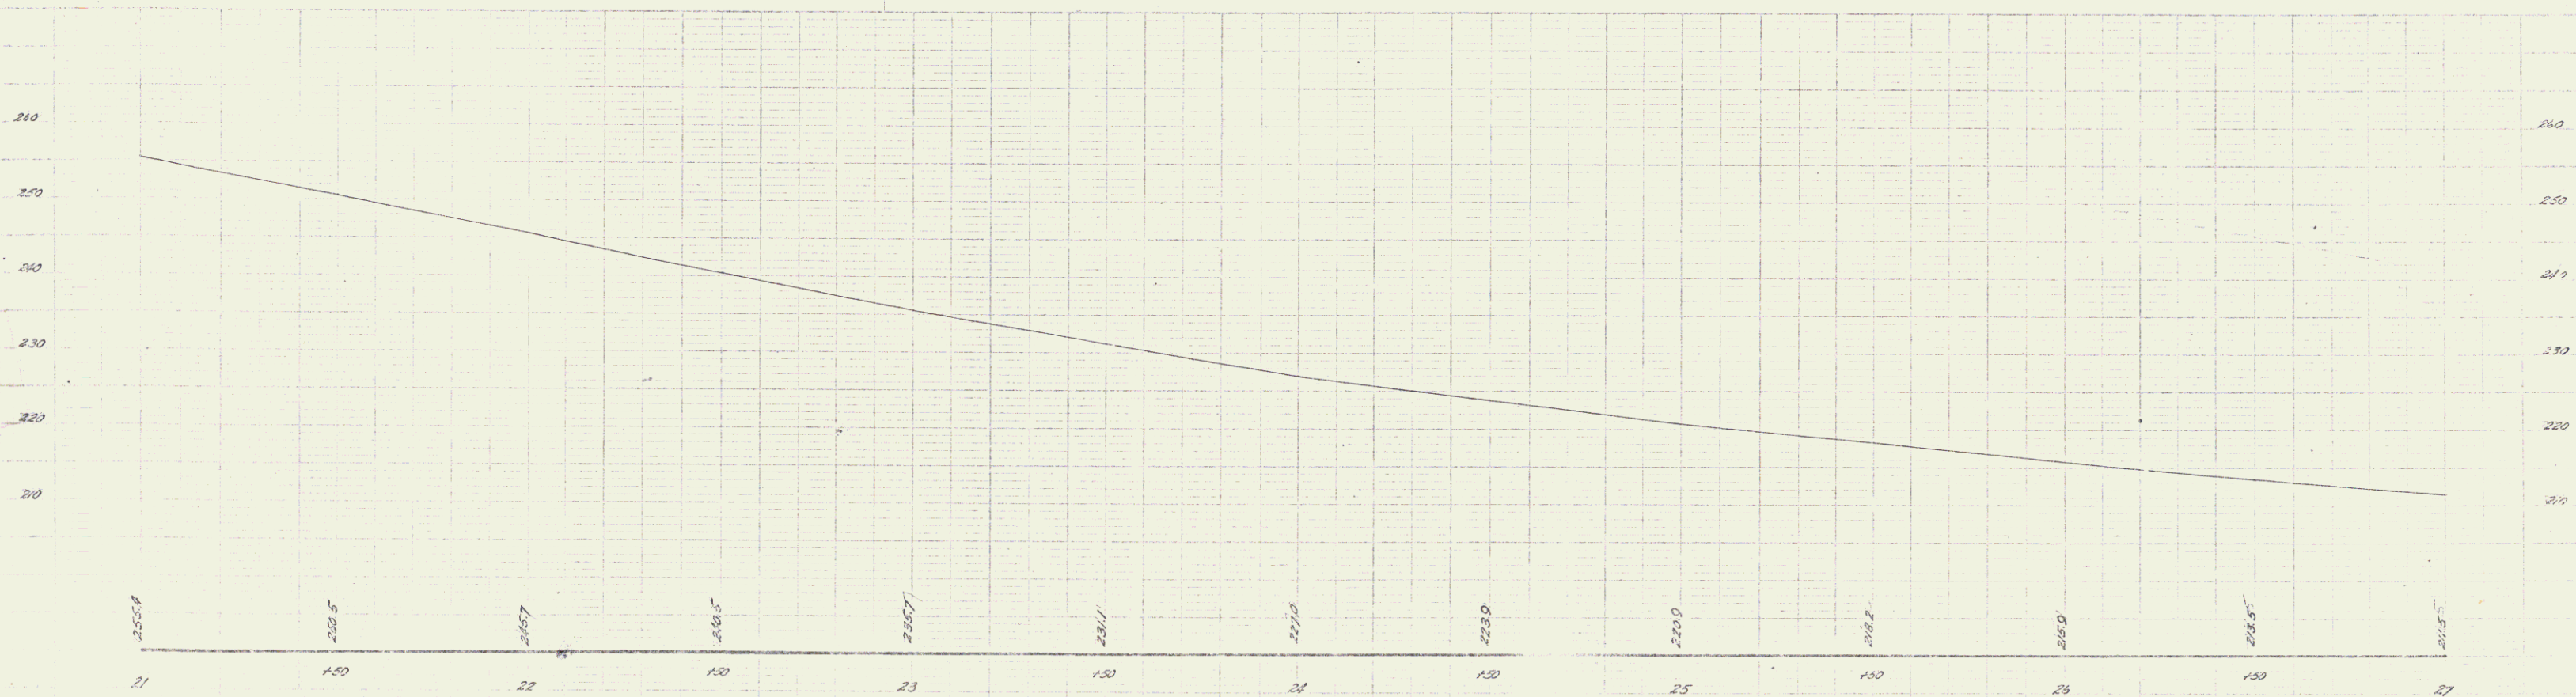


Map No. 100
 Date 10/10/55
 Project
 Sheet 1 of 1

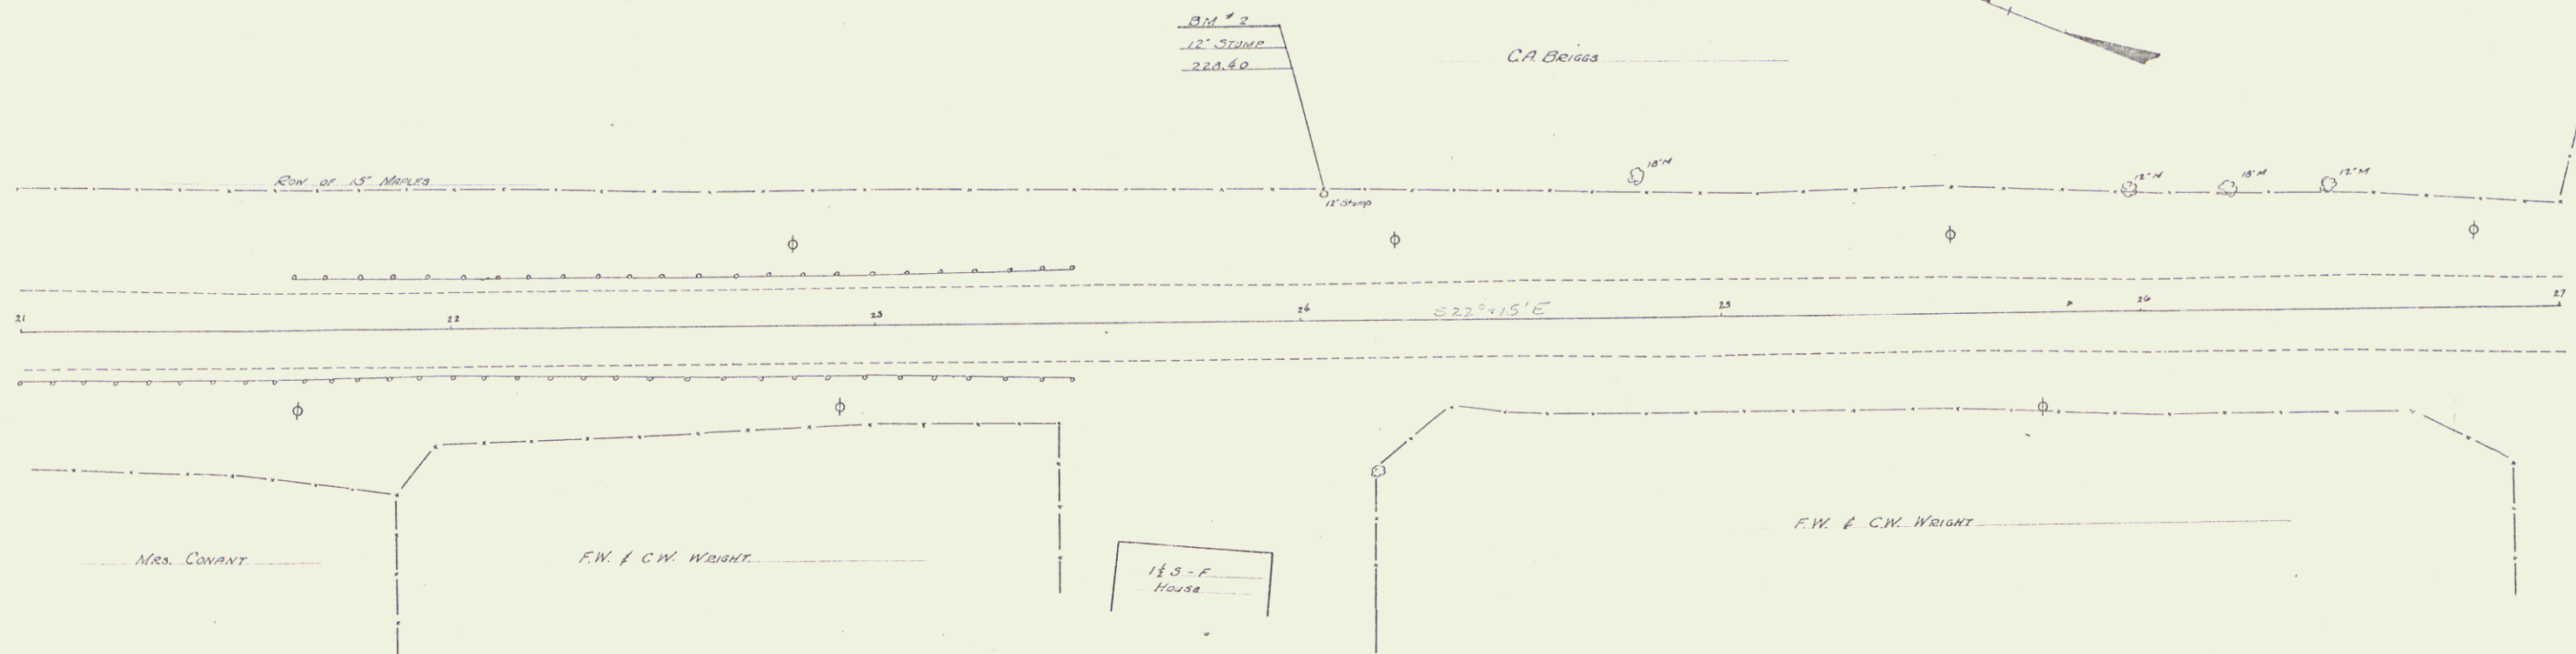

BM #2 SPIKE IN STUMP 30 FT LT STA 24+06 ELEV. 228.40

How High
 100 Feet
 80
 25