

(To Be Returned To R.O.W. Division)


TOWN OF US 7

PERPETUAL

RIGHT-OF-WAY DIVISION

MP 5.27 - 5.48

BENCH MARK #2 - Eln tree left of Sta 8100 - El 101.6

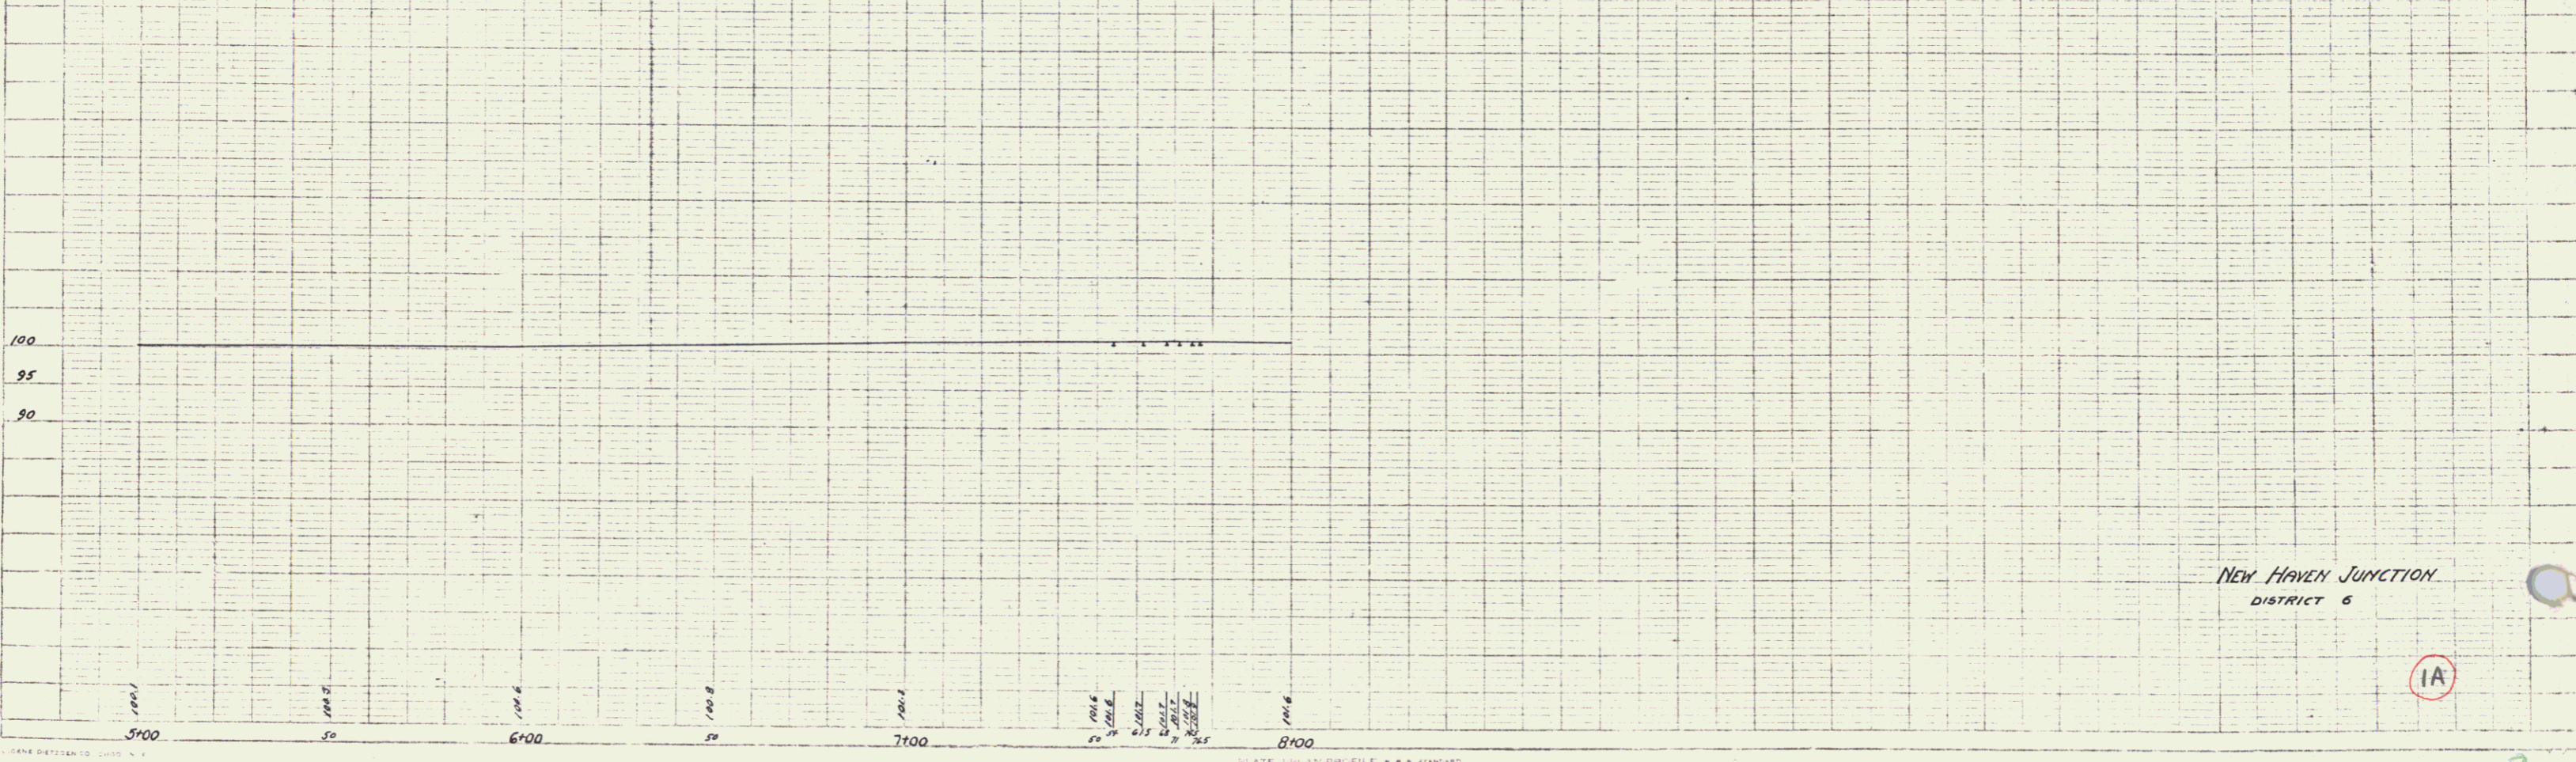

NEW HAVEN JUNCTION
DISTRICT 6

IA

2

PLAN
NOTE BOOK
NO.

PLAN
NOTE BOOK
NO.