
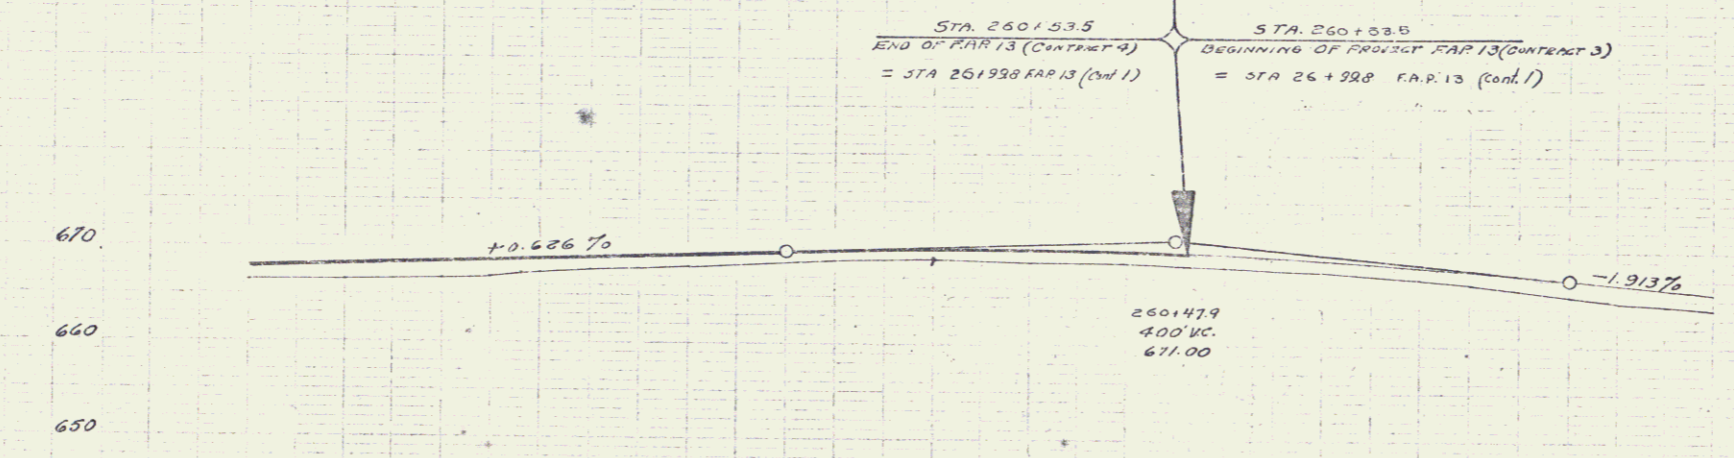


275

R.M. Canale
R.M. Staudom

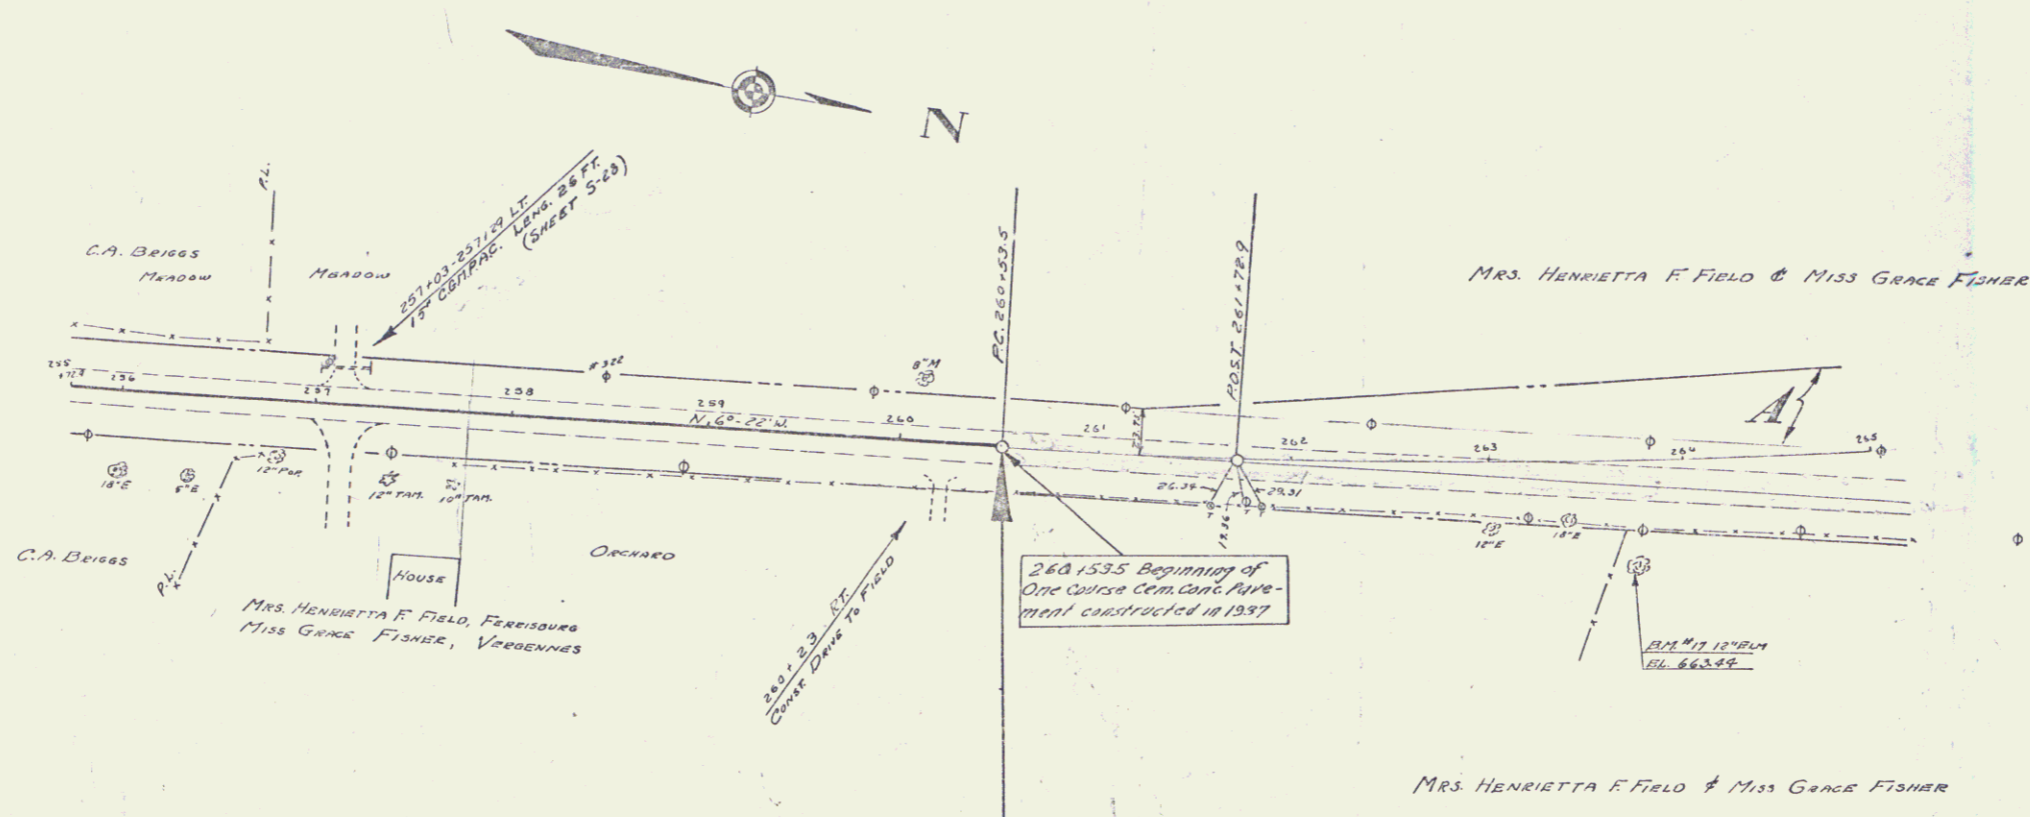

Sta.	Elev.	Sta.	Elev.	Sta.	Elev.	Sta.	Elev.
256	666.9	260	668.77	264	669.27	268	669.75
257	666.6	261	668.5	265	669.0	269	669.5
258	666.34	262	668.27	266	668.75	270	669.2
259	666.1	263	668.0	267	668.5	271	669.0
260	665.85	264	667.75	268	668.25	272	668.75
261	665.6	265	667.5	269	668.0	273	668.5
403	630.1	407	632.0	411	632.5	415	633.0
404	629.85	408	631.75</				