


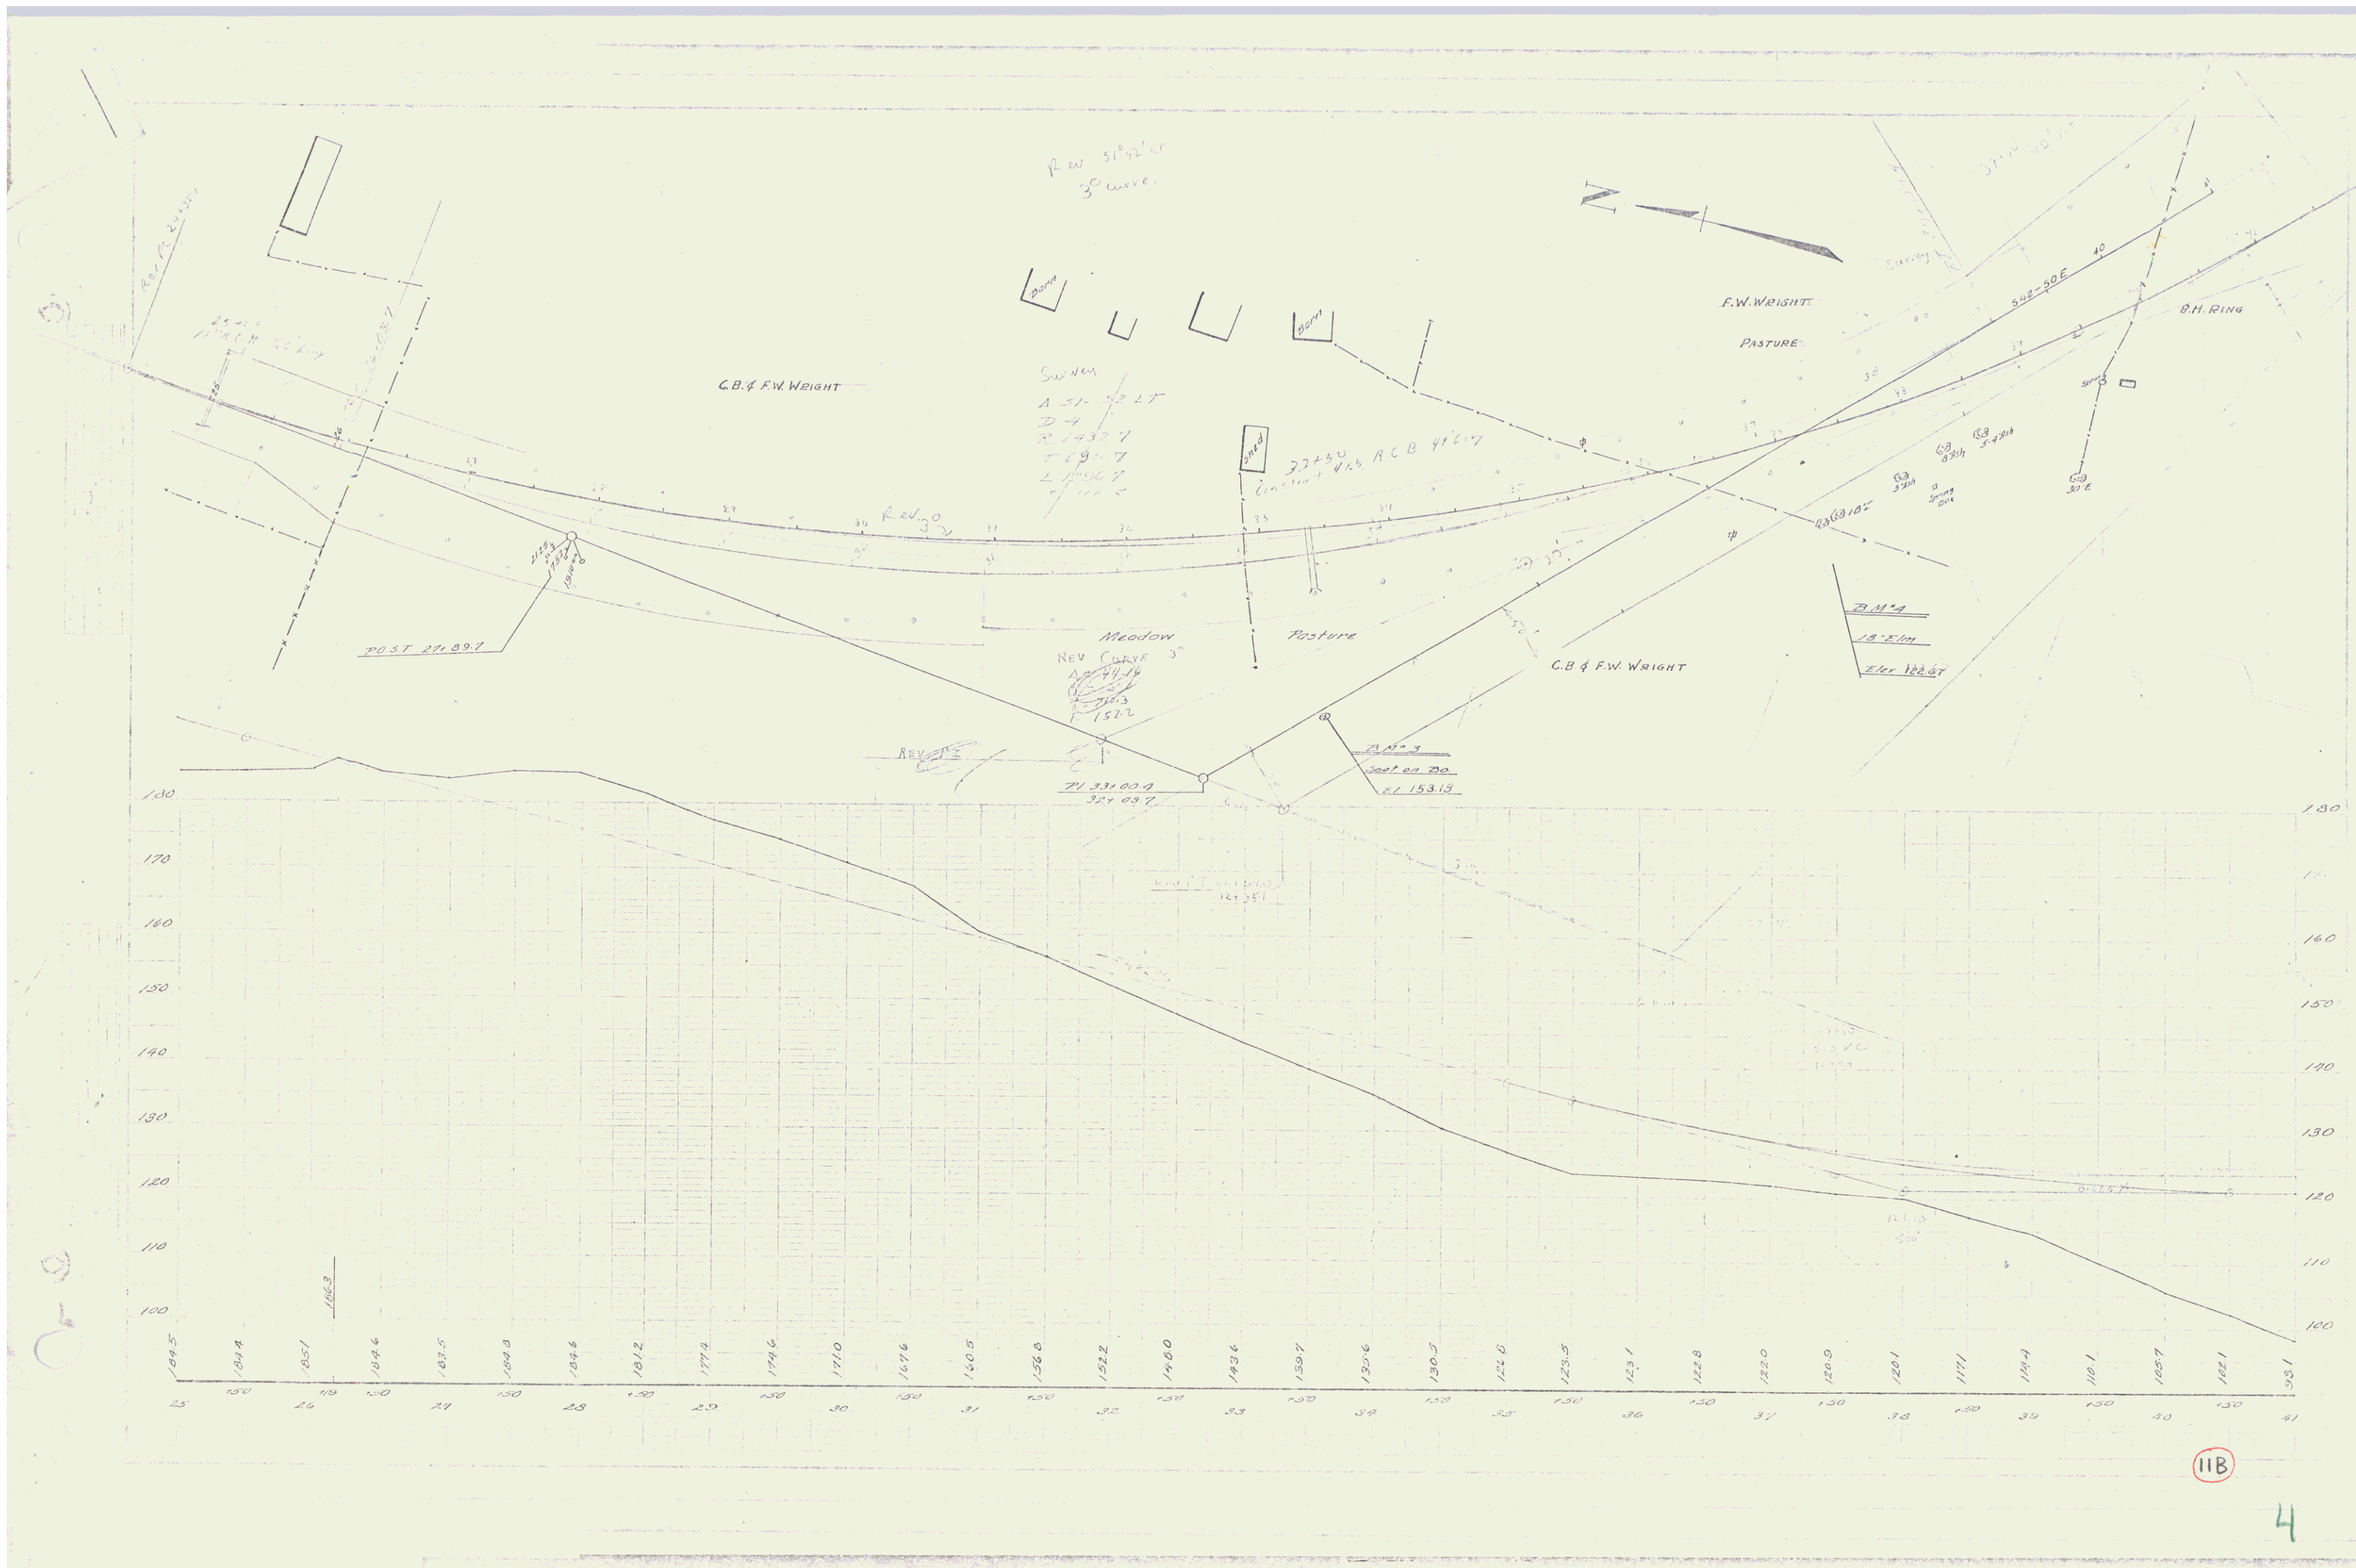

11B