


STA 55+71
 12'x46' CONCRETE BOX
 REPLACE WITH 100' DIA 18\"/>

PARCEL	INSTRUMENT	DATE	GRANTOR	GRANTEE	RECORDED BOOK	RECORDED PAGE	RECORDED DATE	REMARKS
A	O.C.D.	7-26-37	NICHOLAS & E. BEGNOLE	STATE	24	66	7-30-37	CUL 810
A'	O.C.D.	7-26-37	H. PAQUETTE & A. LAMBERT	"	24	66	8-13-37	

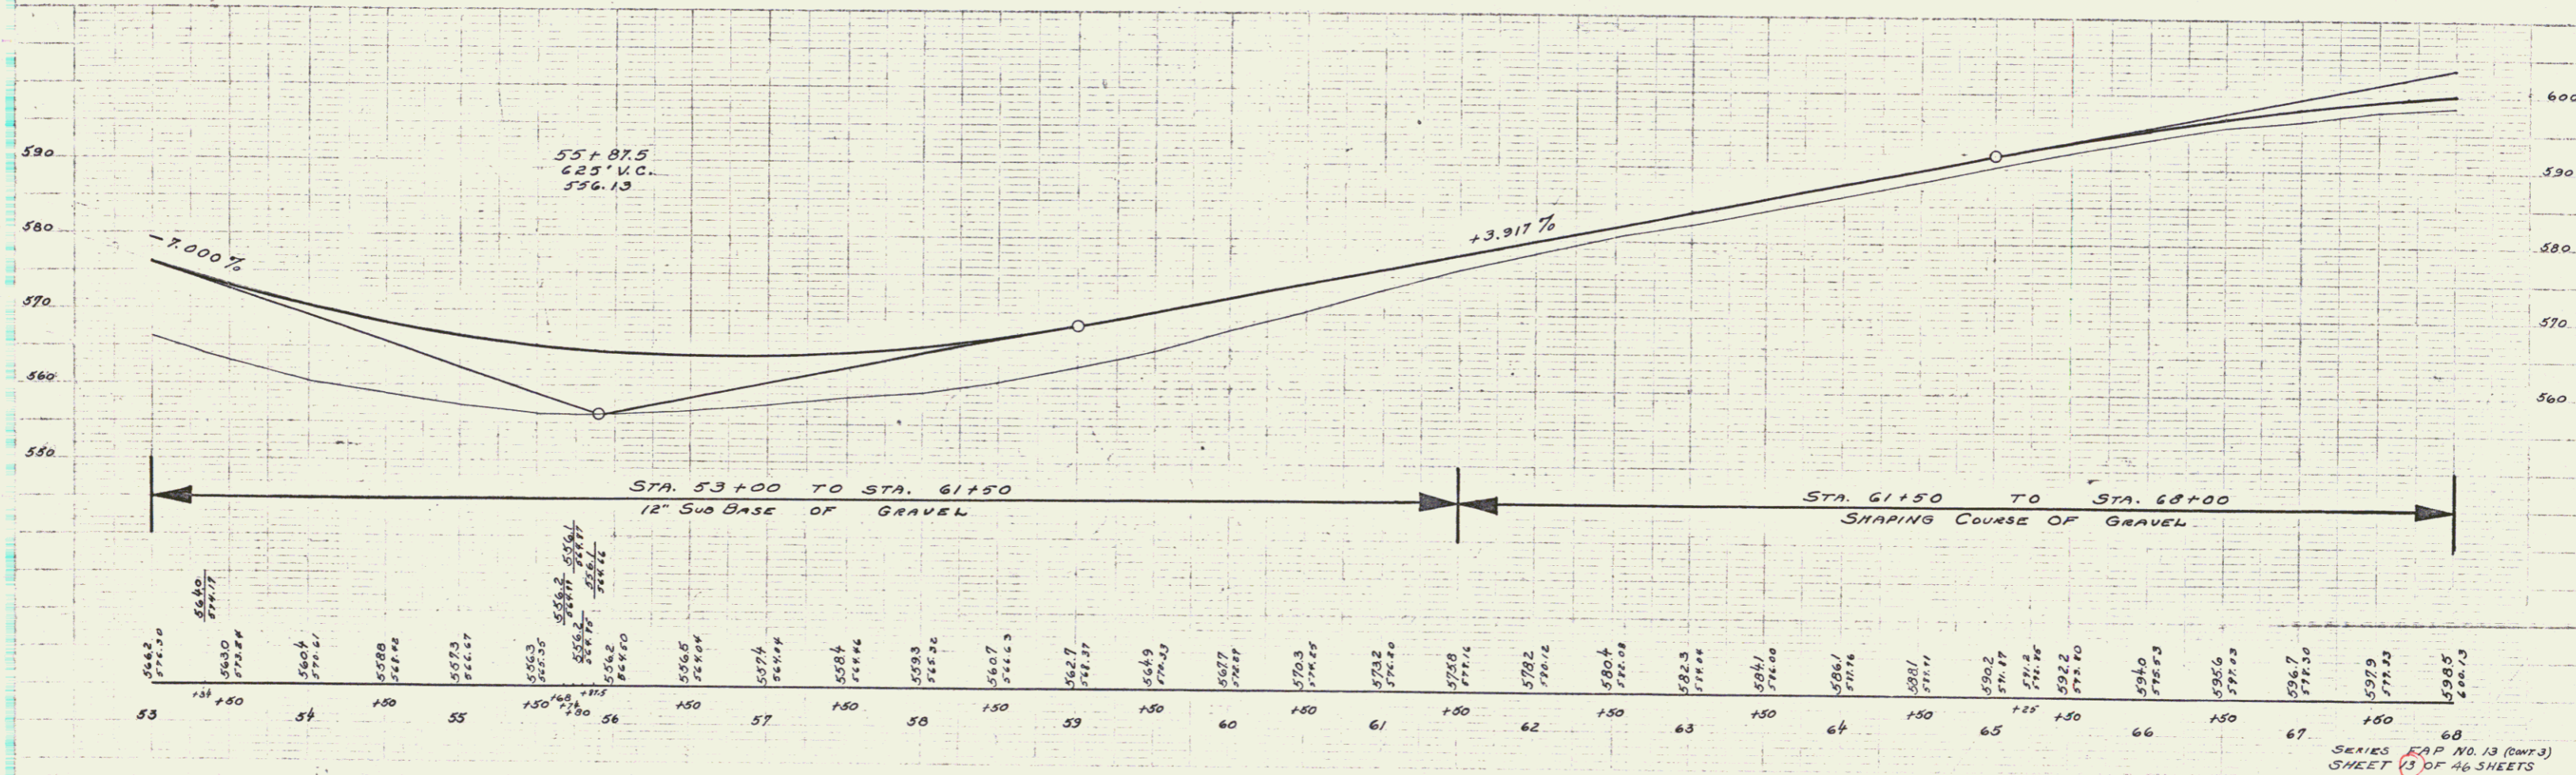

6