
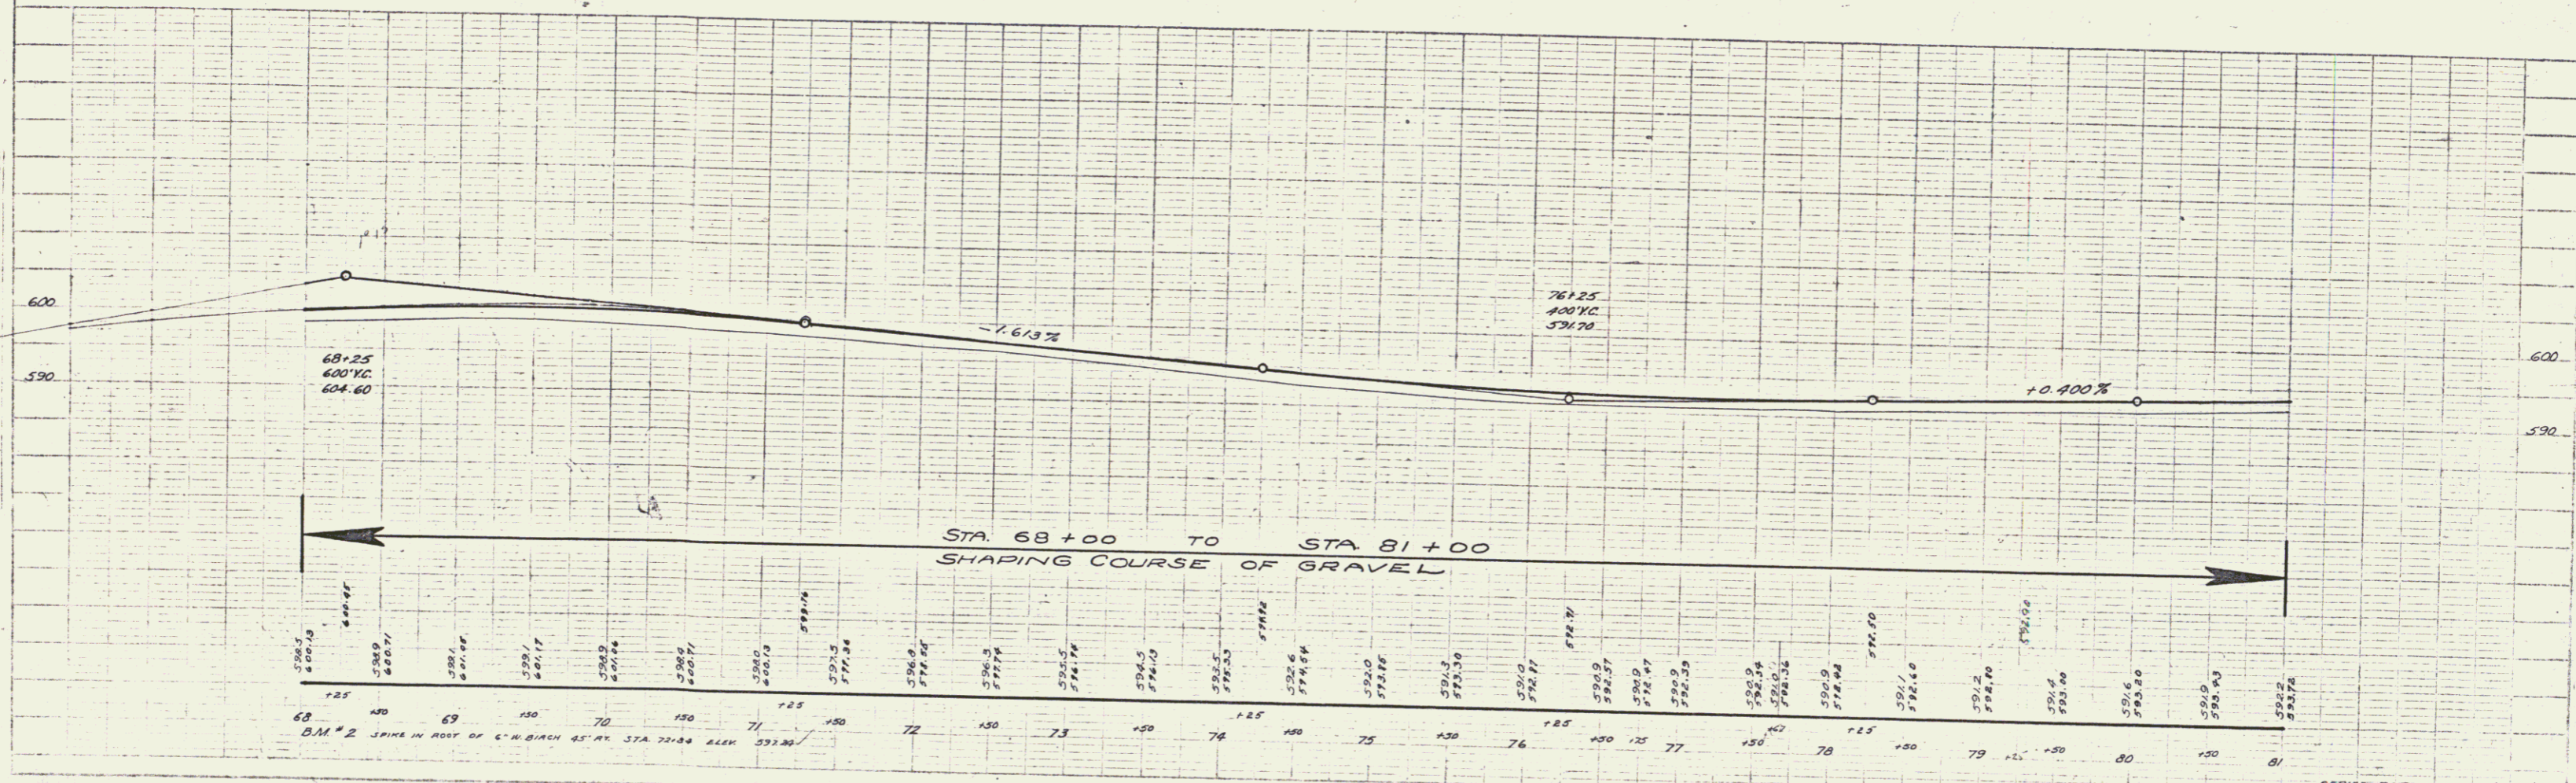


5/11/18
 0.4
 5/11/18
 0.4

5/11/18
 0.4
 5/11/18
 0.4

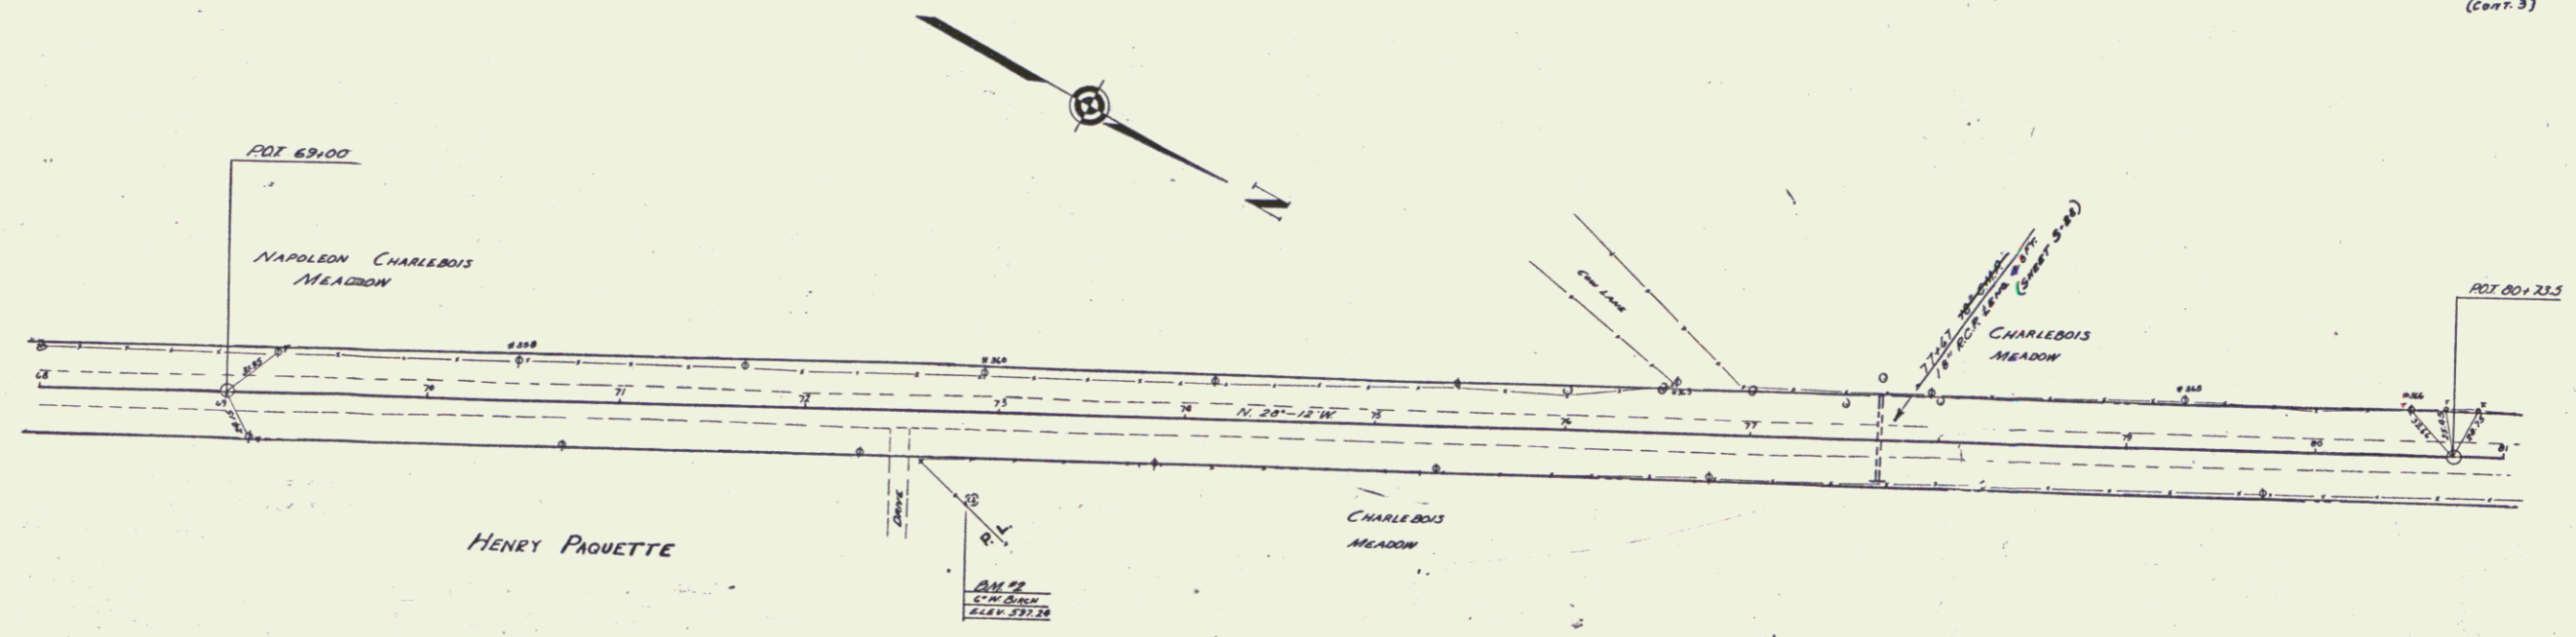

7