


DATE  
SCALE

DATE  
SCALE

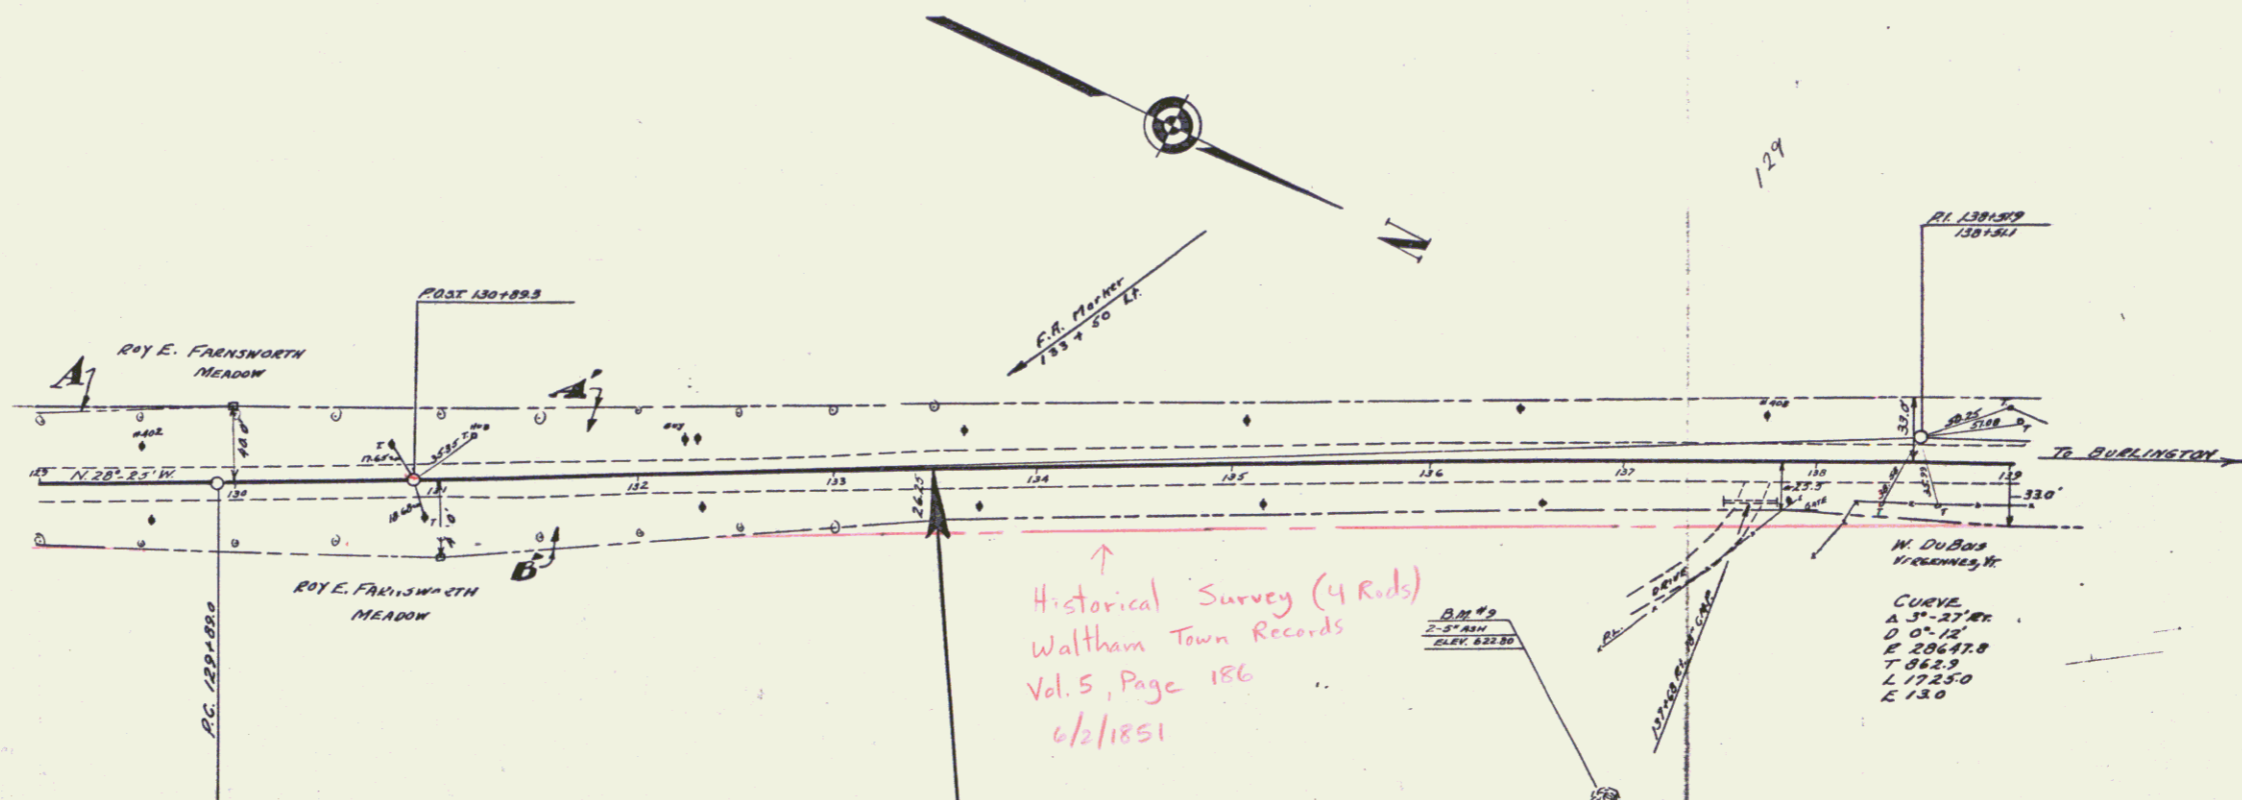

↑  
Historical Survey (4 Rods)  
Waltham Town Records  
Vol. 5, Page 186  
6/2/1851

CURVE  
A 3'-27" R  
D 0'-15"  
M 20647.0  
T 822.3  
L 1725.0  
C 12.0

PARCEL	INSTRUMENT	DATE	GRANTOR	GRANTEE	RECORDED	REMARKS
A	G.C.D.	7-26-37	ROY E. FARNSWORTH		WALTHAM BOOK PAGE DATE 136 7-31-37	

STA. 133+50 END F.R. PROJECT 13 (CONT. 3)  
STA. 133+50 BEGIN F.R. PROJECT 13 (CONT. 4)  
F.R. PROJECT 13 (1952)

