



PLAN
 L.A.M.
 1/2" = 100'

PLAN
 L.A.M.
 1/2" = 100'

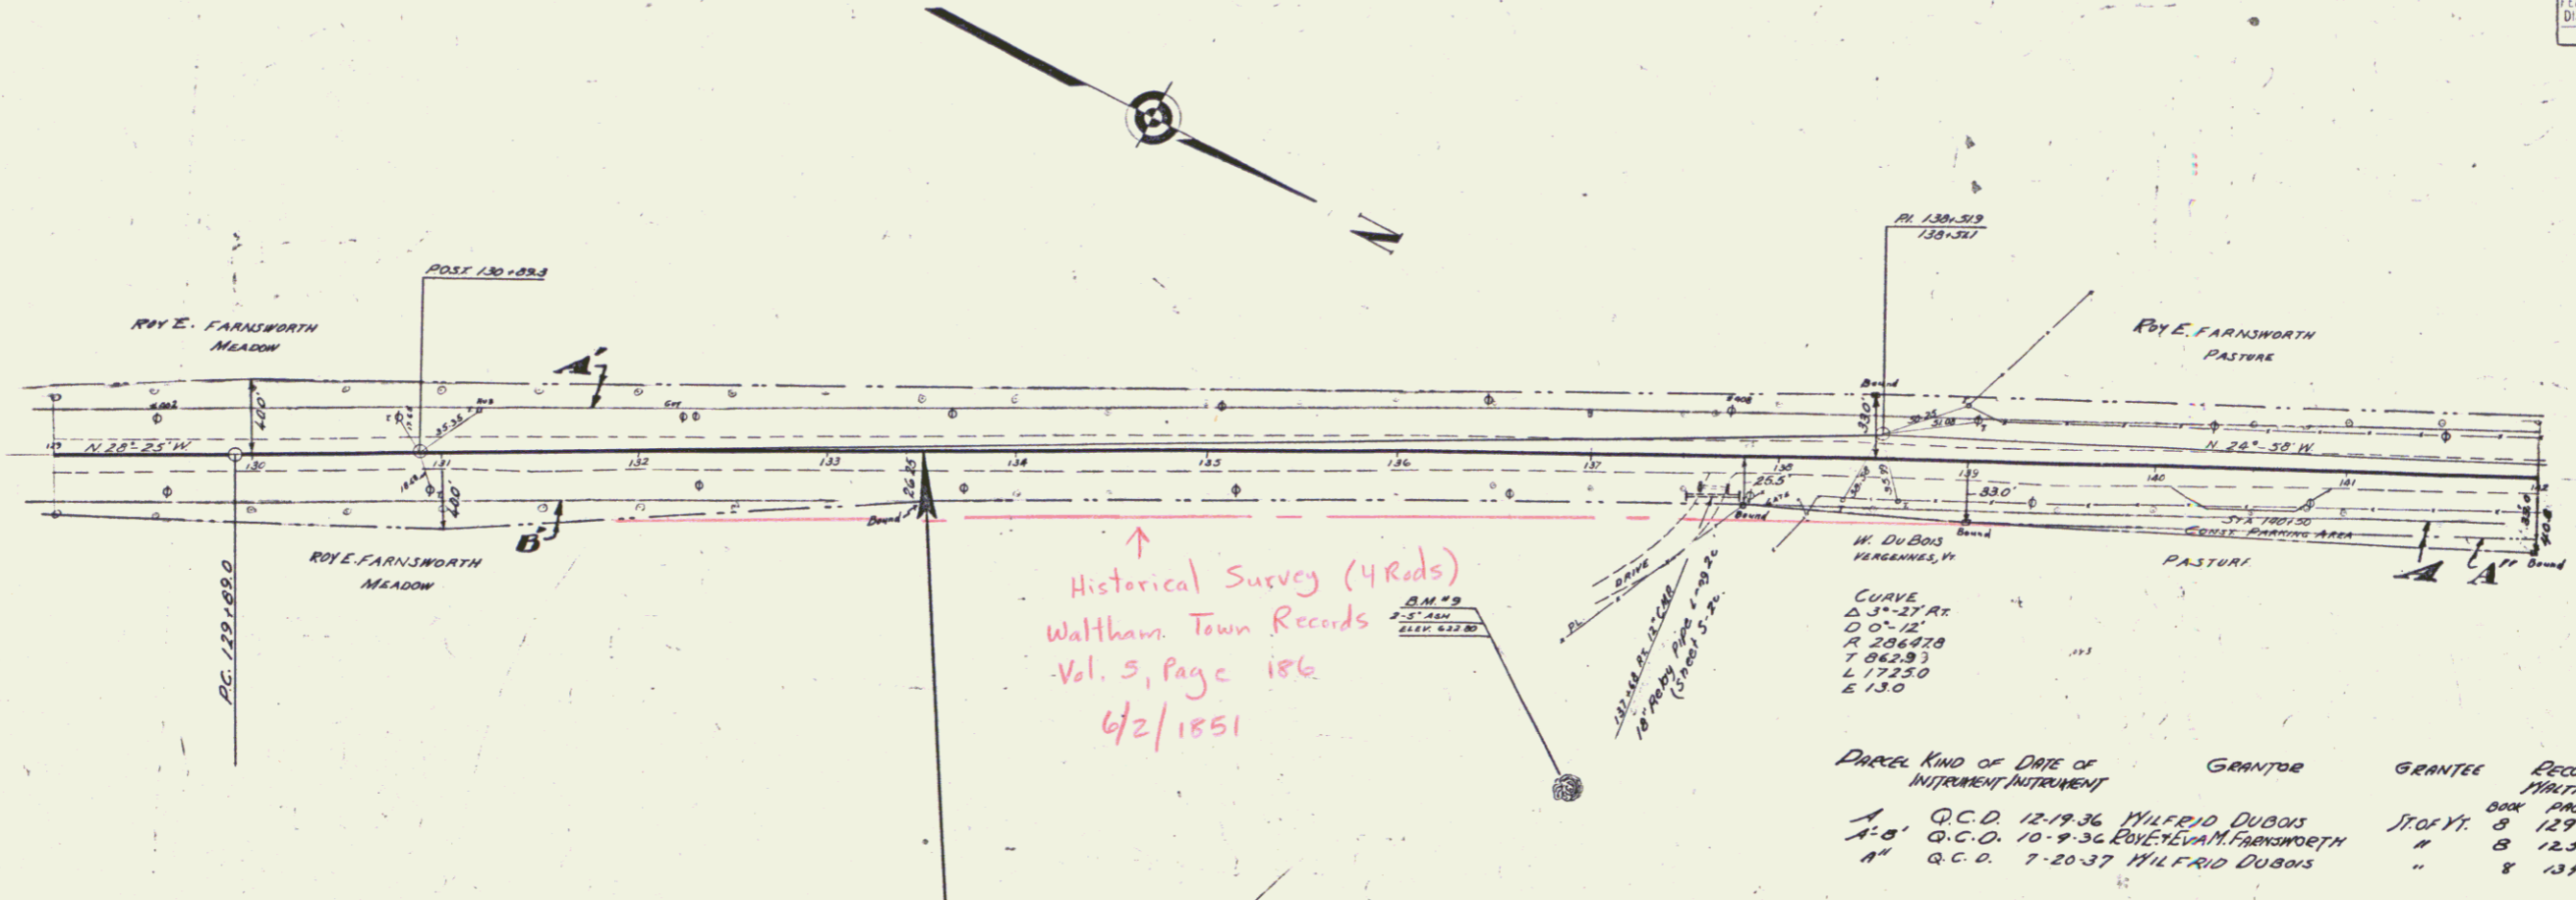

↑
 Historical Survey (4 Rds)
 Waltham Town Records
 Vol. 5, Page 186
 6/2/1851

Parcel	Kind of Instrument	Date	Grantor	Grantee	Recorded	Remarks
A	Q.C.D.	12-19-36	MILFRID DUBOIS	ST. OF VT.	8	129
A-B	Q.C.D.	10-9-36	ROY E. FARNSWORTH	"	8	125
A'	Q.C.D.	7-20-37	MILFRID DUBOIS	"	8	134

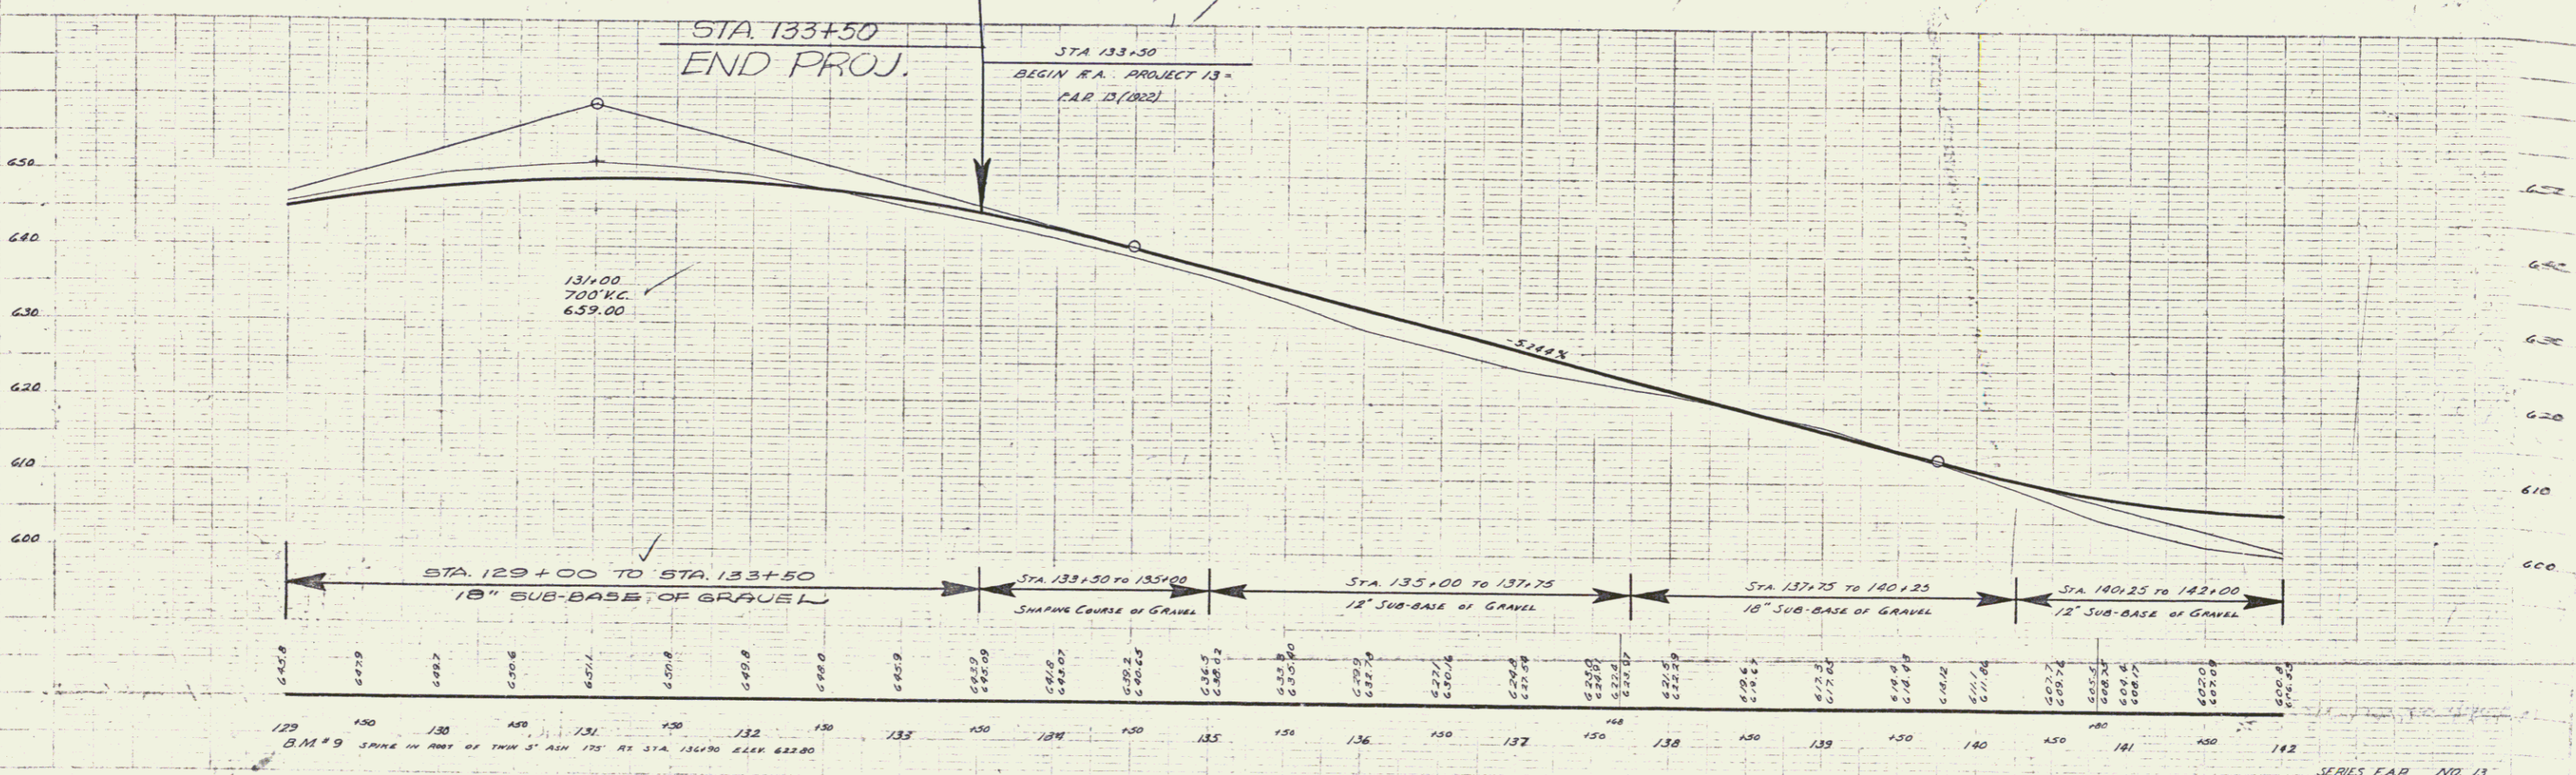

SERIES F.A.R. NO. 13
 SHEET 2 of 36 SHEETS