


PARCEL	KIND OF INSTRUMENT	DATE	GENITOR	GENTEE	RECORDED	REMARKS
A	O.C.D.	12-19-36	WILFRID DUBOIS	STOYER	BOOK PAGE DATE	128 128-37
A-B	O.C.D.	10-9-36	FOYE-LEWIS-FARNSWORTH	"	125 10-17-36	
A-C	O.C.D.	10-9-36	LEON A. LANGWAY	"	123 10-17-36	
A-D	O.C.D.	10-9-36	J. H. BURROUGHS	"	123 10-17-36	
A-E	O.C.D.	7-20-37	WILFRID DUBOIS	"	134 7-27-37	
A-F	W.D.	8-17-37	LEON A. LANGWAY	"	134 6-28-37	

Historical Survey (4 rods)  
 Watham Town Records  
 Vol. 5, Page 186  
 6/2/1851

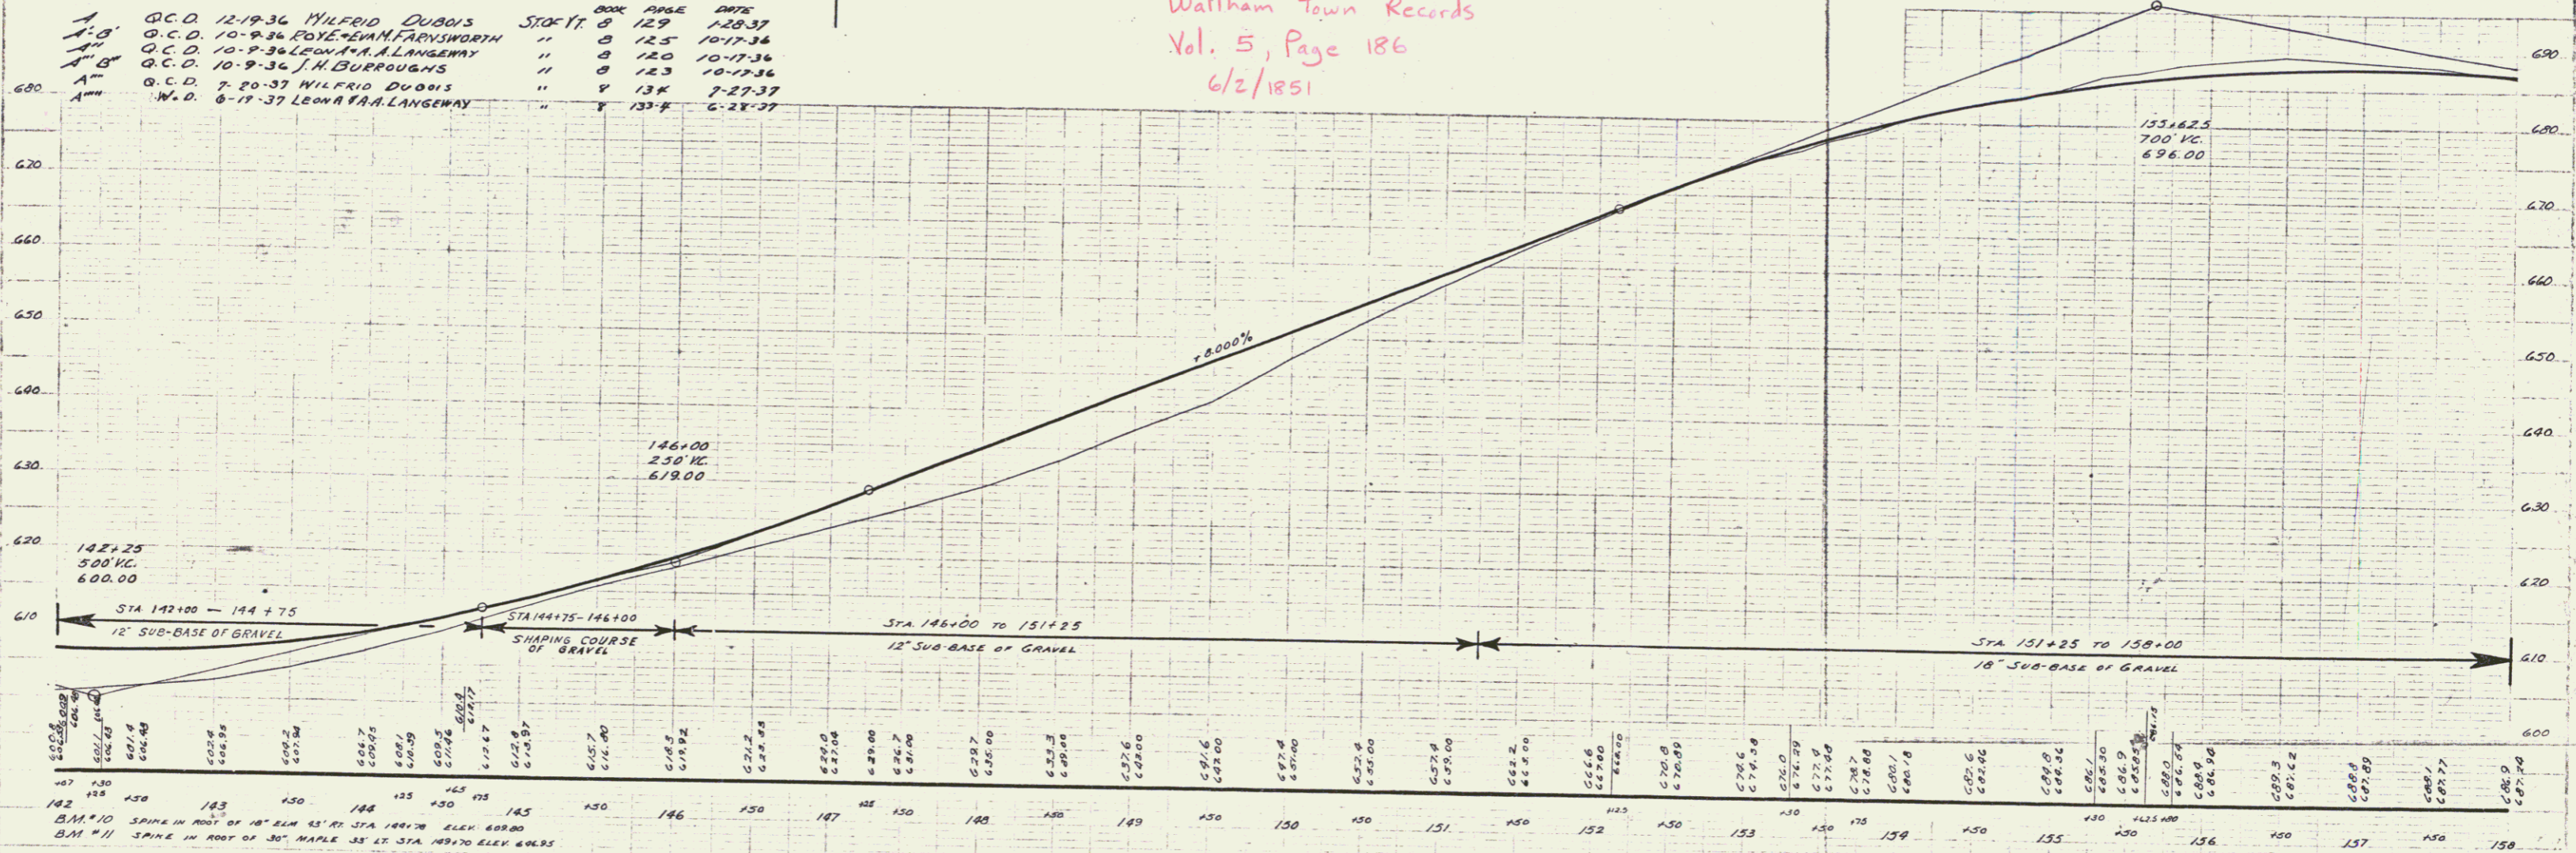

STATION	ELEVATION	STATION	ELEVATION	STATION	ELEVATION	STATION	ELEVATION
142+00	600.00	143+00	605.00	144+00	610.00	145+00	615.00
146+00	625.00	147+00	630.00	148+00	635.00	149+00	640.00
150+00	650.00	151+00	655.00	152+00	660.00	153+00	665.00
155+00	680.00	156+00	685.00	157+00	690.00	158+00	695.00