


Parcel	Kind of Date of Intermittent Instrument	Grantor	Grantee	Recorded	Rembms
A.B.	G.C.D. 10-9-36	J.H. Burroughs	J.P. Y. 3	123	10-17-36

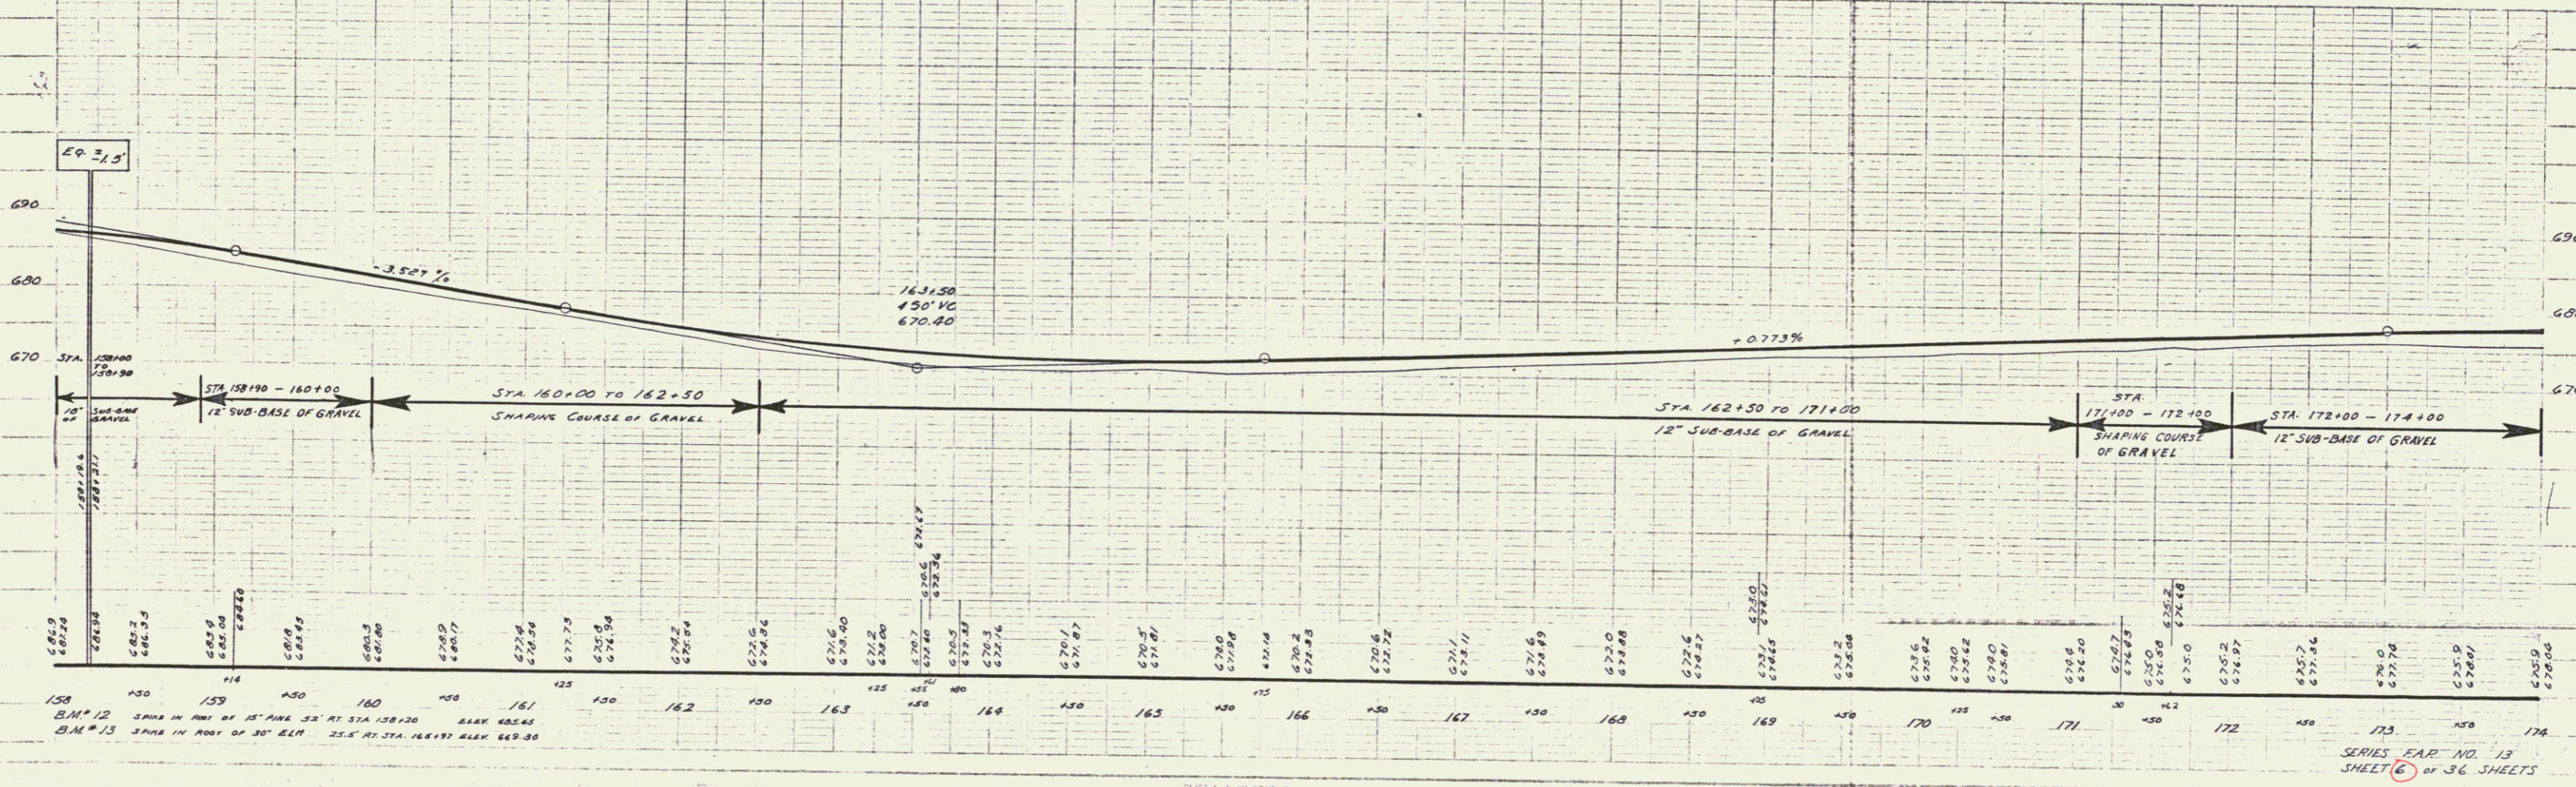

B.M. #12 3 PMS IN ROW OF 15' PINE 22' AT STA. 158+20 BLK 625.62
 B.M. #13 3 PMS IN ROW OF 30' ELM 25.6' AT STA. 161+97 BLK 625.80

SERIES FAR. NO. 13
SHEET 6 OF 36 SHEETS