

PROPERTY LINE FENCE WITH  
STEEL POSTS, MOD. ITEM 583 B  
LT 272+00 - 280+60  
LT 283+30 - 288+00  
RT 272+00 - 279+50  
RT 280+32 - 288+00

CONSTRUCT REST AREA  
274+00 - 280+00 RT. V  
Cedar Log Guard Rail  
275+20 - 278+20 RT.

CONSTRUCT APPROACH  
283+00 LT  
9+30 LT

CONSTRUCT DRIVE  
200+22 RT. 18  
SIDE LINE  
2+95 LT. (SL)  
9+50 LT. (SL)

SPECIAL DITCH, ITEM 101-A  
283+50 - 285+50 LT. V  
286+50 - 287+25 LT. V  
0+50 - 1+75 RT. V

286+75 - 288+75 LT. V  
Speed Change Lane Taper

Drilling & Blasting of Solid  
Rock Subgrade  
278+78 - 280+55  
177 @ 283+00 LT.  
3:00 - 6:10

PARCEL	13A	STA 264+00 - 281+78
GRANTOR	JERRY D B MARIETTA & C PALMER	
TAKING	11.5 A + REM. 85 SA ±	
RIGHTS	DRAINAGE 268+72 LT., 274+00 RT	
TITLE TAKEN		BK. PG. DT.
RECORDED		

PARCEL	15 C	STA 2+52 - 5+50 SL
STATIONS		
TAKING		
RIGHTS		
TITLE TAKEN		BK. PG. DT.
RECORDED		

PARCEL	15 B	STA 209+81 - 281+18 L.A.
STATIONS		
TAKING		
RIGHTS		
TITLE TAKEN		BK. PG. DT.
RECORDED		


PARCEL	13 A	STA 264+00 - 280+60
STATIONS		
TAKING		
RIGHTS		
TITLE TAKEN		BK. PG. DT.
RECORDED		

PARCEL	16 A	STA 280+55 - 295+00
STATIONS		
TAKING		
RIGHTS		
TITLE TAKEN		BK. PG. DT.
RECORDED		

PARCEL	16 56C	STA 280+75 - 281+95.6
GRANTOR	HENRY B FRANCES & KANDLOR	
TAKING	6.24 ±	
RIGHTS	SUPPTS 11+00 - 13+00 SL, LT 1475.50 FT, SUPPTS 7+75 - 8+00 SL, RT 1000.50 FT, DRAINAGE - 255+50 RT, 289+50 RT, 1+50 RT SL	
TITLE TAKEN		BK. PG. DT.
RECORDED		

PARCEL	11 D	STA 281+01 - 282+30
STATIONS		
TAKING		
RIGHTS		
TITLE TAKEN		BK. PG. DT.
RECORDED		

PARCEL	14	STA 270+52 - 281+10
GRANTOR	IRENE S THOMAS	
TAKING	0.2 ± L.A. 8.5 ± L.A.	
RIGHTS		
TITLE TAKEN		BK. PG. DT.
RECORDED		

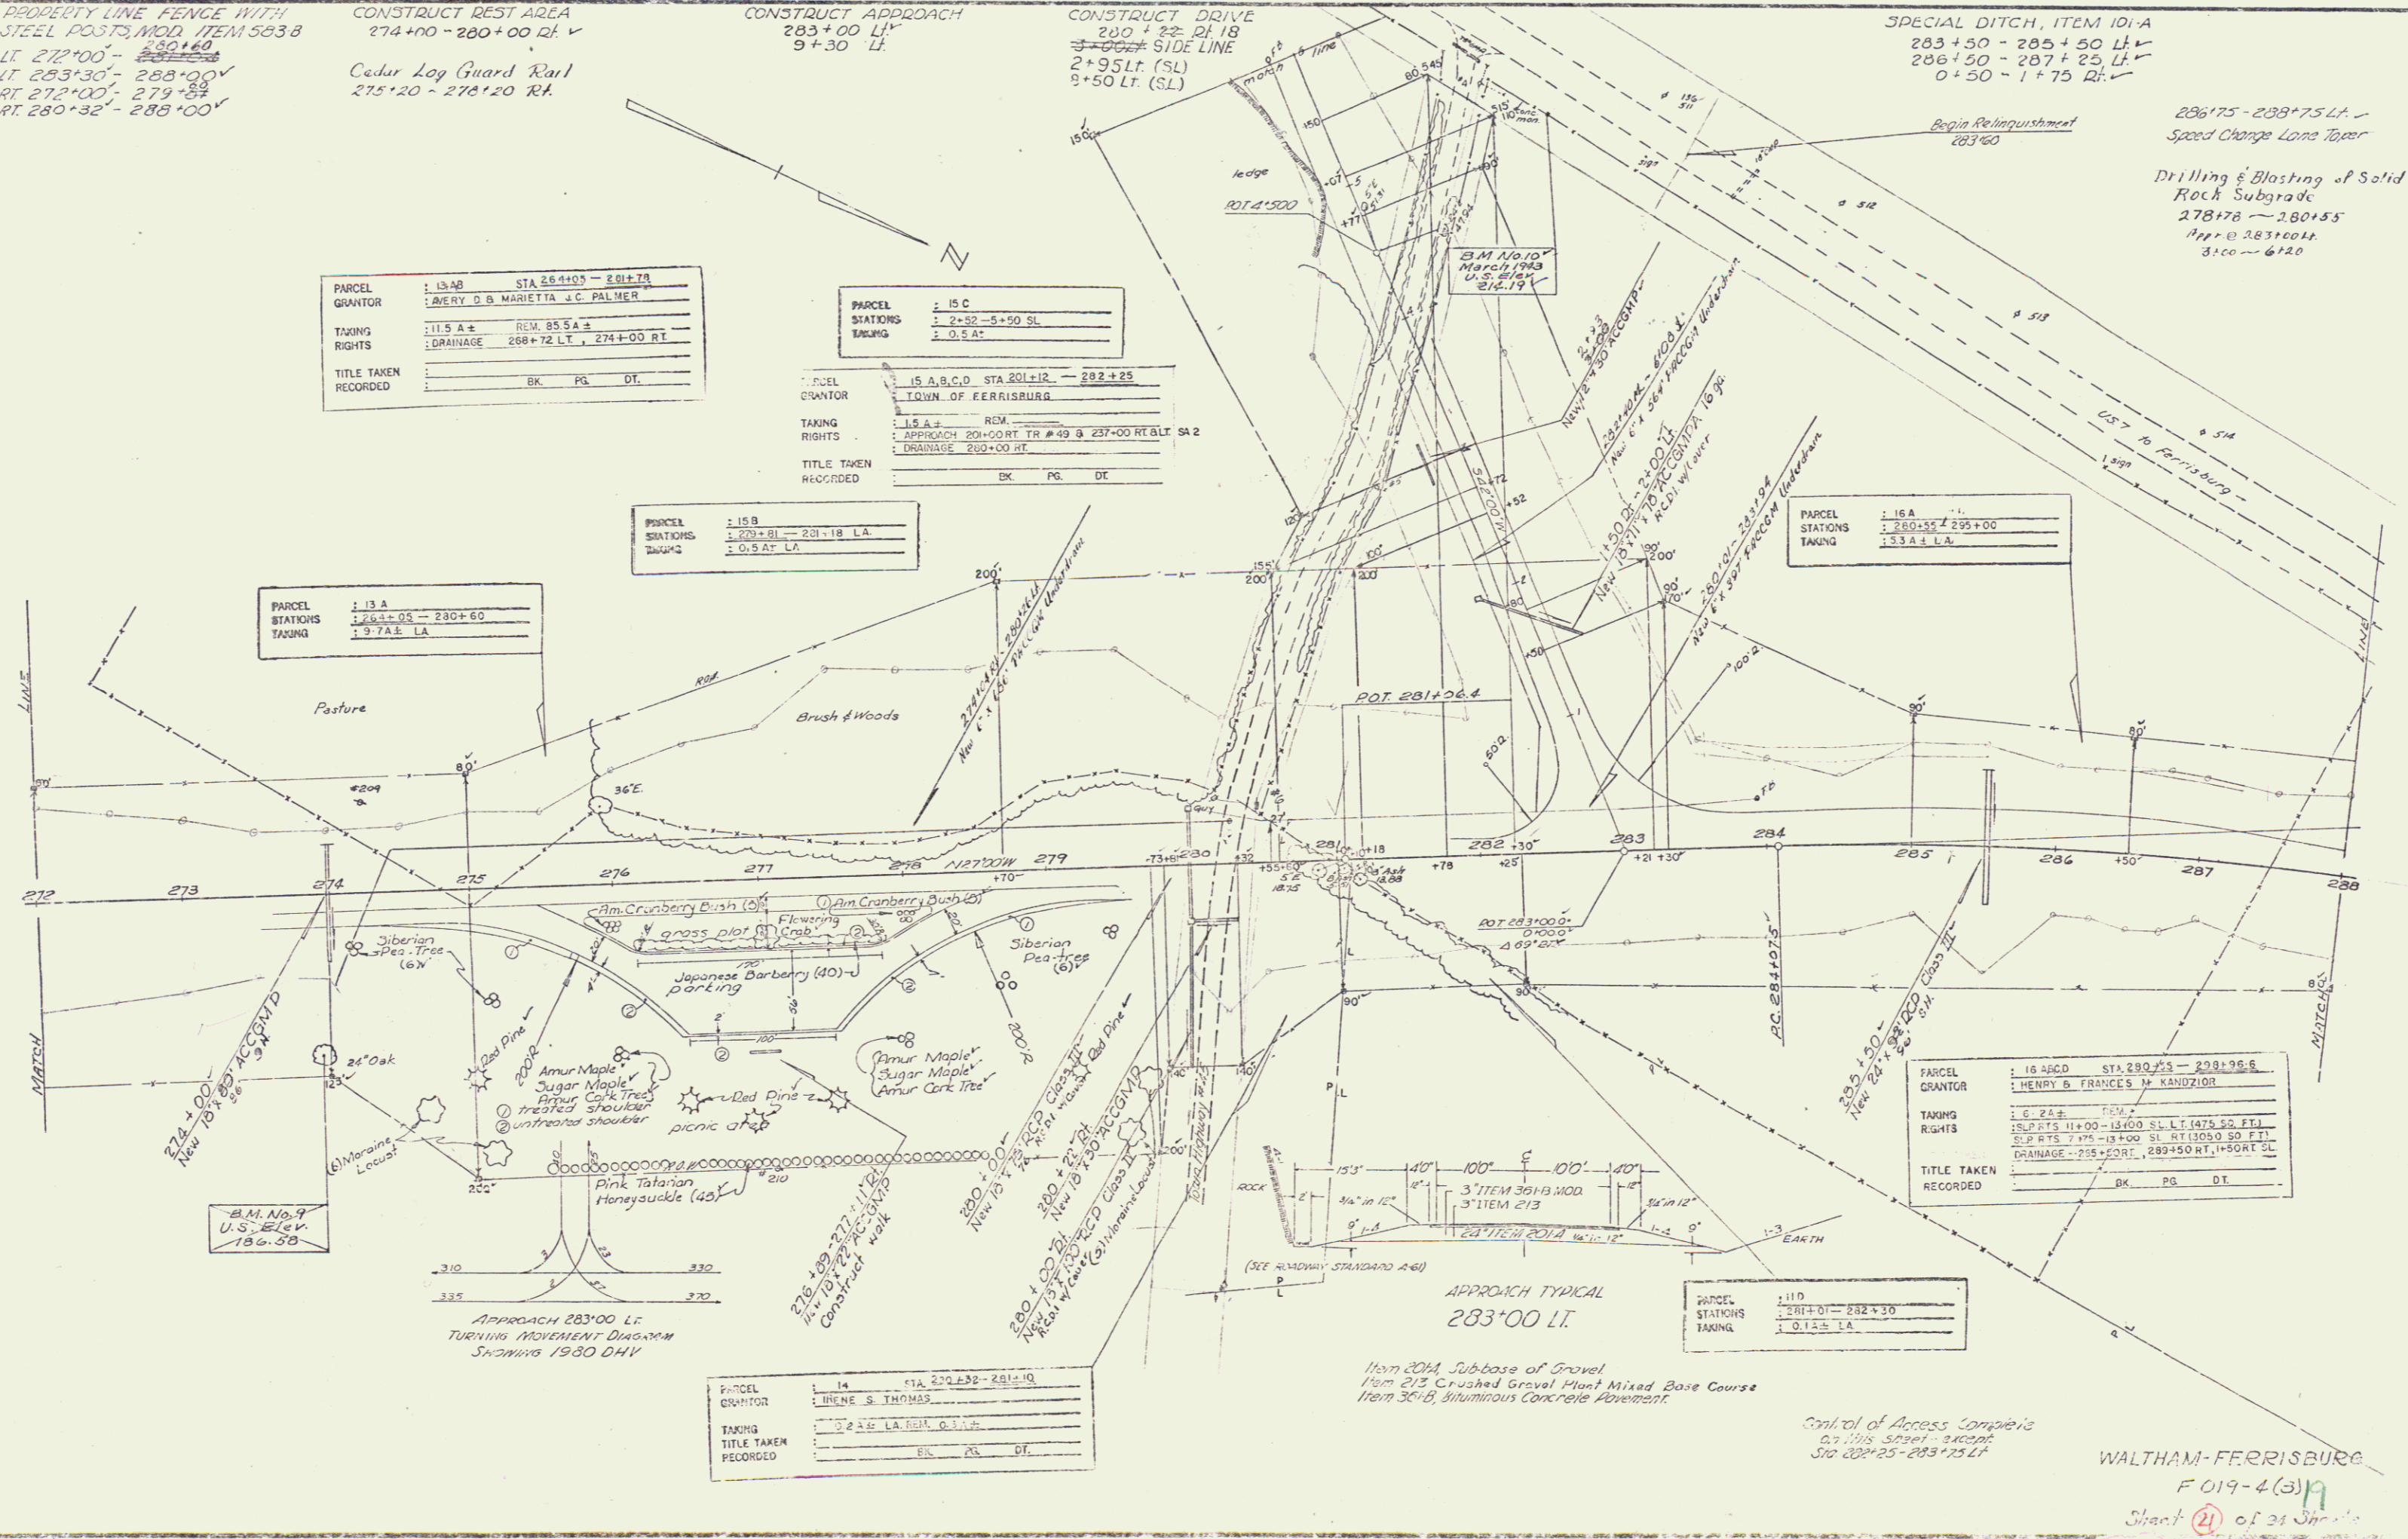

Item 20A Subbase of Gravel  
Item 213 Crushed Gravel Plant Mixed Base Course  
Item 301B Bituminous Concrete Pavement

Control of Access Complete  
on this sheet - except  
Sta 280+25 - 283+25 LT

WALTHAM-FERRISBURG  
F019-4(3)A  
Sheet 21 of 31 Sheets