


CONSTRUCT APPROACH
203+00 L (ML)
0+50 L

PLANK GUARD RAIL w/
PRESERVATIVE TREATMENT
7+00 R (Approach)

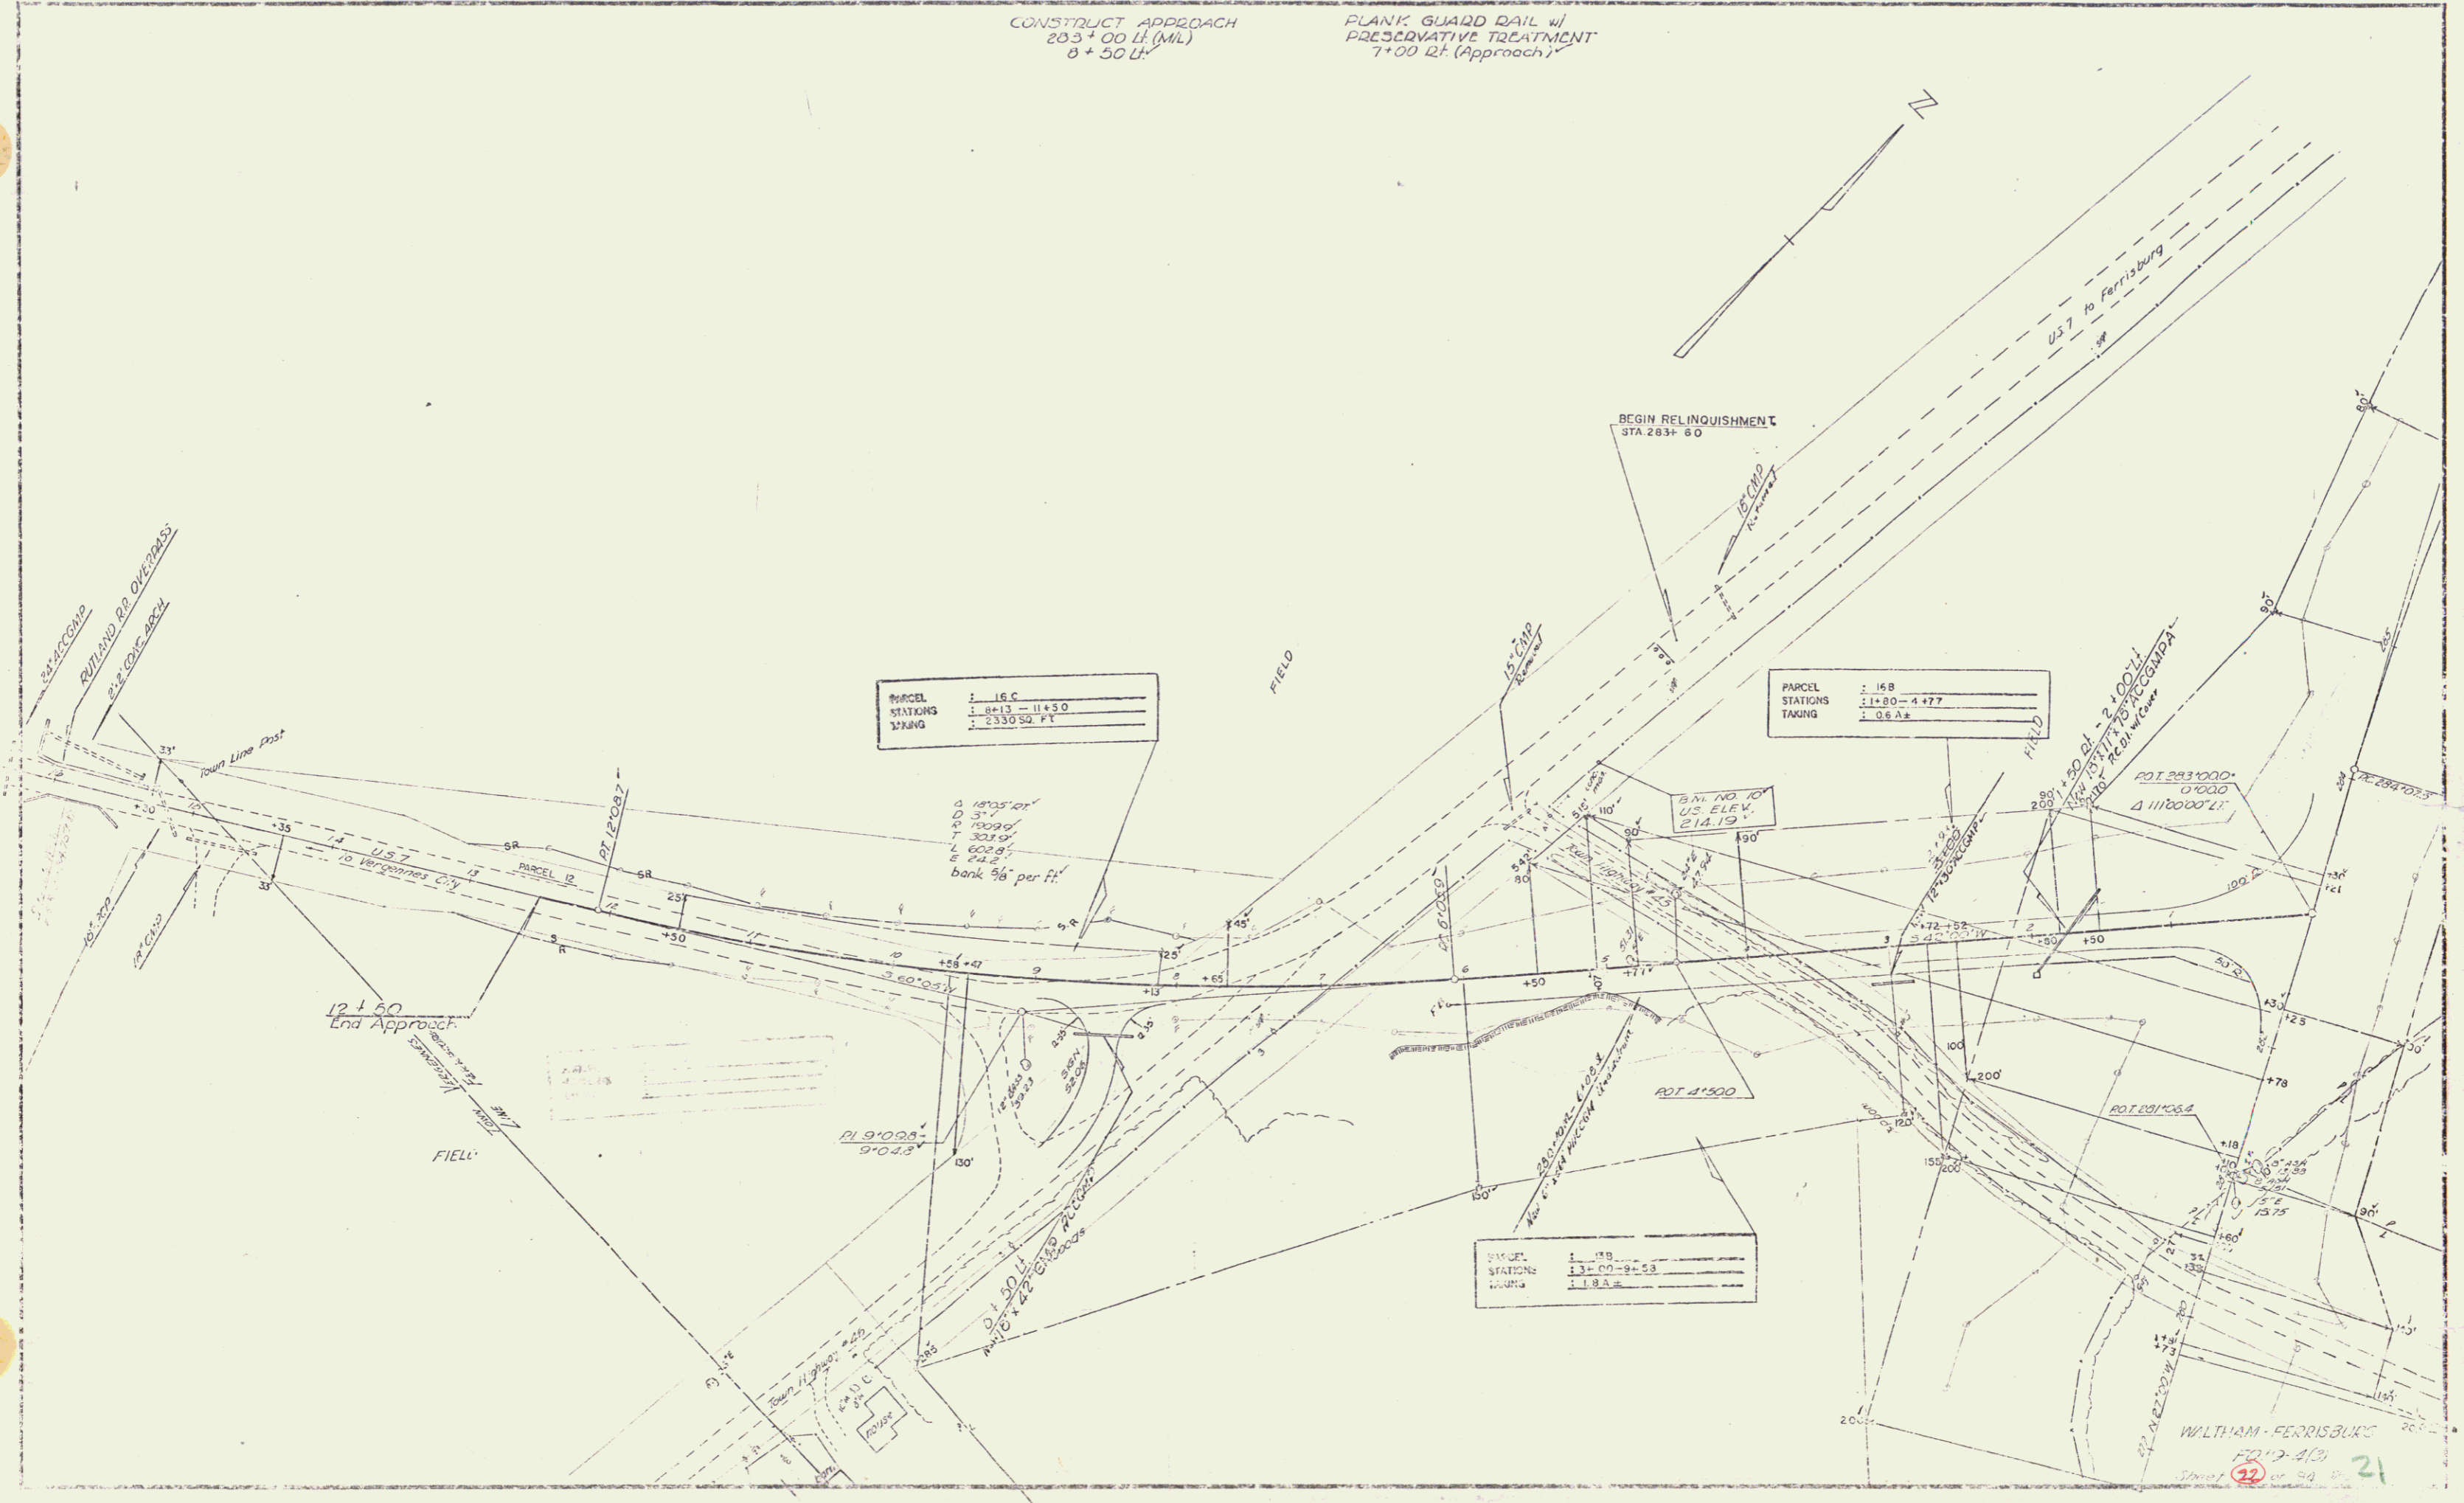

WILTHAM - FERRISBURG
FIELD - 40
Sheet 32 of 34