

INDEX OF SHEETS

- SHEET NO. 1. Title Page  
 2. Typical Cross Sections of Improvement  
 3. Item Quantity and Drainage Sheet  
 4. Earthwork Sheet  
 5-10. Plan and Profile Sheets  
 11. B-1 Banking Tables  
 12. B-5 Typical Slope Grading  
 13. B-12 Side Road Intersection  
 14. B-16 Divisional Islands and Storage Lanes  
 15. C-1 Curb Details  
 16. D-2 Details of Headwalls  
 17. D-3 Jute Matting  
 18. D-4 Details of Flushing Basin  
 19. D-8 Details of Reinf. Conc. Drop Inlets  
 20. D-10 Details of Grates and Tops for Drop Inlets  
 21. E-1 Barricades, signs and lights (for Roadways)  
 22. J-1 Project and Boundary Markers  
 23-24. Cross Section Details  
 25. Final Earthwork Sheet  
 26. Drainage Sheet  
 27. Record Plans

PROJECT NAME & NUMBER TYPE PAVEMENT AREA  
 WALTHAM-FERRISBURG ST 19-4-001 BIT. CONC. PAV'T.

RECORD PLANS  
 MATERIALS  
 SUBBASE OF GRAVEL-POOSKA PIT BRISTOL, VT  
 SUBBASE OF SAND-KILBURN PIT BRISTOL, VT  
 GRAVEL SHOULDERS-POOSKA PIT BRISTOL, VT  
 STONE BRITS-DEMERS QUARRY WINDSOOL, VT  
 CUTBACK ASPHALT-ALL STATES ASPHALT INC. SUNDERLAND, MASS.  
 CRUSHED PLANT MIXED BASE COURSE-L.M.PIKE FLORENCE, VT.  
 BITUMINOUS CONCRETE PAVEMENT-L.M.PIKE FLORENCE, VT.  
 BITUMINOUS CONC. SURFACE FOR CUTTERS & TRAFFIC ISLAND L.M.PIKE  
 ACCOMP. PIPE & ARCH & UNDERDRAIN-NEW ENGLAND METAL CO. ARMCO  
 WHITE RIVER JCT. VERMONT

R.C. PIPE ST. GRISWALL CO. INC. WILLISTON, VT  
 CON. CLASS "B" ST. GRISWALL CO. INC. WILLISTON, VT.

CONTRACTOR: COOLEY CONST. CO. INC. BARRE, VT.  
 RESIDENT ENG. ARMOND A. PICHE  
 RECORD PLANS: S.H. WHITNEY

CONTRACT:  
 DATED JUNE 11, 1965  
 STARTED JUNE 14, 1965  
 COMPLETED AUG. 1, 1965  
 ACCEPTED AUG. 4, 1965

STATE OF VERMONT  
 DEPARTMENT OF HIGHWAYS

PROPOSED IMPROVEMENT

STATE PROJECT

TOWNS OF WALTHAM-FERRISBURG

COUNTY OF ADDISON

U.S. ROUTE 7

Pin # 99R46



MIDDLEBURY-BURLINGTON ROAD

BEGINNING AT A POINT 1.547 MILES NORTH OF THE  
 NEW HAVEN-WALTHAM TOWN LINE AND EXTENDING  
 NORTHERLY 1.770 MILES, EXCLUDING 1.171 MILES.

LENGTH OF ROADWAY 2,615 FEET = 0.495 MILE (SECTION 1)  
 LENGTH OF ROADWAY 550 FEET = 0.104 MILE (SECTION 2)  
 LENGTH OF PROJECT 3,165 FEET = 0.599 MILE

1960 ADT 2280-3100  
 1980 ADT 3220-4950  
 1980 DHV 445-645  
 D 60 %  
 T 5 %  
 DESIGN SPEED 60 M.P.H.

FED. ROAD DISTRICT NO.	STATE	PROJECT NO.	SHEET NO.	TOTAL SHEETS
1	VT	ST-19-4-001	1	1

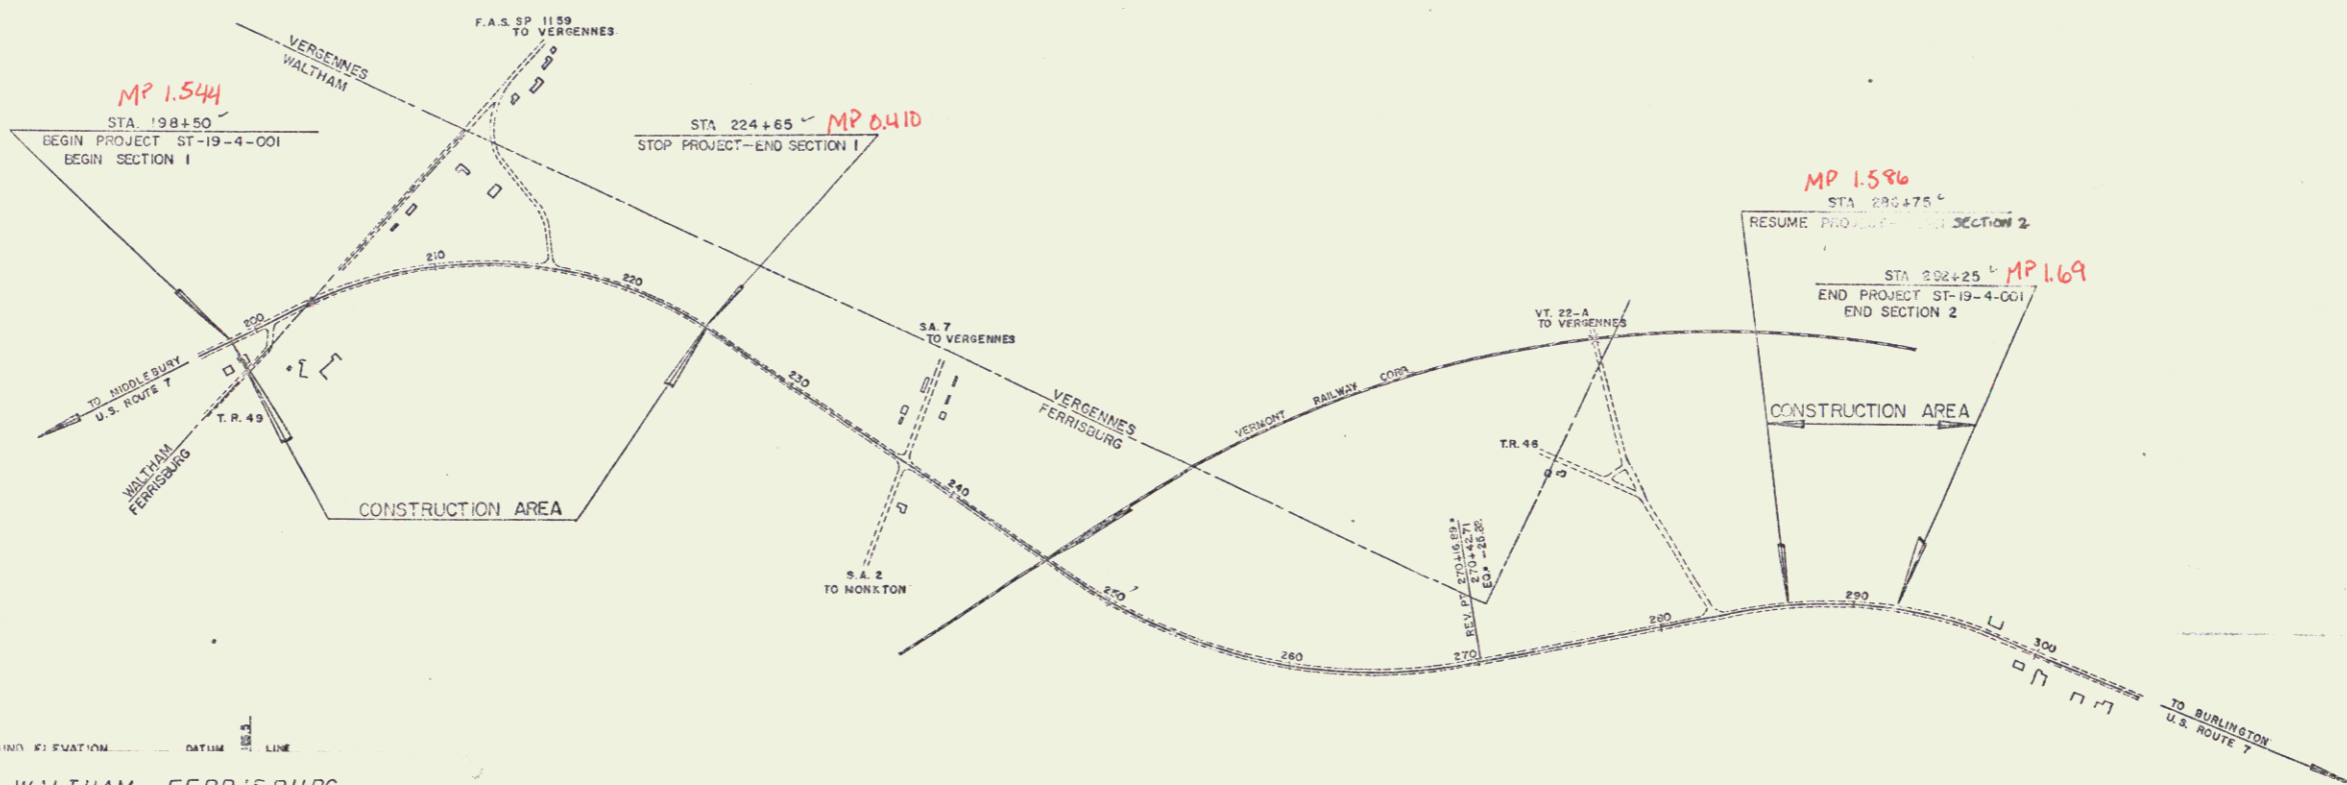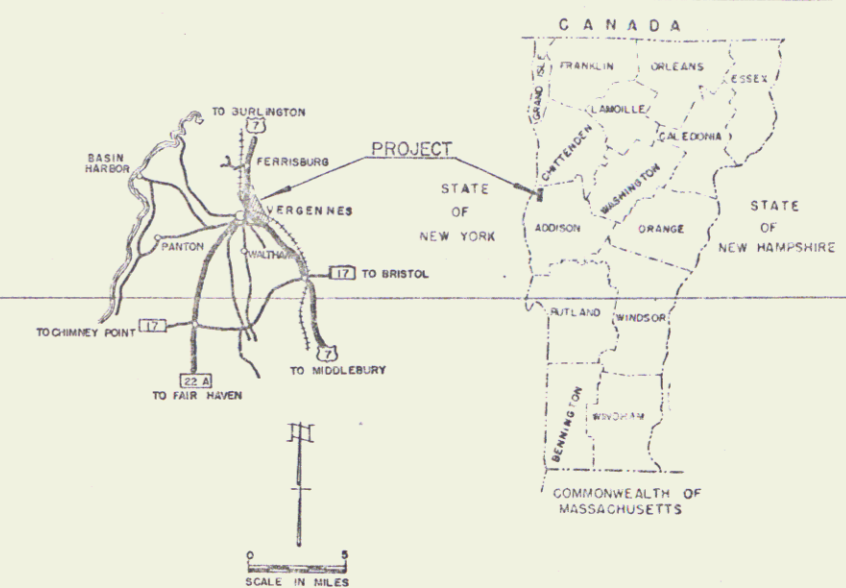

CONVENTIONAL SIGNS

- COUNTY LINE
- TOWN LINE
- FENCE LINE
- STONE WALL
- DEFERRED PROPERTY
- GUARD RAIL
- TRAVELED WAY
- RAILROAD
- RETAINING WALL
- CENTER LINE
- SURVEY LINE
- CALVERT
- DITCH
- TRUCK STOP
- POWER POLE
- TELEPHONE POLE
- TRUCKS
- TRUCKS

WALTHAM-FERRISBURG ST 19-4-001  
 CONTRACTOR: COOLEY CONST. CO. INC. BARRE, VT.  
 RECORD PLANS: S.H. WHITNEY

PROJECT WALTHAM-FERRISBURG  
 NUMBER ST 19-4-001 LENGTH 0.599 MI.  
 TYPE 3" BITUMINOUS CONCRETE  
 CONTRACTOR COOLEY CONST. CO. INC.  
 YEAR 1965  
 Location Beginning at a point 1.547 miles north of  
 the New Haven-Waltham town line and extend-  
 ing northerly 1.770 miles, excluding 1.171 miles.



THESE PLANS ARE SUBJECT TO SUCH REVISIONS AS MAY BE  
 REQUIRED BY THE BUREAU OF PUBLIC ROADS OR THE COMMISSIONER  
 OF HIGHWAYS.  
 CONSTRUCTION IS TO BE CARRIED ON IN ACCORDANCE WITH  
 THESE PLANS AND THE STANDARD SPECIFICATIONS FOR HIGHWAY AND BRIDGE  
 CONSTRUCTION DATED APRIL 1964, AS APPROVED BY THE BUREAU OF  
 PUBLIC ROADS ON OCTOBER 12, 1964, INCLUDING ALL SUBSEQUENT  
 APPROVED REVISIONS AND SUCH REVISED SPECIFICATIONS AND SPECIAL  
 PROVISIONS AS ARE INCORPORATED IN THESE PLANS.

DEPARTMENT OF COMMERCE  
 BUREAU OF PUBLIC ROADS  
 APPROVED

APPROVED <i>P.H. Curran</i> ASST. CHIEF ENGINEER DATE 8/20/65	APPROVED <i>E.H. O'Rourke</i> COMMISSIONER DATE 8-30-65	APPROVED _____ DATE _____	APPROVED <i>J. Smith</i> DISTRICT ENGINEER DATE 8/20/65	APPROVED <i>J.W. Lane</i> PROJECT ENGINEER DATE 8-27-65	APPROVED <i>A.B. Bishop</i> CHIEF ENGINEER DATE 8/20/65	APPROVED _____ DATE _____
---	---	------------------------------	---	---	---	------------------------------

DIVISION ENGINEER DATE  
 PROJECT ST 19-4-001  
 SHEET 1 OF 84 SHEETS