



INDEX OF SHEETS

| | |
|-----------|--|
| SHEET NO. | TITLE PAGE |
| 1 | TITLE PAGE |
| 2 | TYPICAL SECTIONS OF IMPROVEMENT - DOUBLE TACK COAT OF CUTBACK ASPHALT W/PEASTONE |
| 3 | QUANTITY SHEET, ITEMS |
| 4 | QUANTITY SHEET, DRAINAGE |
| 5-6 | EARTHWORK SHEETS |
| 7-11 | PLAN & PROFILE |
| 12 | STANDARD BRIDGE SHEET SB-20-56 DETAILS FOR WF BEAM BRIDGES |
| 13 | STANDARD BRIDGE SHEET SB-22-58 DETAILS OF SLAB & PIERS |
| 14-15 | STANDARD BRIDGE SHEET SCB-30-56 (49-59-49 SPAN) |
| 16 | STANDARD BRIDGE SHEET SB-AS-50-57 (MOD) DETAILS OF APPROACH SLABS |
| 17-18 | STANDARD BRIDGE SHEET SB-50-57 DETAILS OF BRIDGE RAILING & CURB |
| 19 | STANDARD BRIDGE SHEET BS-56-2 BARRICADES, SIGN & LIGHTS (BRIDGE) |
| 20 | ROADWAY STANDARD SHEET RS 56-1 BARRICADES |
| 21 | ROADWAY STANDARD SHEET RS 56-2 REINF. CONC. DROP INLETS |
| 22 | ROADWAY STANDARD SHEET RS 56-3 MARKERS |
| 23 | ROADWAY STANDARD SHEET RS 56-4 DRAINAGE |
| 24 | ROADWAY STANDARD SHEET RS 56-6 TYPICAL SLOPE GRADING |
| 25 | ROADWAY STANDARD SHEET RS 56-11 THREE CABLE GUARD RAIL W/STEEL POSTS |
| 26 | ROADWAY STANDARD SHEET RS 56-12 BARRICADES, SIGN & LIGHTS (ROADWAY) |
| 27 | ROADWAY STANDARD SHEET RS 56-14 PRECAST R.C.P. DROP INLETS |
| 28 | ROADWAY STANDARD SHEET A-61 DRILLING & BLASTING OF SOILD ROCK SUBGRADE |
| 29 | ROADWAY STANDARD SHEET G-4 STEEL MARKER POSTS |
| 30 | BRIDGE SHEET 79+75 GENERAL PLAN |
| 31 | BRIDGE SHEET 79+75 BORINGS |
| 32 | BRIDGE SHEET 79+75 PLAN & ELEVATION |
| 33 | BRIDGE SHEET 79+75 ABUTMENT NO. 1 & NO. 2 |
| 34 | BRIDGE SHEET 79+75 APPROACH SLABS |
| 35 | BRIDGE SHEET 79+75 PIERS "A" & "B" |
| 36 | BRIDGE SHEET 79+75 STRUCTURAL PLAN & DETAIL |
| 37 | BRIDGE SHEET 79+75 REINFORCING SCHEDULE |
| 38-73 | CROSS SECTIONS |
| 74-77 | CHANNEL SECTIONS BRIDGE AT 79+75 |

STATE OF VERMONT
DEPARTMENT OF HIGHWAYS
PROPOSED IMPROVEMENT

TOWN OF FERRISBURG
COUNTY OF ADDISON
U.S. ROUTE 7
CHARLOTTE-VERGENNES ROAD

BEGINNING AT A POINT 2,990 FEET FROM THE VERGENNES-FERRISBURG TOWN LINE AND EXTENDING NORTHERLY 6,800.0 FEET.
LENGTH OF ROADWAY 6,643.0 FEET + 1.258 MILES.
LENGTH OF BRIDGE 157.0 FEET + 0.030 MILES
LENGTH OF PROJECT 6,800.0 FEET + 1.288 MILES
DESIGN DESIGNATION
ADT (1955) 2750-3270
ADT (1975) 4400-8240
DHV (1975) 575-665
D - 59%
T - 7 1/2%
V - 80 MPH.

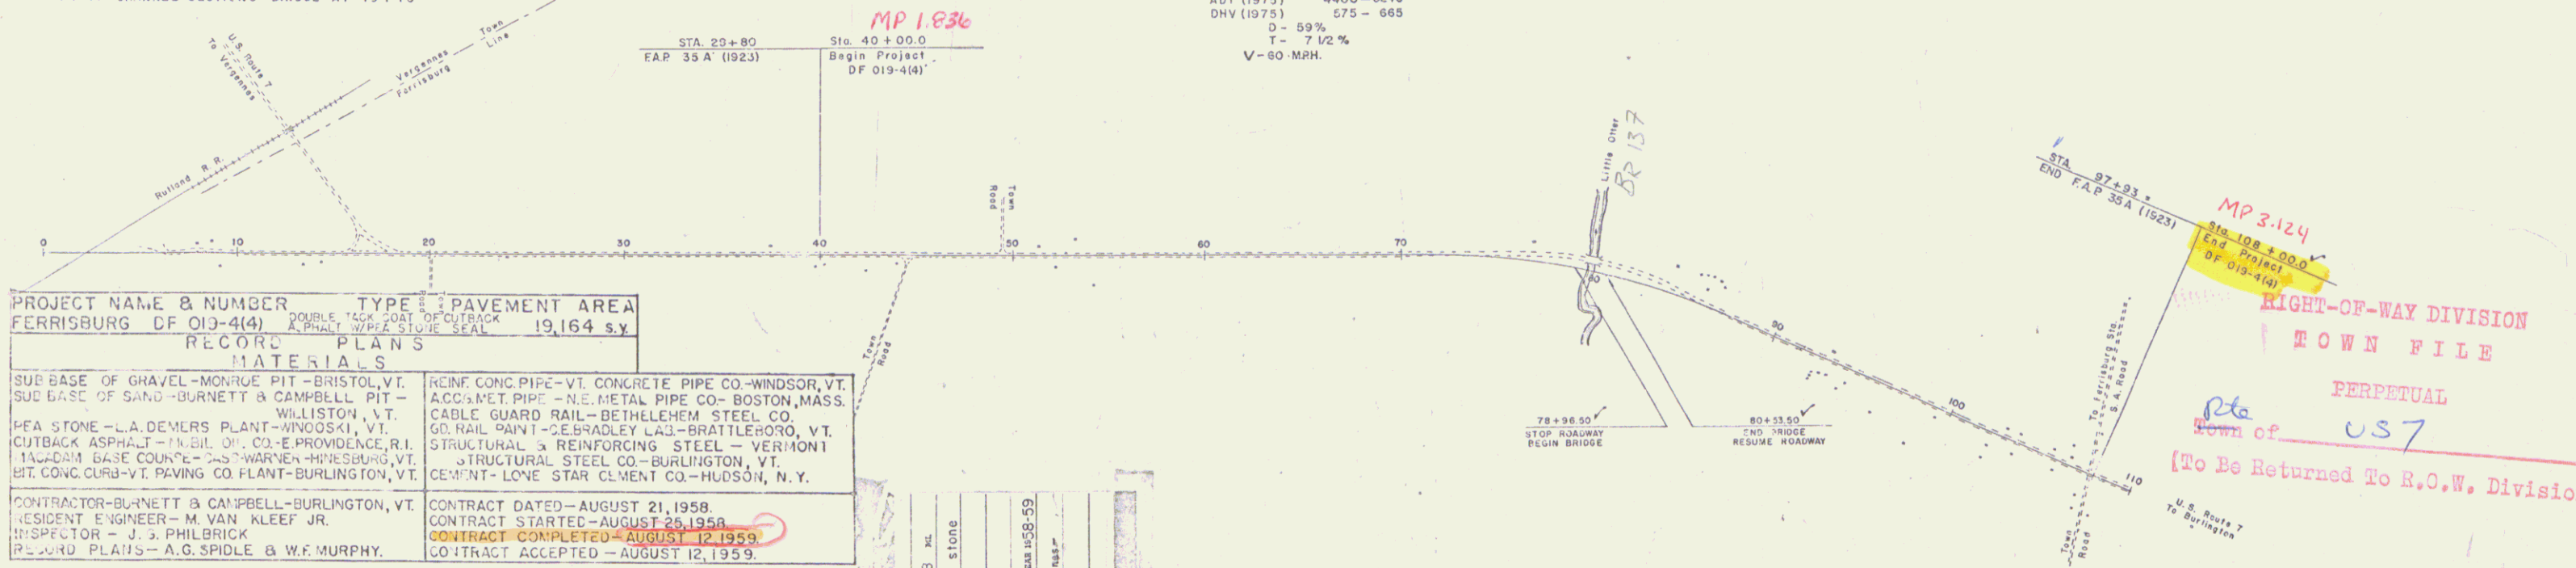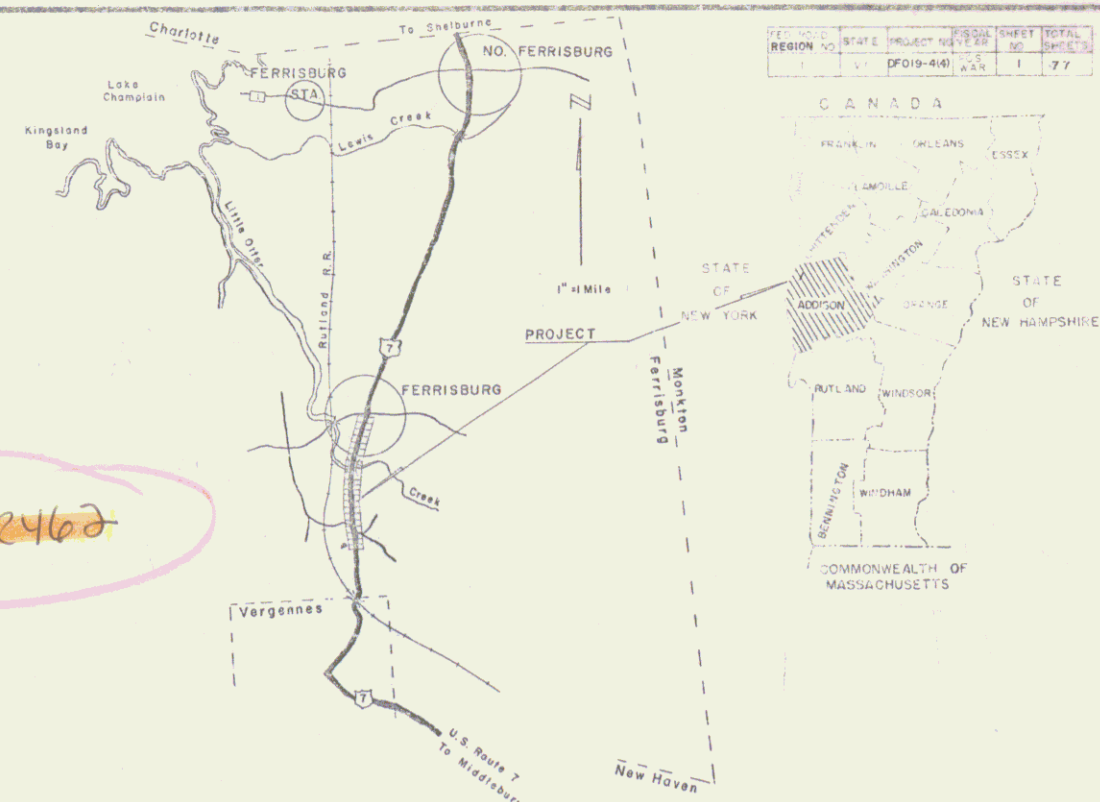

PROJECT NAME & NUMBER TYPE TYPE PAVEMENT AREA
FERRISBURG DF 019-4(4) DOUBLE TACK COAT OF CUTBACK ASPHALT W/PEASTONE SEAL ITEM 312-B 19,164 s.y.

RECORD PLANS MATERIALS

| | |
|--|--|
| SUB BASE OF GRAVEL-MONROE PIT-BRISTOL, VT. | REINF. CONC. PIPE-VI. CONCRETE PIPE CO-WINDSOR, VT. |
| SUB BASE OF SAND-BURNETT & CAMPBELL PIT-WILLISTON, VT. | ACCUM. MET. PIPE-NE. METAL PIPE CO-BOSTON, MASS. |
| PEA STONE-L.A. DEMERS PLANT-WINDSOR, VT. | CABLE GUARD RAIL-BEITHEHEM STEEL CO. |
| CUTBACK ASPHALT-F.R. DILLON CO.-E. PROVIDENCE, R.I. | GR. NAIL PAINT-GE. BRADLEY LAB-BRATTLEBORO, VT. |
| MAG-DRAIN BASE COURSE-2-37 WARNER, FERRISBURG, VT. | STRUCTURAL & REINFORCING STEEL-VERMONT STRUCTURAL STEEL CO-BURLINGTON, VT. |
| BIT. CONC. CURB-VI. PAVING CO. PLANT-BURLINGTON, VT. | CEMENT-LONE STAR CEMENT CO.-HUDSON, N. Y. |

CONTRACTOR BURNETT & CAMPBELL-BURLINGTON, VT.
RESIDENT ENGINEER M. VAN KLEEF JR.
INSPECTOR J. S. PHILBRICK
RECORD PLANS-A.G. SPIDLE & W.F. MURPHY.

CONTRACT DATED-AUGUST 21, 1958.
CONTRACT STARTED-AUGUST 25, 1958.
CONTRACT COMPLETED-AUGUST 12, 1959.
CONTRACT ACCEPTED-AUGUST 12, 1959.

CONVENTIONAL SIGNS

| | |
|-------------------|-------|
| COUNTY LINE | ----- |
| TOWN LINE | ----- |
| FORMER LINE | ----- |
| STONE WALL | ----- |
| UNFENCED PROPERTY | ----- |
| GUARD RAIL | ----- |
| TRAVELLED WAY | ----- |
| RAILROAD | ----- |
| RETAINING WALL | ----- |
| CENTER LINE | ----- |
| SURVEY LINE | ----- |
| CULVERT | ----- |
| DROP INLET | ----- |
| TROLLEY POLE | ----- |
| POWER POLE | ----- |
| TELEPHONE POLE | ----- |
| TREES | ----- |
| WELDS | ----- |

CONTRACTOR BURNETT & CAMPBELL
BURLINGTON, VERMONT
LOCATION Beginning at a point 2,990 feet from the Vergennes-Ferrisburg Town Line and extending northerly 6,800 feet.

APPROVED [Signature] DATE July 25, 1958
APPROVED [Signature] DATE July 22, 1958
APPROVED [Signature] DATE July 22, 1958
APPROVED [Signature] DATE July 22, 1958
APPROVED [Signature] DATE July 22, 1958

DEPARTMENT OF COMMERCE
BUREAU OF PUBLIC ROADS

APPROVED [Signature] DATE July 22, 1958

SHEET 1 OF 77

RIGHT-OF-WAY DIVISION
TOWN FILE
PERPETUAL
Town of Ferrisburg
U.S. 7
(To Be Returned To R.O.W. Division)

STEARNS R. JENKINS
US 7