
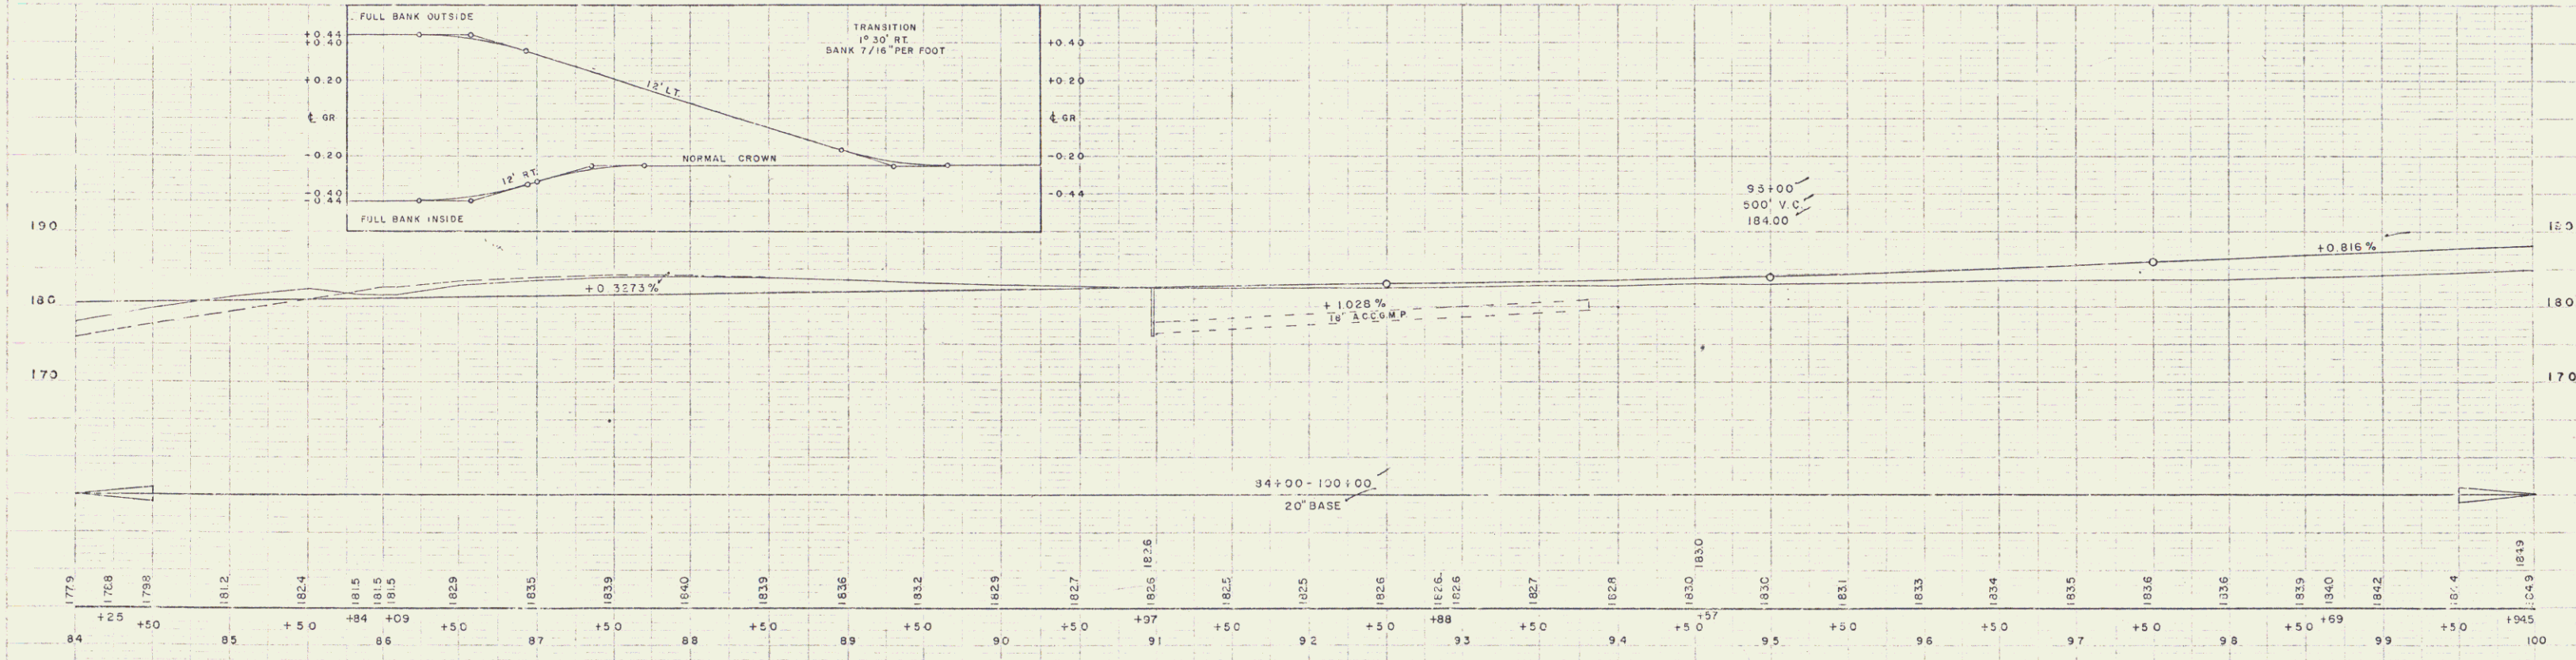


WESTER-MARTIN, INC. 12-27-58

WESTER-MARTIN, INC. 12-27-58

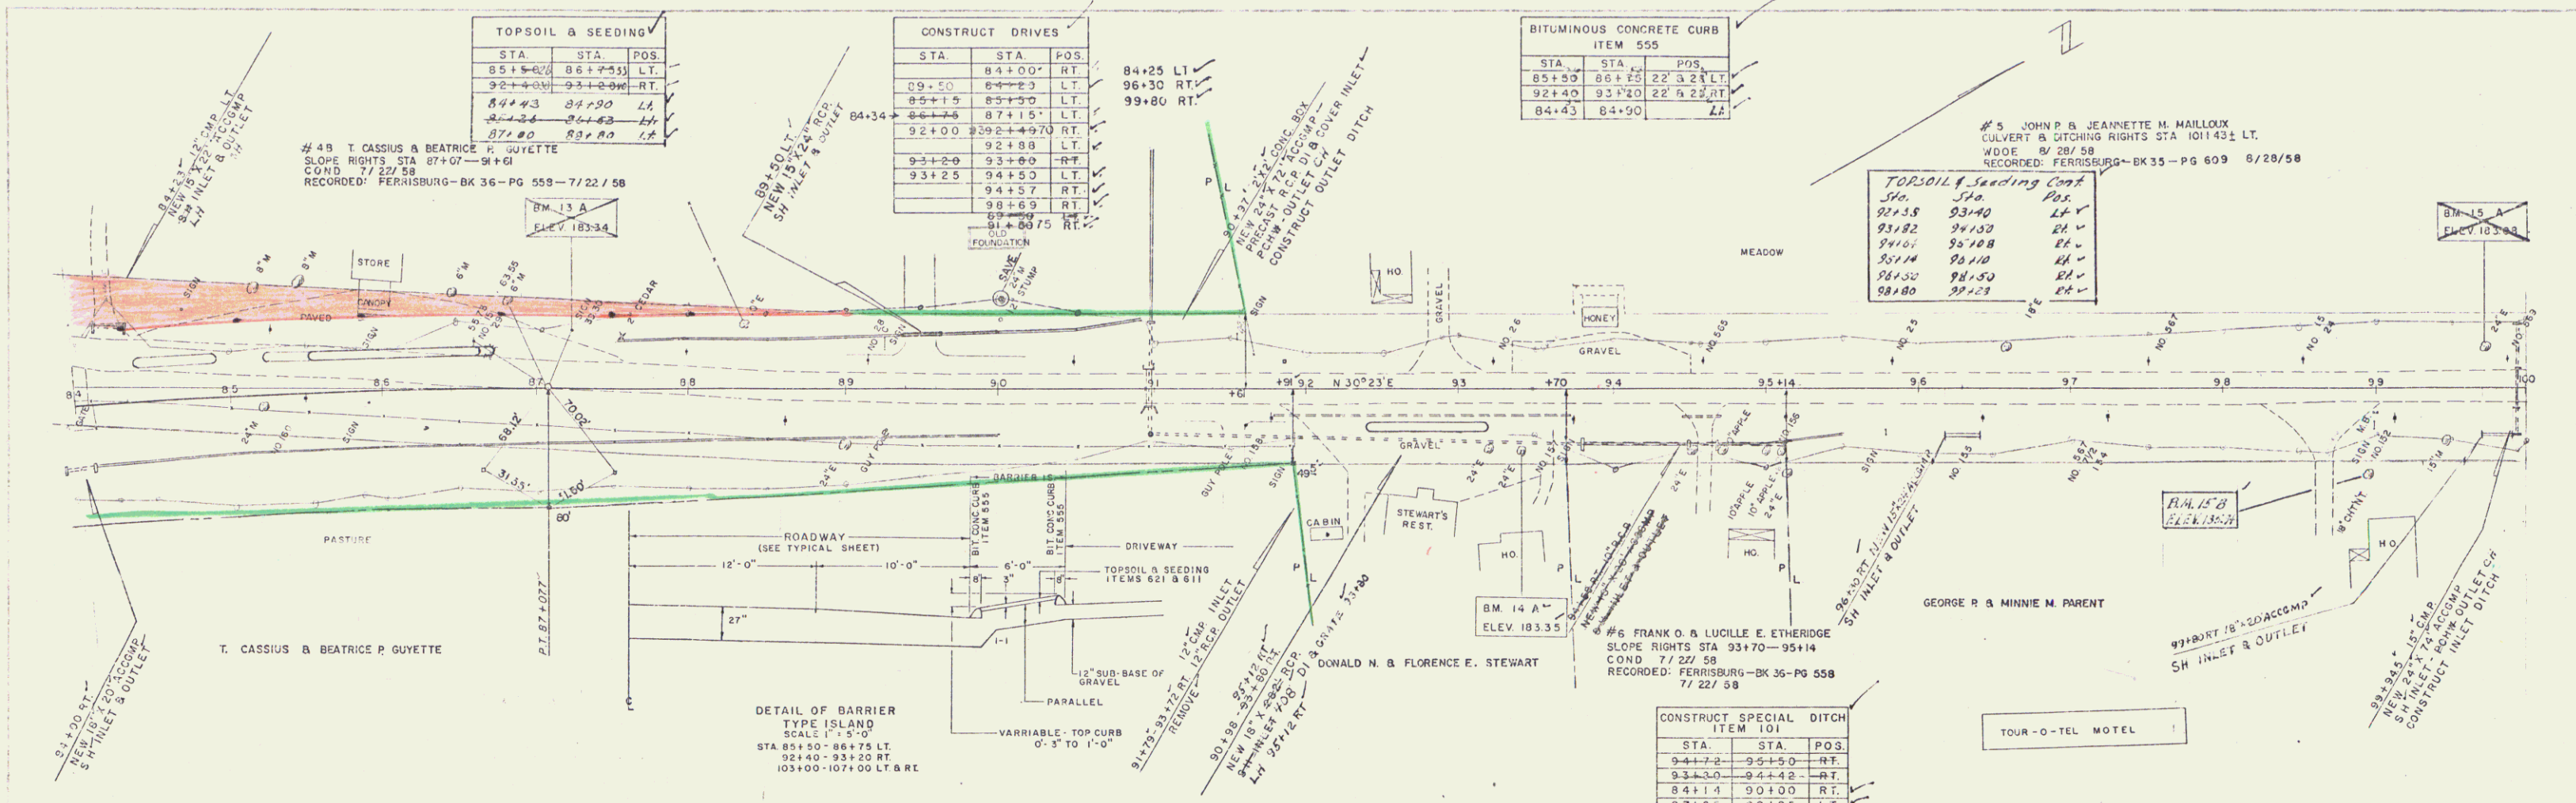

STA	STA	POS.
85+00	86+75	LT.
92+40	93+00	RT.
84+43	84+90	LT.
87+25	87+25	LT.

STA	STA	POS.
89+50	89+50	LT.
92+00	92+00	RT.
93+25	93+25	LT.
94+50	94+50	LT.

STA	STA	POS.
85+30	86+15	22' x 22' LT.
92+40	93+20	22' x 22' RT.
84+43	84+90	LT.

STA	STA	POS.
91+15	91+40	LT.
91+01	91+08	RT.
91+14	91+10	RT.
91+30	91+30	RT.
91+80	91+27	RT.

STA	STA	POS.
94+72	95+50	RT.
93+30	94+42	RT.
84+14	90+00	RT.
87+25	90+35	LT.

BM 13A 2 1/2\"/>

BM 14A 1 R 2 1/2\"/>

FERRISBURG OF 019-4(4)
SHEET 10 OF 77
B.M. 15-B SURV. Chestnut St. 98+13 ELEV. 183.91
E.M. 15-B SURV. Chestnut St. 98+13 ELEV. 183.91