
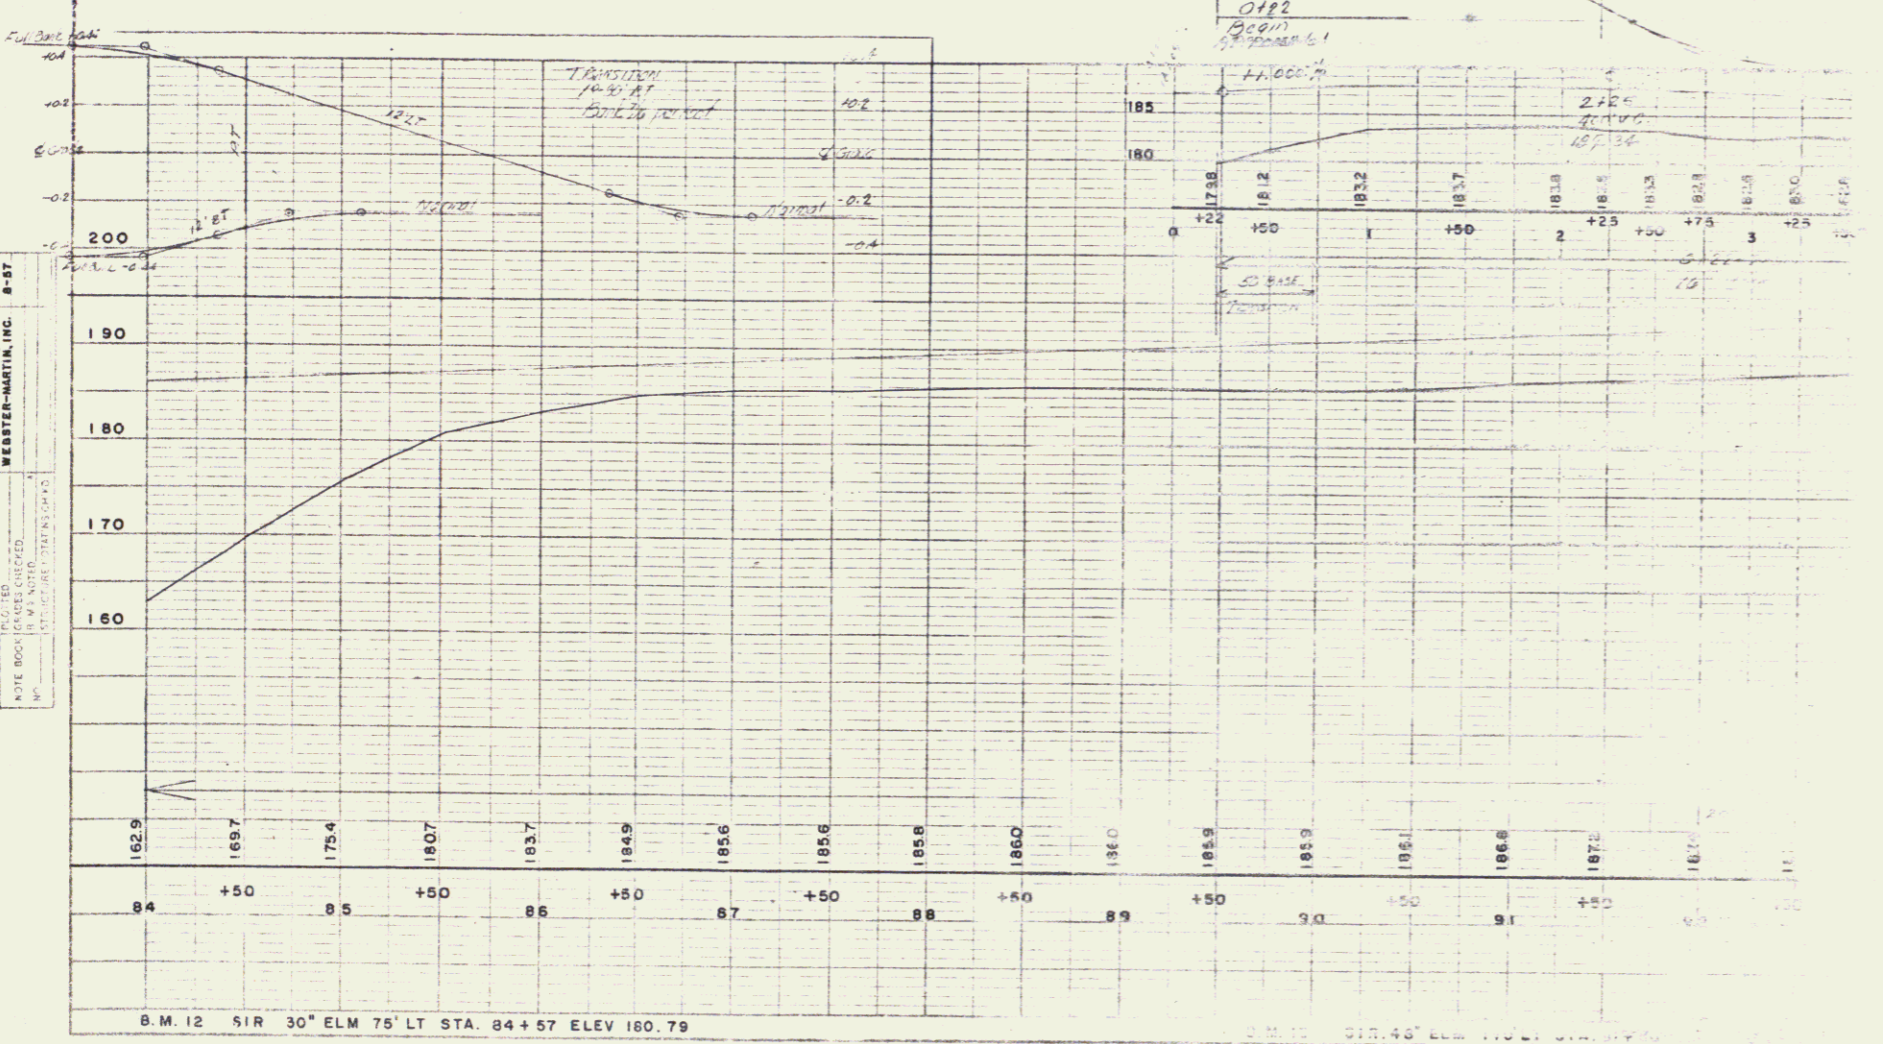


PLAN
 DESIGNED BY
 WESTER-MARTIN, INC.
 8-37
 CHECKED BY
 WESTER-MARTIN, INC.
 8-37
 NOTE BOOK
 NO. 1000
 DATE OF SURVEY
 10/15/54

PROFILE
 DESIGNED BY
 WESTER-MARTIN, INC.
 8-37
 CHECKED BY
 WESTER-MARTIN, INC.
 8-37
 NOTE BOOK
 NO. 1000
 DATE OF SURVEY
 10/15/54

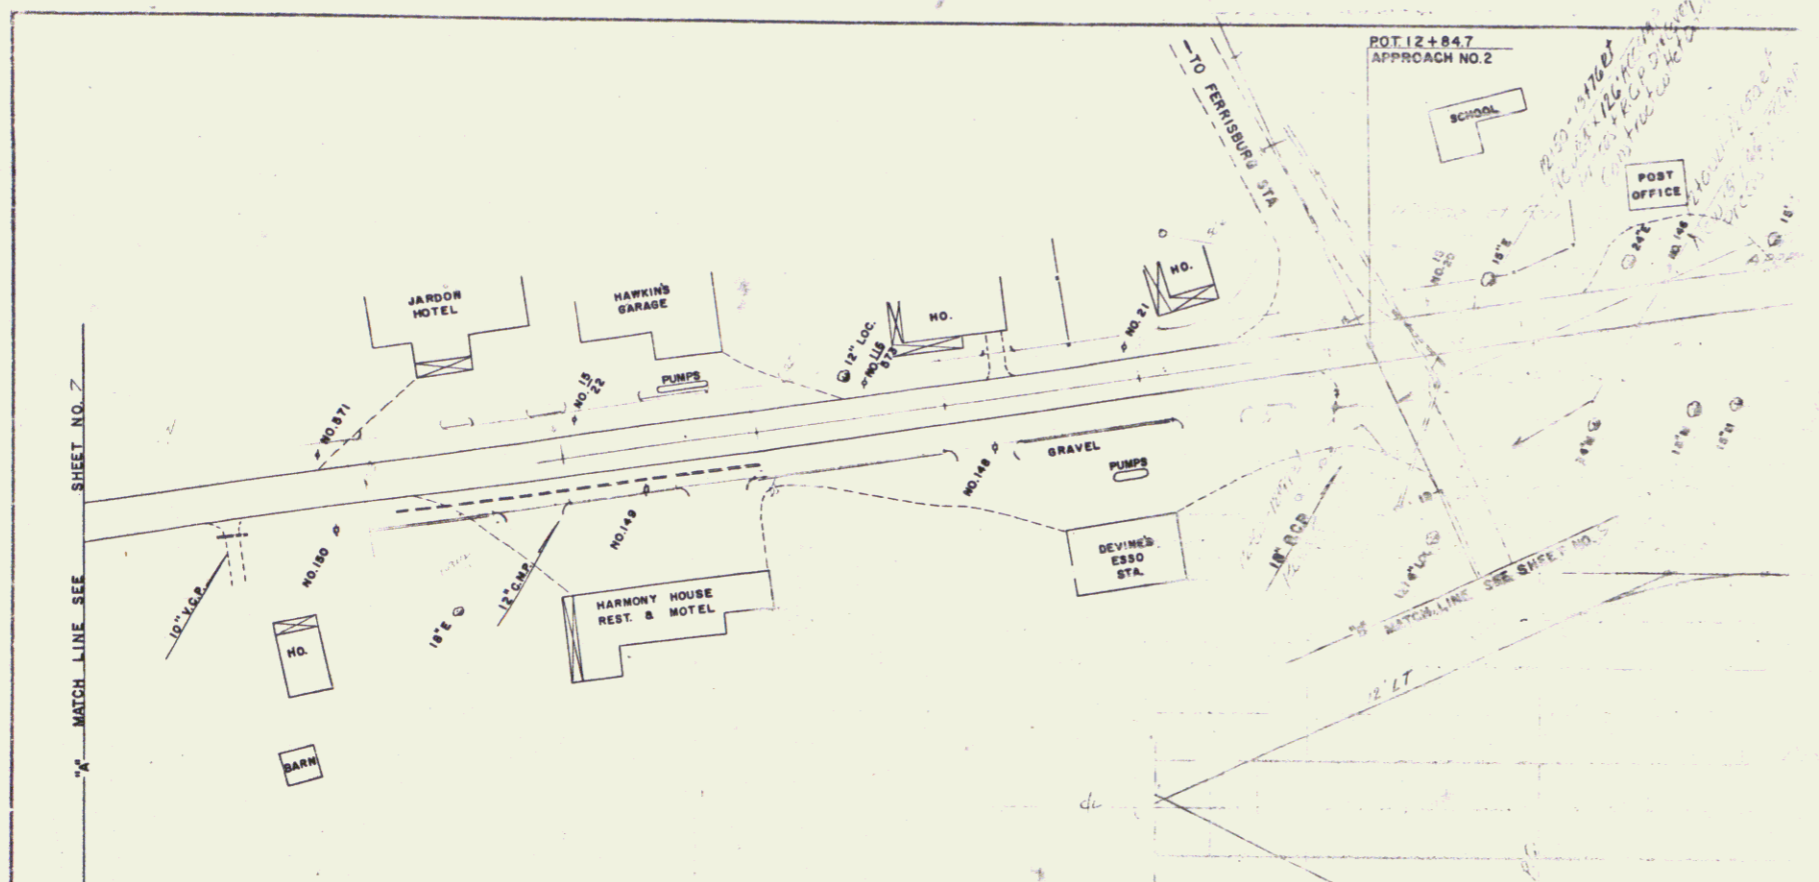

6

6