



INDEX OF SHEETS

# STATE OF VERMONT DEPARTMENT OF HIGHWAYS PROPOSED IMPROVEMENT

FEDERAL AID PROJECT

## TOWN OF FERRISBURG COUNTY OF ADDISON U.S. ROUTE 7 CHARLOTTE - VERGENNES ROAD

BEGINNING AT A POINT 9,799.0 FEET FROM THE VERGENNES -  
FERRISBURG TOWN LINE AND EXTENDING NORTHERLY 13,305.1 FEET.  
LENGTH OF PROJECT 13,305.1 FEET = 2.520 MILES

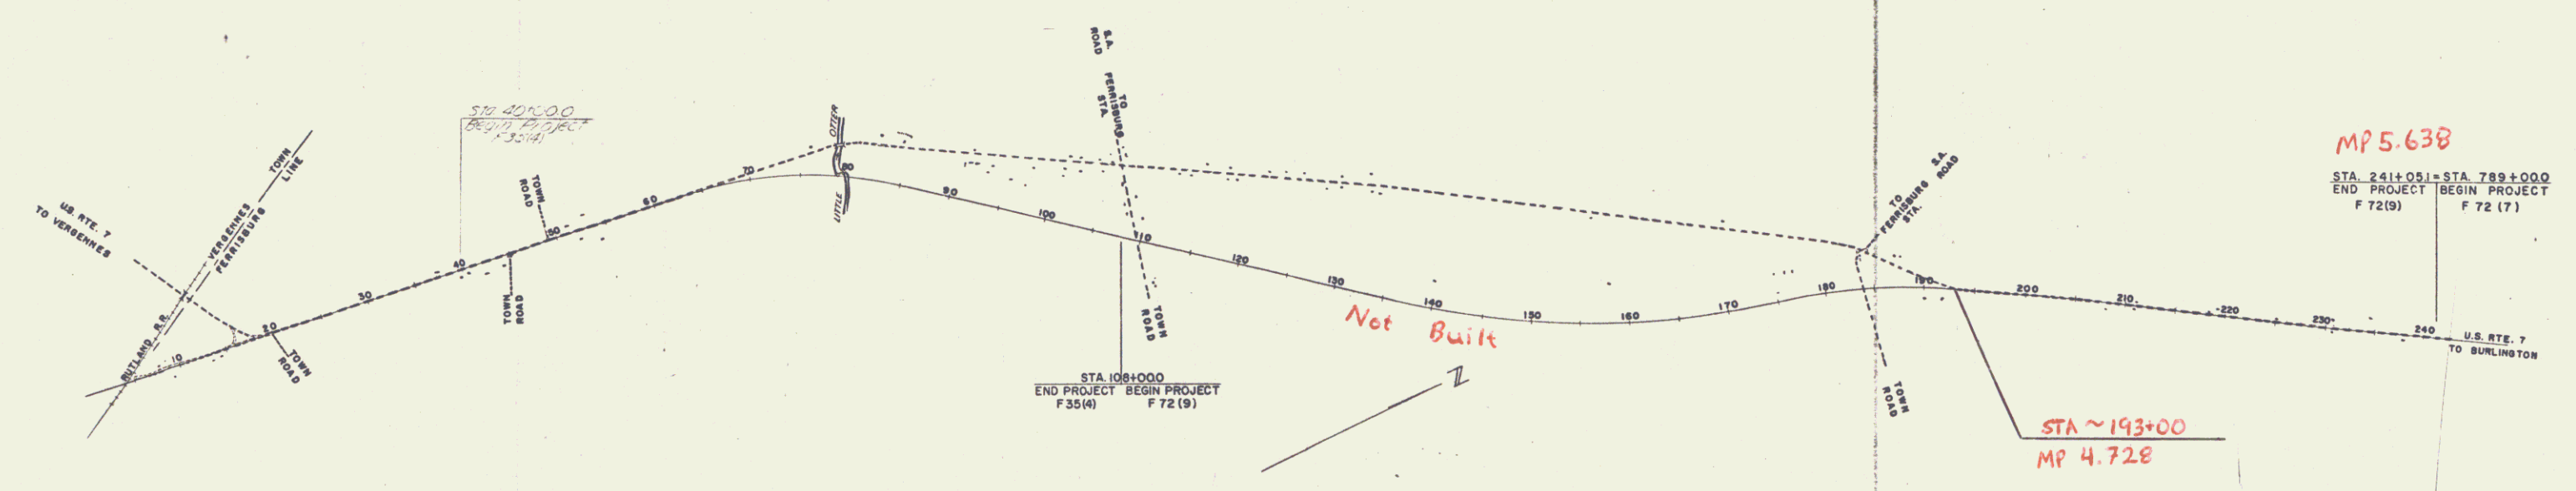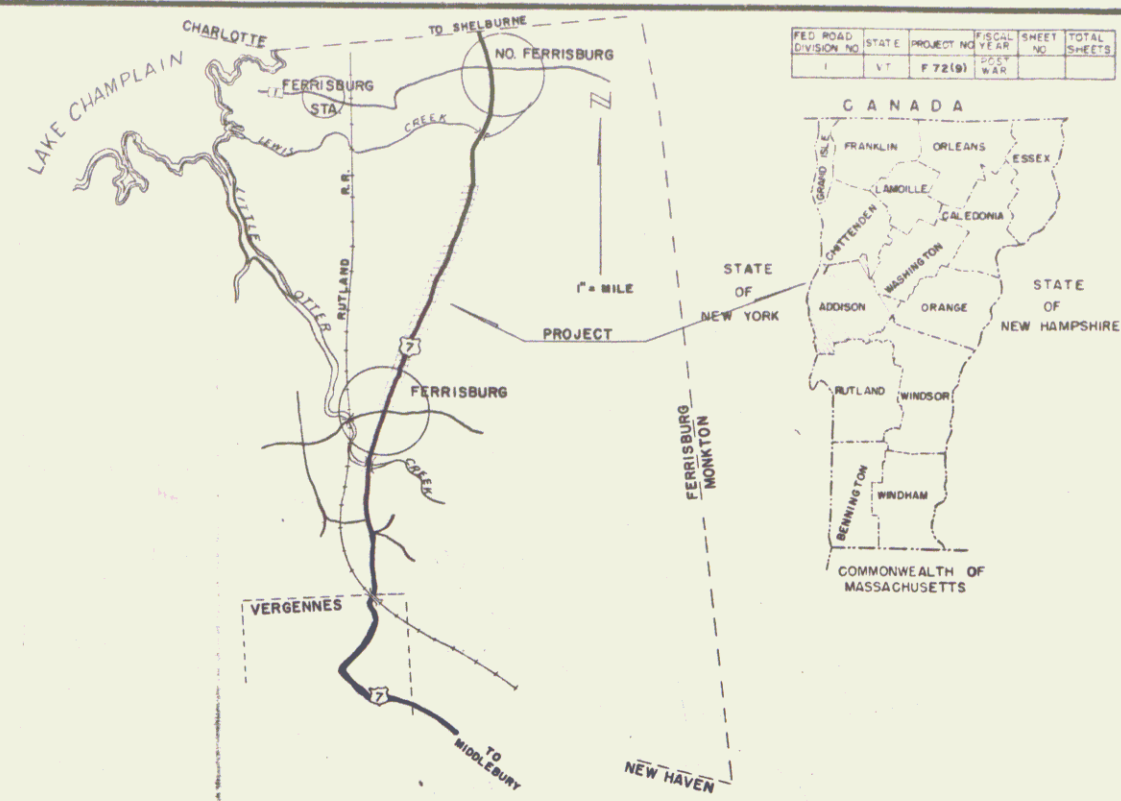

CONVENTIONAL SIGNS

COUNTY LINE	---
TOWN LINE	---
FENCE LINE	---
STONE WALL	---
UNFENCED PROPERTY	---
GUARD RAIL	---
TRAVELED WAY	---
RAILROAD	---
RETAINING WALL	---
CENTER LINE	---
SURVEY LINE	---
CULVERT	---
DROP INLET	---
TROLLEY POLE	---
POWER POLE	---
TELEPHONE POLE	---
TREES	---
HEDGE	---

CURVE DATA

DEFLECTION OF ANGLE	..... A
DEGREE OF CURVE	..... D
RADIUS OF CURVE	..... R
TANGENT DISTANCE	..... T
LENGTH OF CURVE	..... L
EXTERNAL DISTANCE	..... E
POINT OF INTERSECTION	..... P.I.
POINT OF CURVE	..... P.C.
POINT OF TANGENT	..... P.T.
POINT ON TANGENT	..... P.O.T.
POINT ON SUB-TANGENT	..... P.O.S.T.

SCALES

TITLE	1" = 800'
TYPICAL	1" = 50'
PLAN	1" = 50'
PROFILE HORIZONTAL	1" = 50'
PROFILE VERTICAL	1" = 10'
CROSS-SECTIONS	1" = 5'

THESE PLANS ARE SUBJECT TO SUCH REVISIONS AS MAY BE REQUIRED BY THE BUREAU OF PUBLIC ROADS OR THE COMMISSIONER OF HIGHWAYS.

CONSTRUCTION IS TO BE CARRIED ON IN ACCORDANCE WITH THE PLANS AND THE STANDARD SPECIFICATIONS FOR HIGHWAY AND BRIDGE CONSTRUCTION OF JANUARY 1956, SUBMITTED TO THE BUREAU OF PUBLIC ROADS FOR APPROVAL ON APRIL 9, 1956, INCLUDING ALL SUBSEQUENT APPROVED REVISIONS AND SUCH REVISED SPECIFICATIONS AND SPECIAL PROVISIONS AS ARE SUBMITTED WITH THE PLANS.

APPROVED SECONDARY ENGINEER DATE	APPROVED CONSTRUCTION ENGINEER DATE	APPROVED BRIDGE ENGINEER DATE	APPROVED DISTRICT ENGINEER DATE	APPROVED HIGHWAY ENGINEER DATE	APPROVED CHIEF ENGINEER DATE SUBMITTED BY ORDER OF THE STATE HIGHWAY BOARD
--	---	-------------------------------------	---------------------------------------	--------------------------------------	---

DEPARTMENT OF COMMERCE  
BUREAU OF PUBLIC ROADS

PROJECT F NO. 72 (9)

SHEET 1 OF SHEETS

WEBSTER-MARTIN, INC. CONSULTING ENGINEERS,  
50, BURLINGTON, VERMONT

MP 5.638

STA. 241+051 = STA. 789+000  
END PROJECT BEGIN PROJECT  
F 72 (9) F 72 (7)

Pin # 99R464

Date: 1/1/1957