
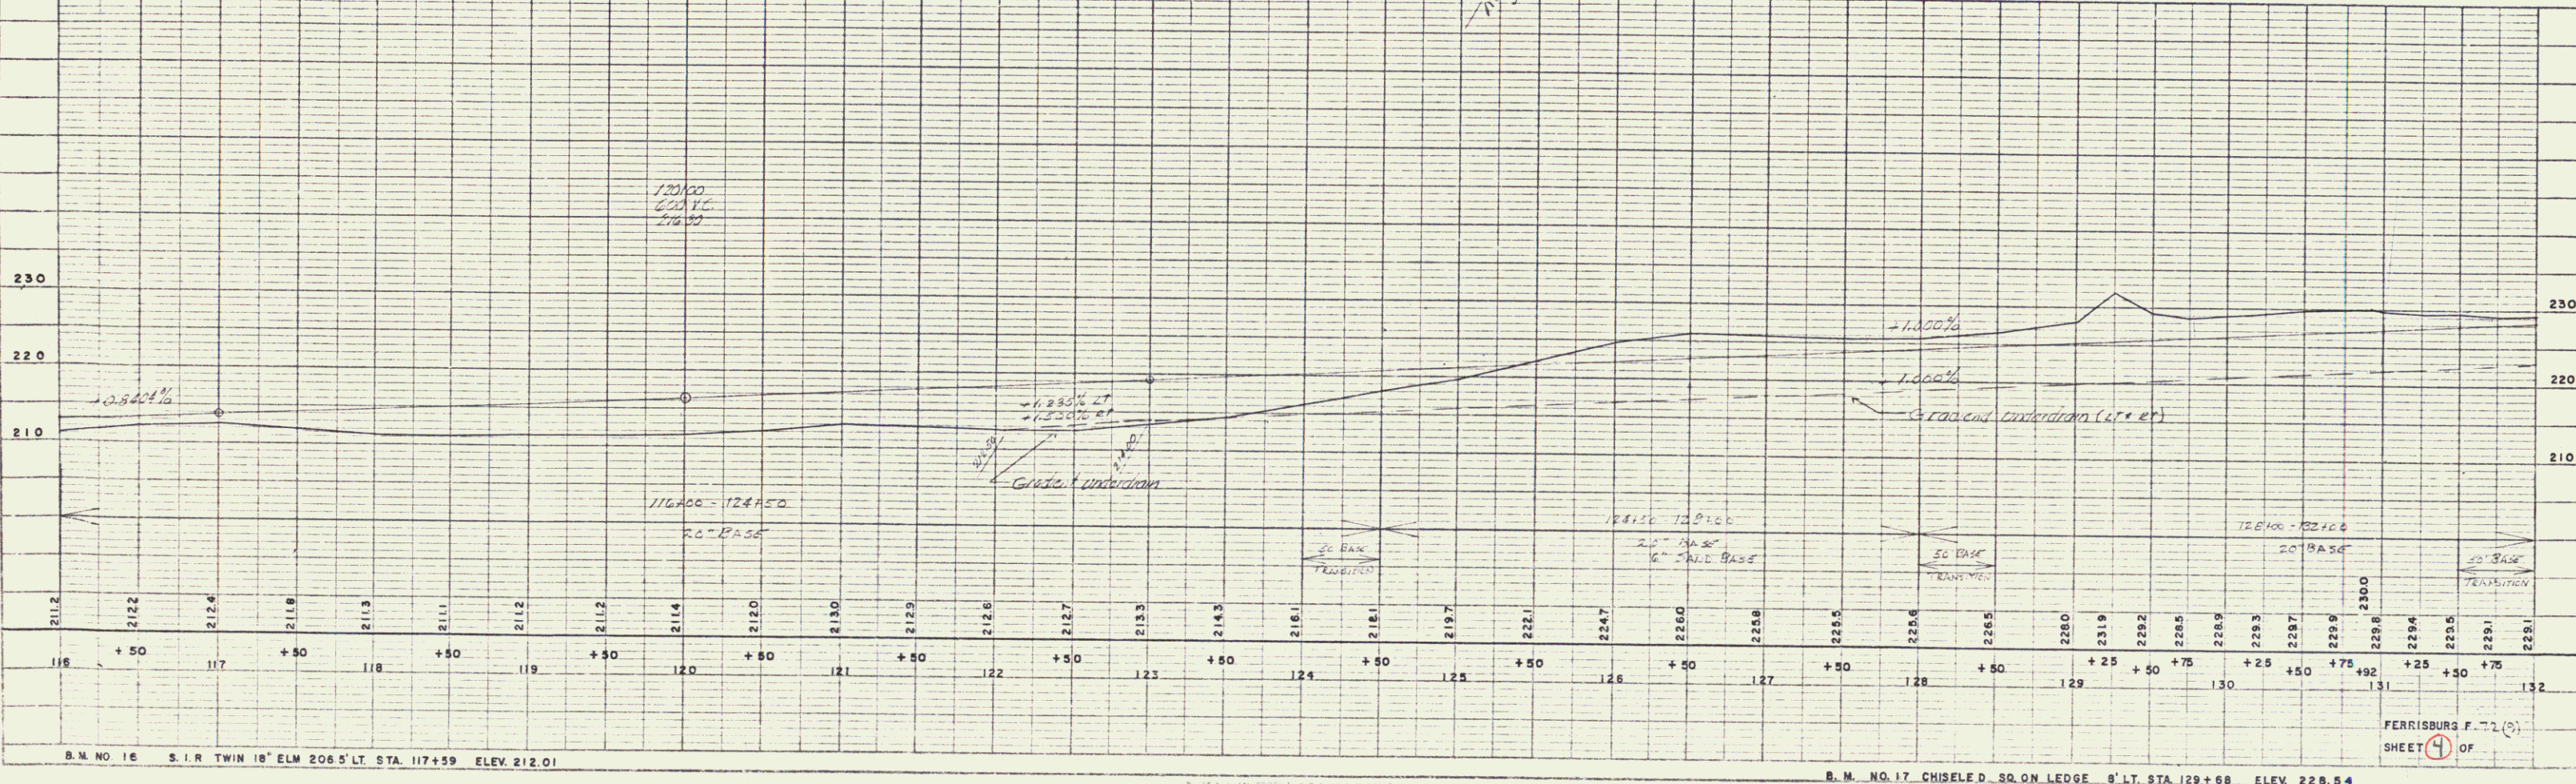


PLAN
 DESIGNED BY: WEBSTER-MARTIN, INC. 8-57
 CHECKED BY: ALUMINUM CHECKED
 DATE: 10/1/54

PROFILE
 DESIGNED BY: WEBSTER-MARTIN, INC. 8-57
 CHECKED BY: ALUMINUM CHECKED
 DATE: 10/1/54

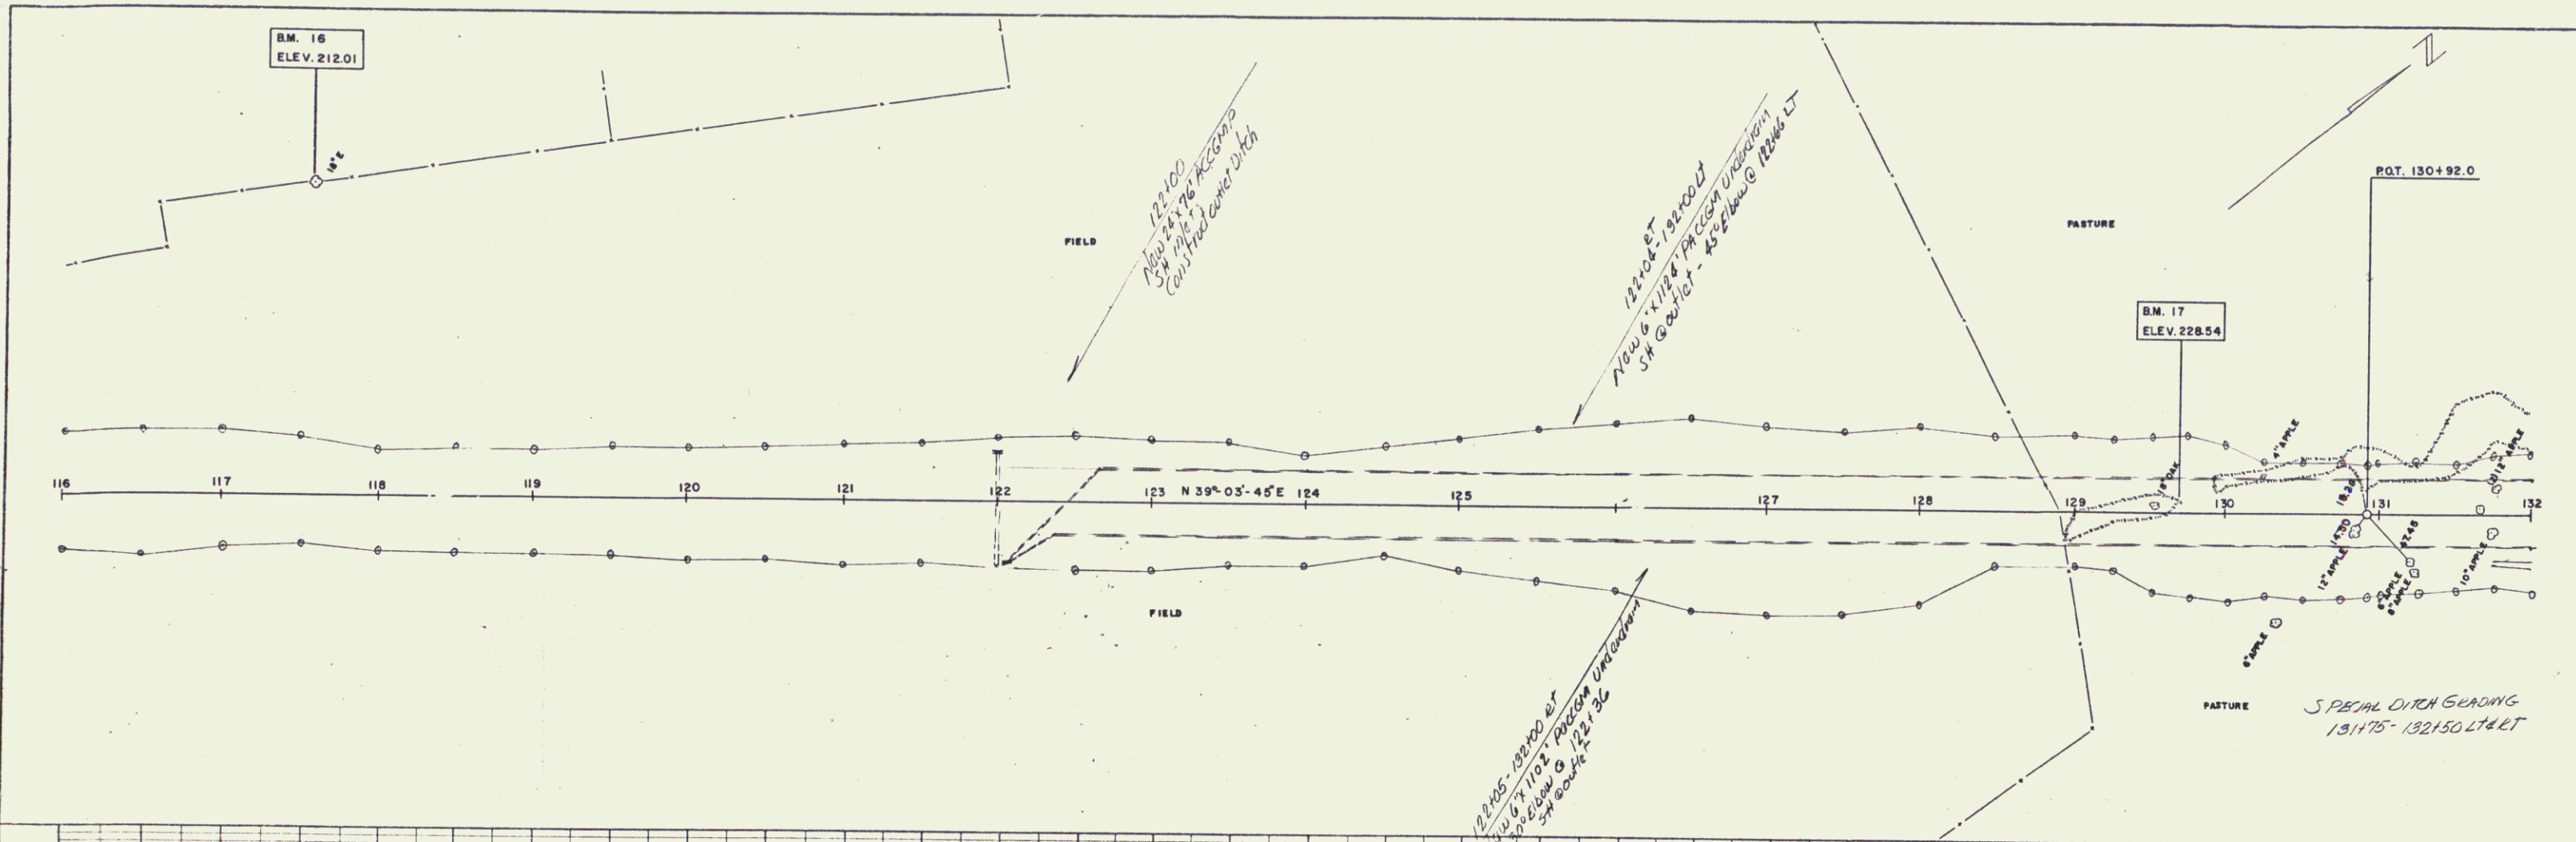

B.M. NO. 16 S.I.R. TWIN 18\"/>

B.M. NO. 17 CHISELED SQ. ON LEDGE 8\"/>

PLATE 1 - PLAN PROFILE OF PARALLEL ROAD
 HOFFER & BENDER CO. NEW YORK
 10/1/54

FERRISBURG F. 71 (5)
 SHEET 4 OF