
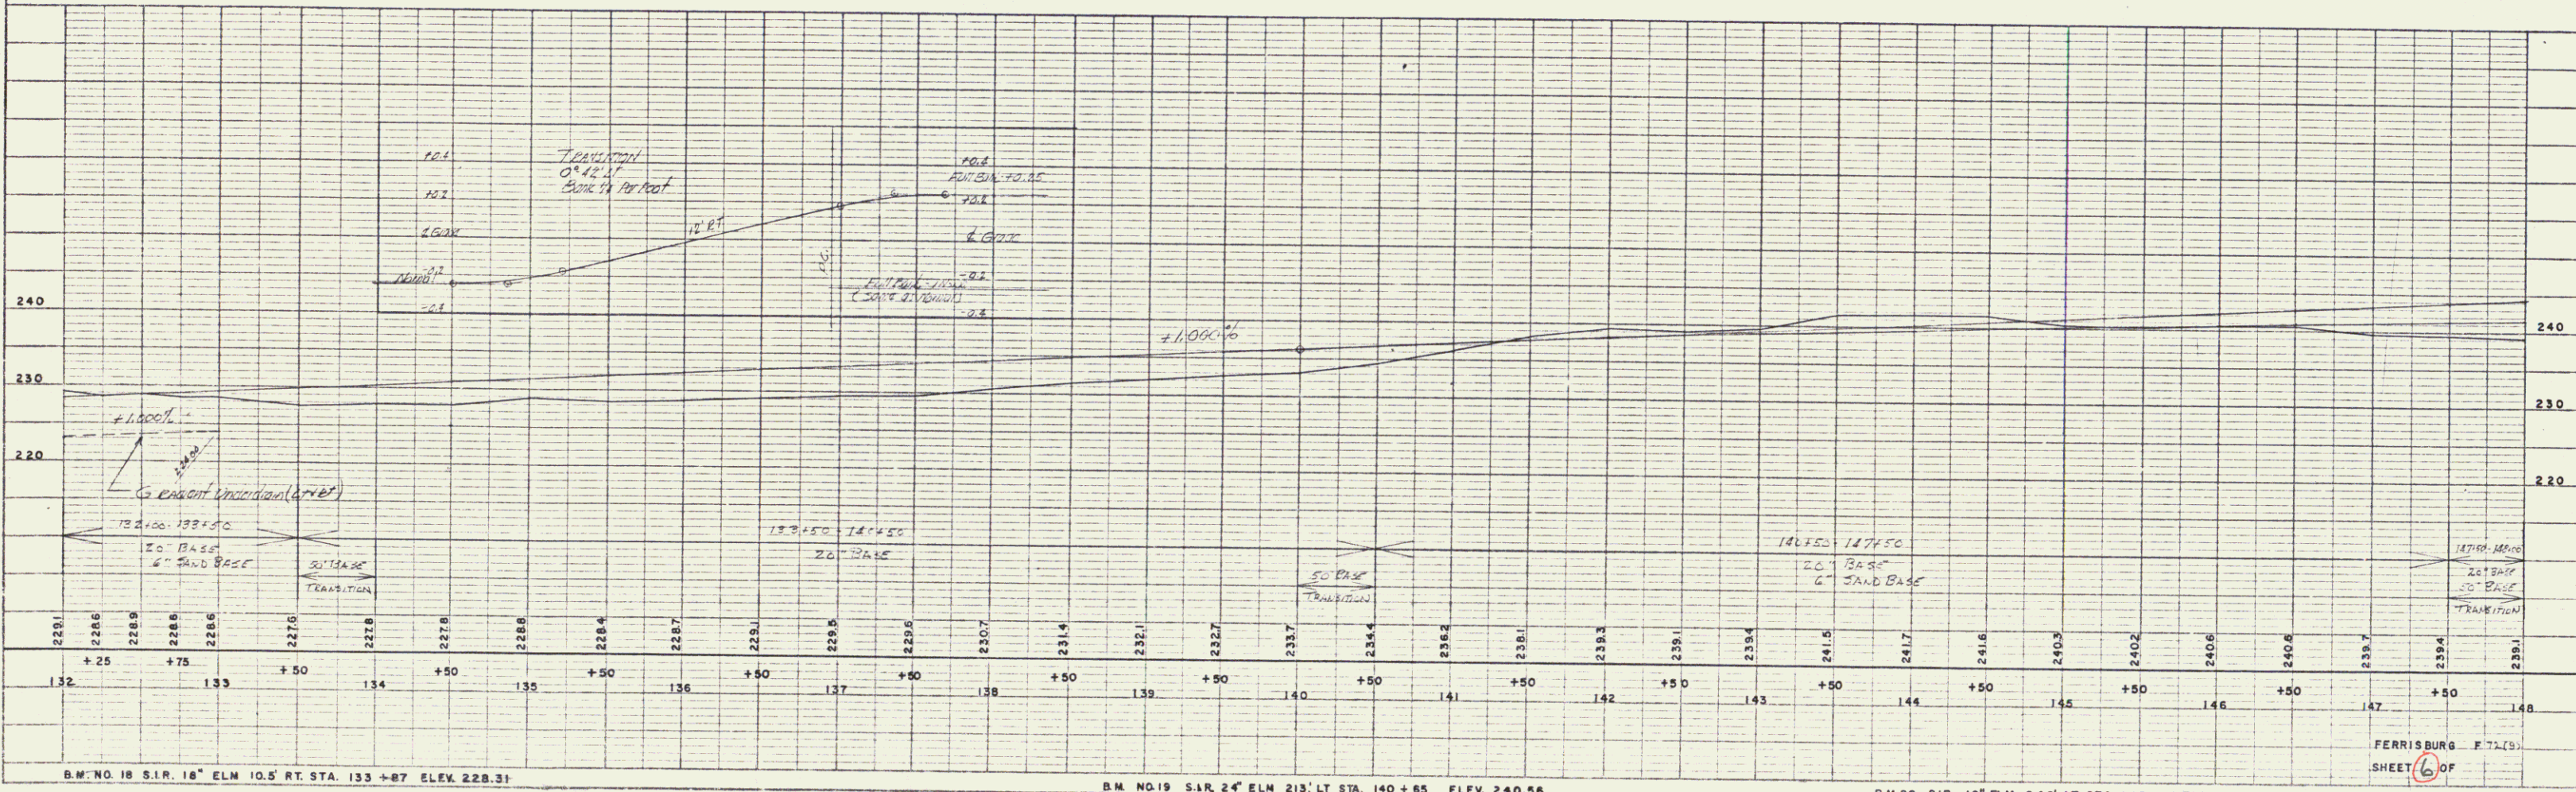


PLAN
 SHEETED BY: WEBSTER-MARTIN, INC. P-57
 CHECKED BY: WEBSTER-MARTIN, INC. P-57
 DATE: 10/1/00
 NOTE: BOOK CHANGES CHECKED
 SET OF MAP CHECKED

PROFILE
 SHEETED BY: WEBSTER-MARTIN, INC. P-57
 CHECKED BY: WEBSTER-MARTIN, INC. P-57
 DATE: 10/1/00
 NOTE: BOOK CHANGES CHECKED
 SET OF MAP CHECKED

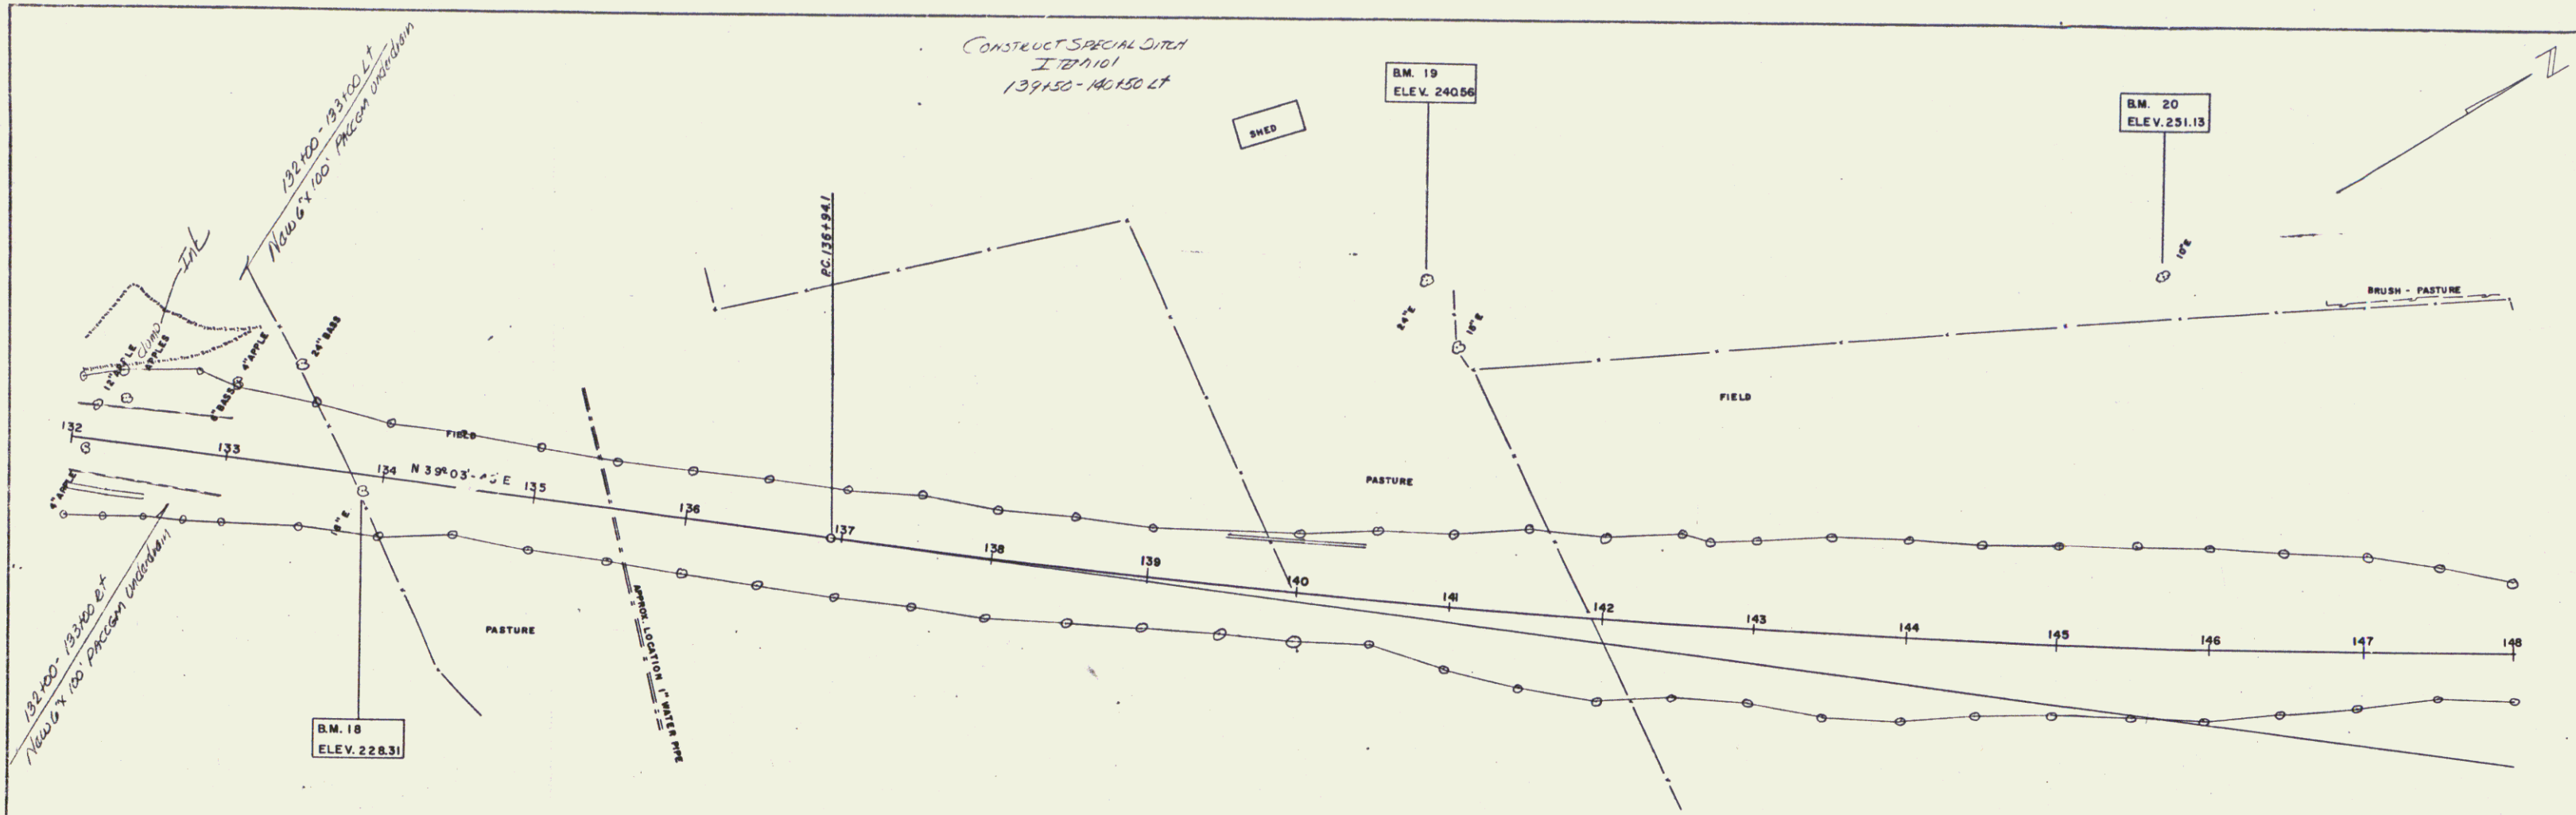

B.M. NO. 18 S.I.R. 16" ELM 10.5' RT. STA. 133 +87 ELEV. 228.31
 B.M. NO. 19 S.I.R. 24" ELM 213' LT. STA. 140 +65 ELEV. 240.56
 B.M. NO. 20 S.I.R. 10" ELM 246' LT. STA. 145 +60 ELEV. 251.13
 FERRISBURG E.T.L.(S)
 SHEET 6 OF

60