
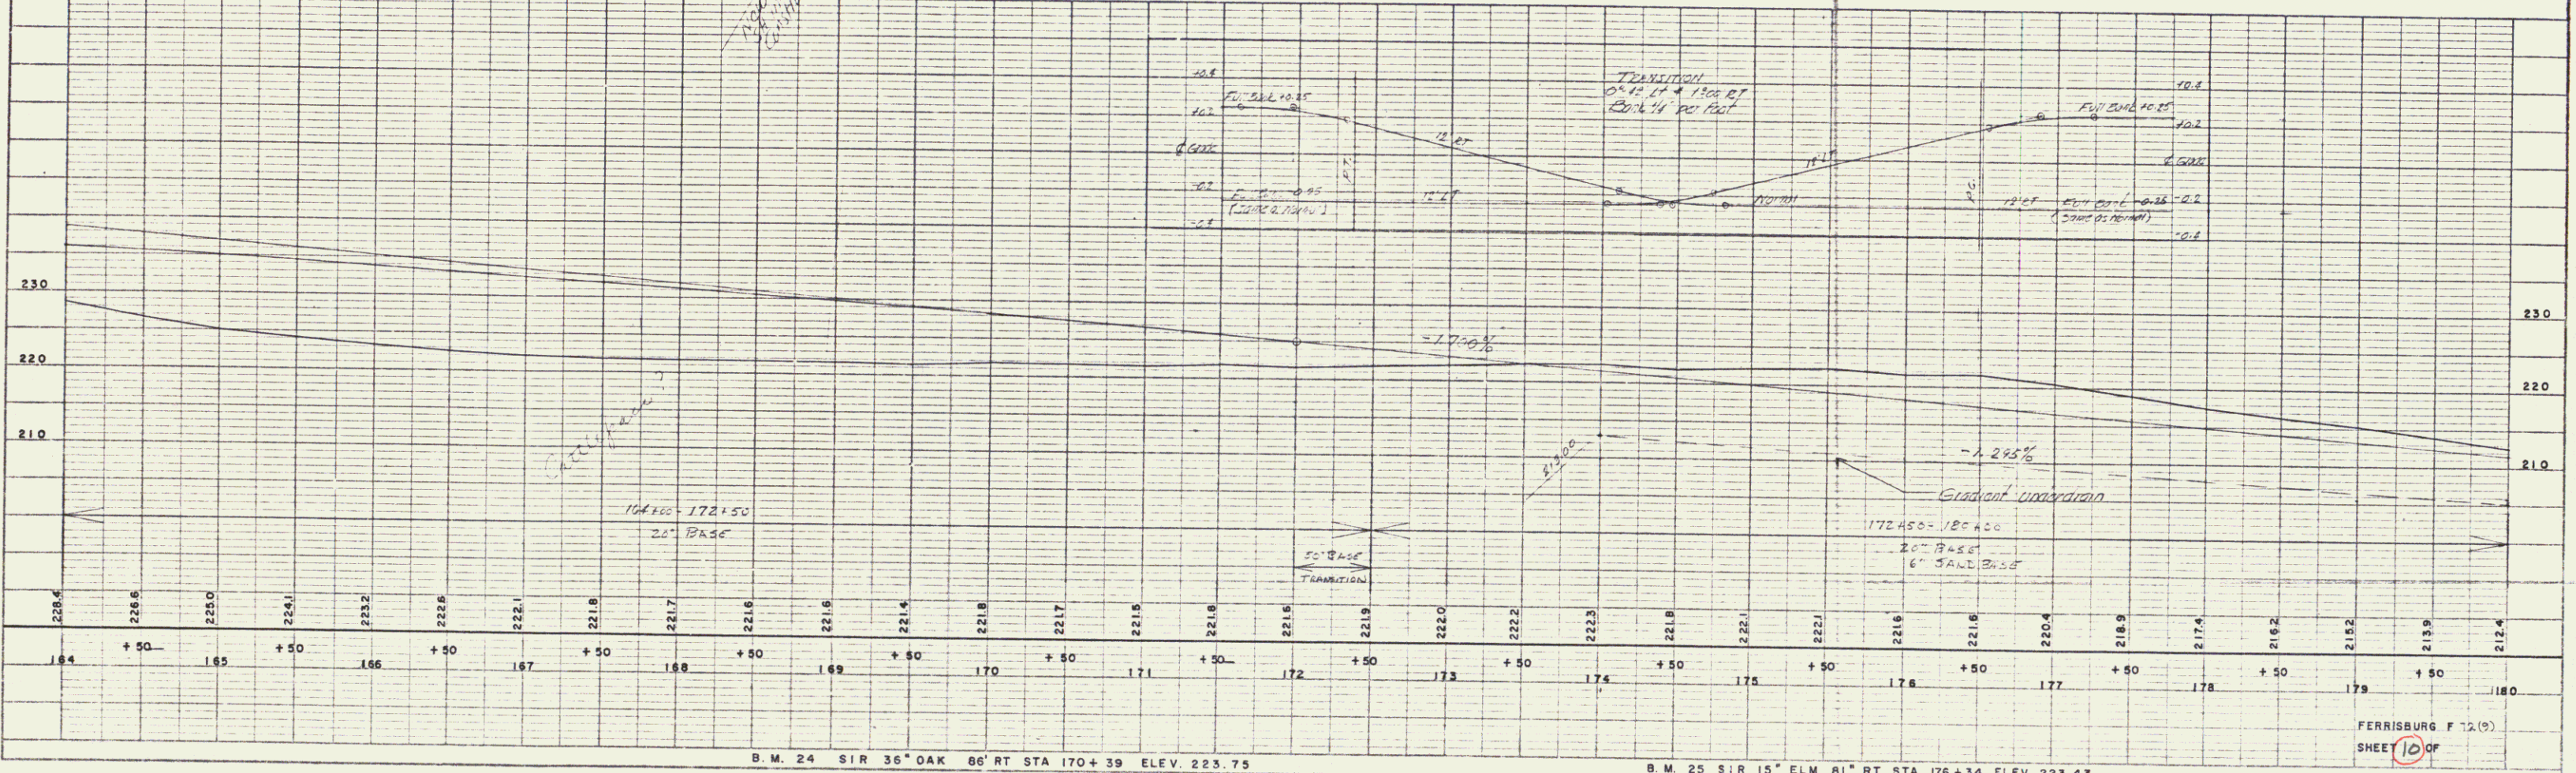


PLAN  
 SHEET NO. 10  
 DATE BOOK 11/21/1954  
 PROJECT  
 WEBSTER-MARTIN INC.  
 1000  
 1000  
 1000

PROFILE  
 SHEET NO. 10  
 DATE BOOK 11/21/1954  
 PROJECT  
 WEBSTER-MARTIN INC.  
 1000  
 1000  
 1000

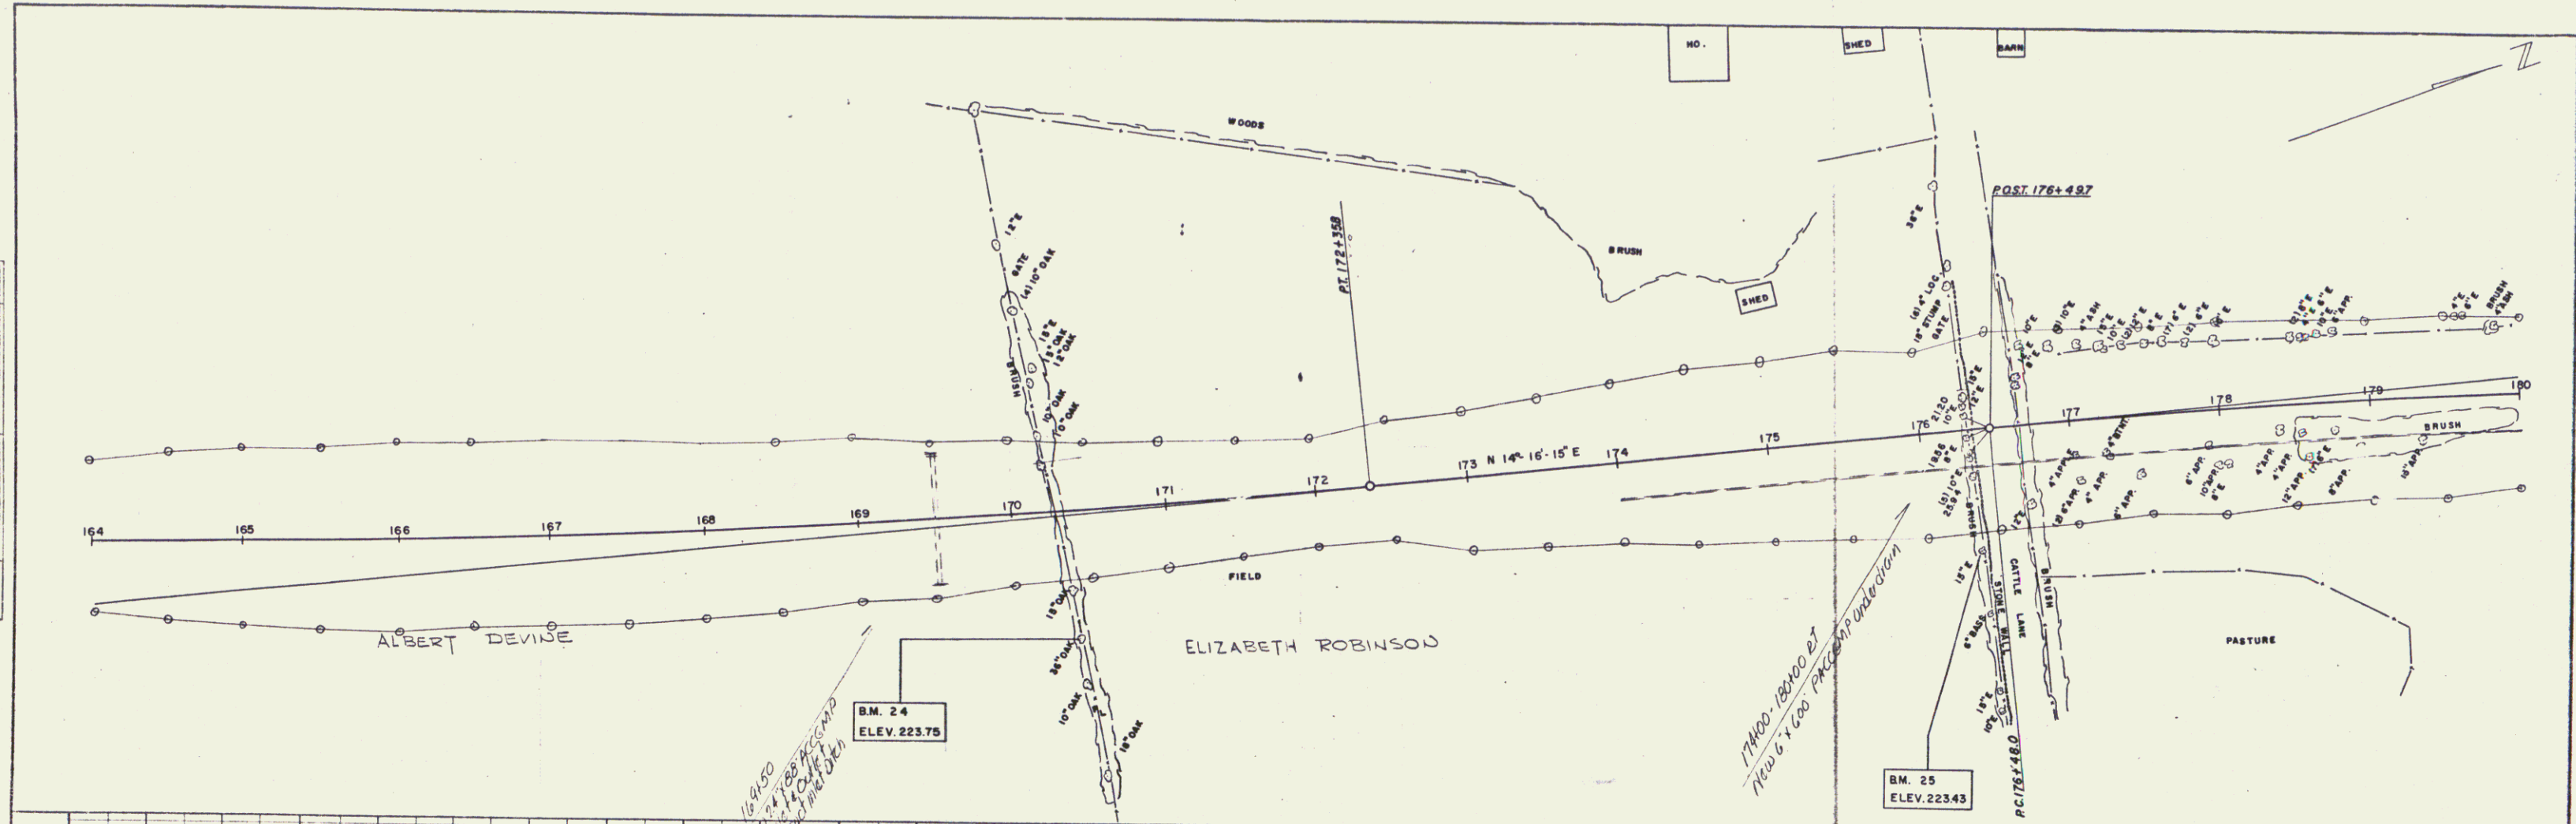

B.M. 24 SIR 36" OAK 86' RT STA 170+39 ELEV. 223.75  
 B.M. 25 SIR 15" ELM 81' RT STA 176+34 ELEV. 223.43

FERRISBURG F 12. (9)  
 SHEET 10 OF 10

10