
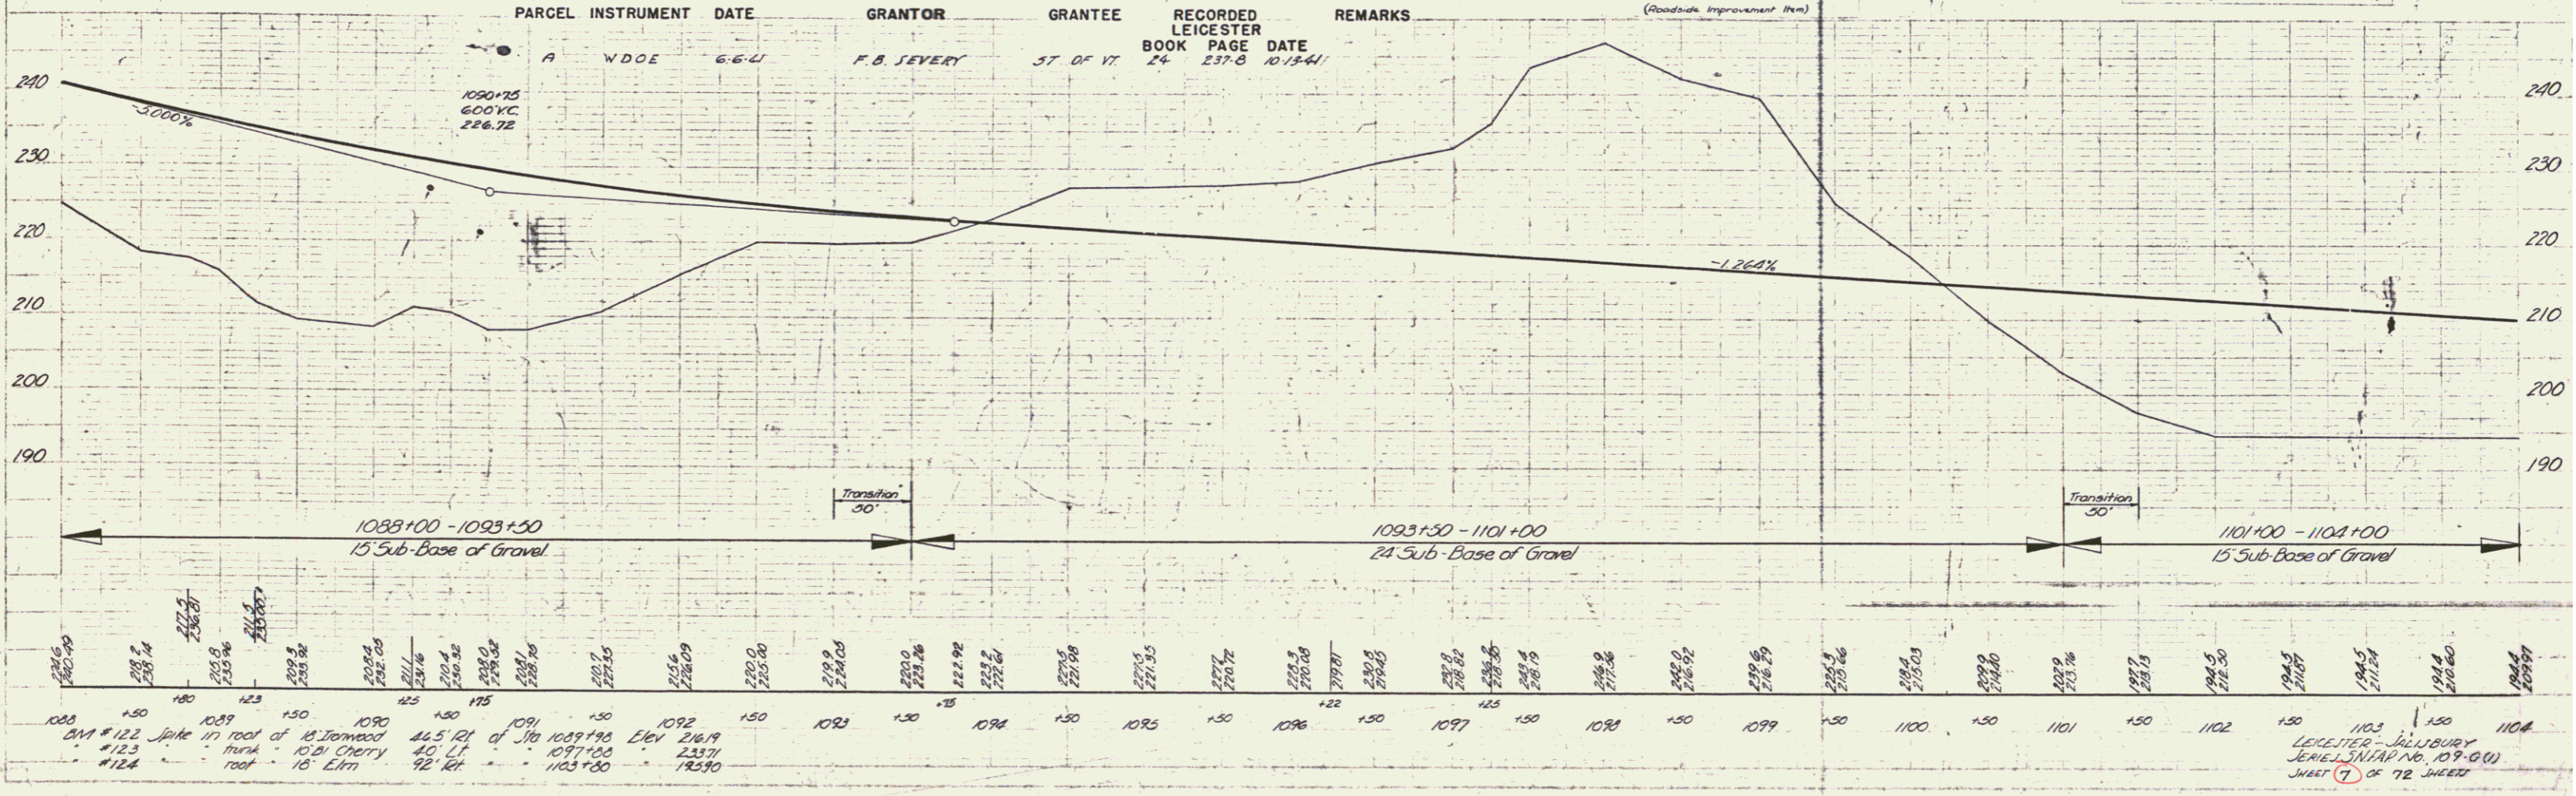


Reference Sheet  
 For Proj BMA 67-18  
 Sheet 8 & 17

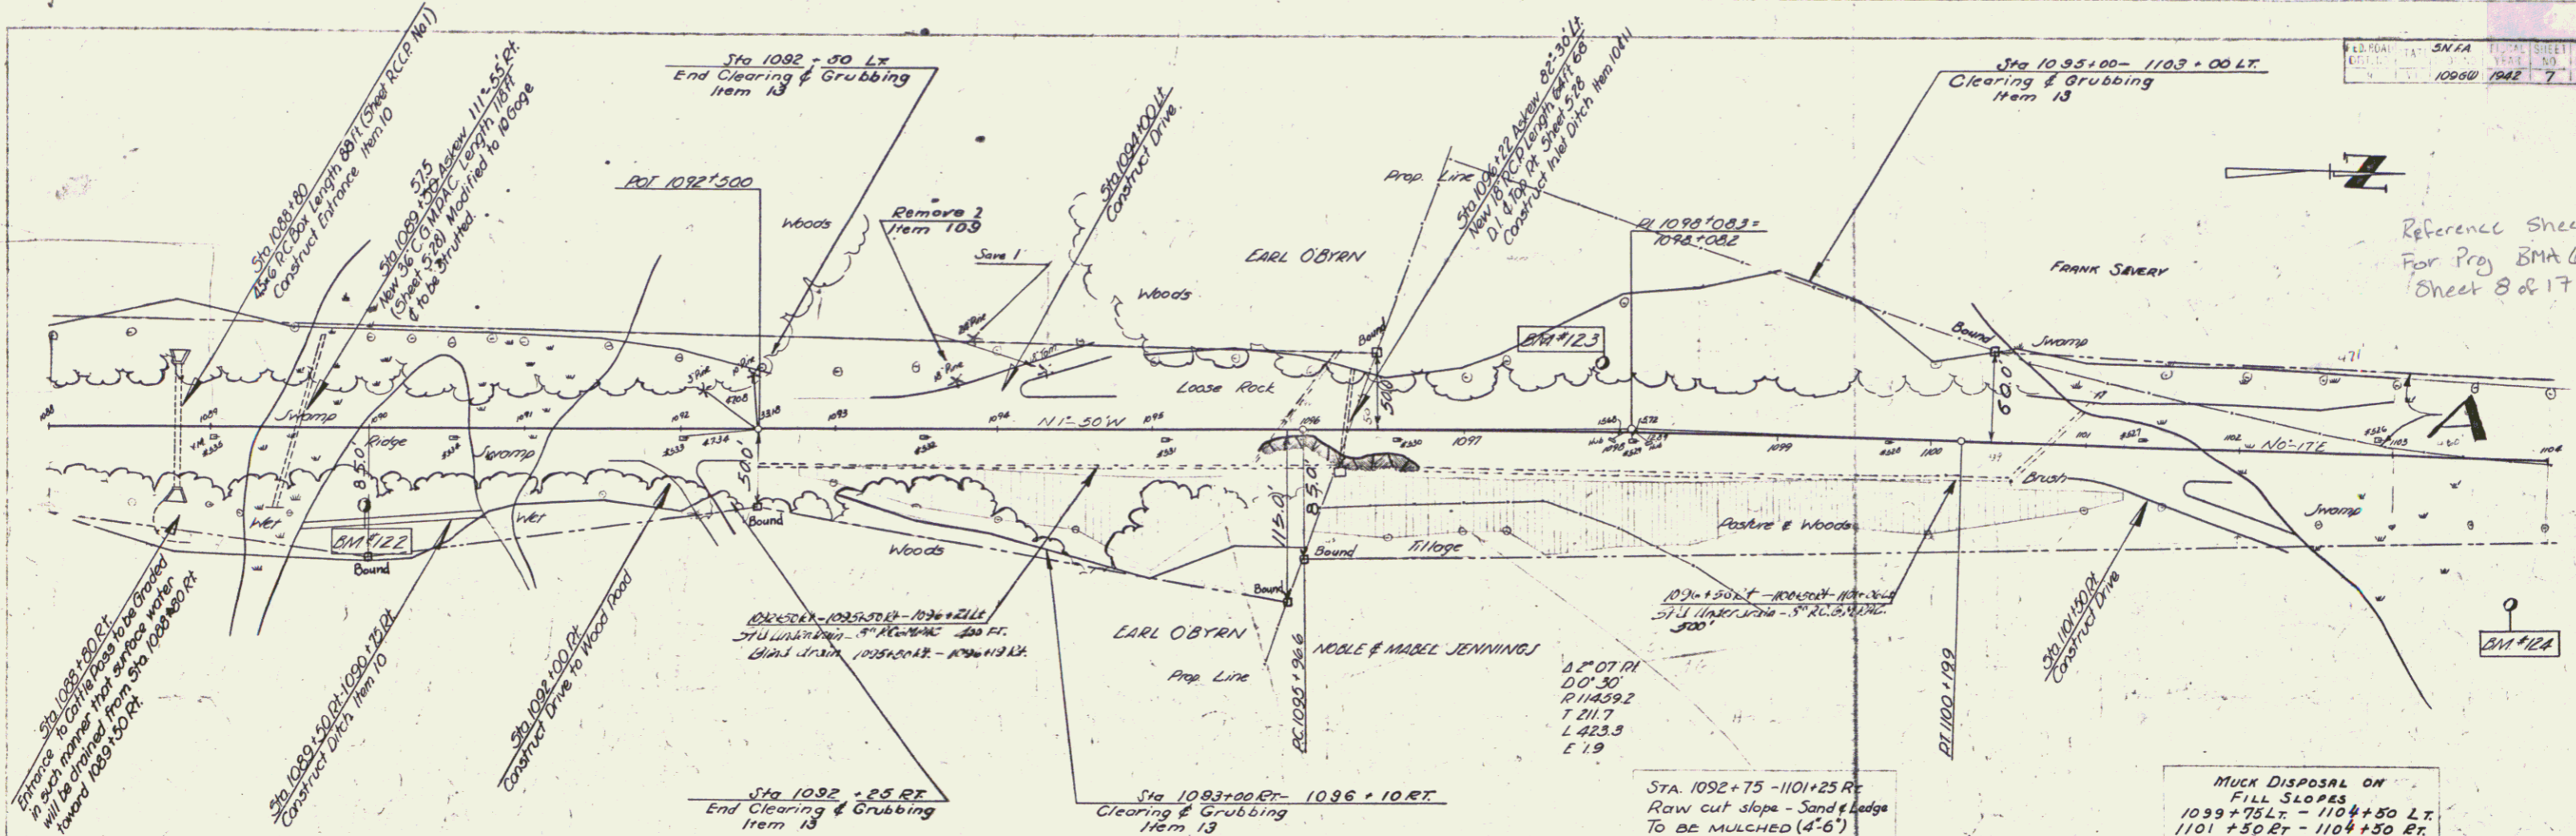

STATION	ELEVATION	REMARKS
1088	230.4	BM #122 Spike in roof of 18 Jarwood
1089	228.4	mark 10 21 Cherry
1090	228.8	root 16 Elm
1091	228.8	
1092	228.8	
