



Sta. 1152+50 3" Water pipe sleeve to be placed under roadway. The exact location and depth to be agreeable to the Owner. The pipe to be paid for as an extra work item and necessary excavation and for as Trench Excavation.

8" MUCK DISPOSAL ON FILL SLOPES  
 1151+50 Lt. - 1167+0 Lt.  
 1152+50 Rt. - 1159+50 Rt.  
 1162+0 Rt. - 1167+0 Rt.

PLANNED STATE S.M.A. 1942  
 E. STATE 1942  
 10960 1942 11 72

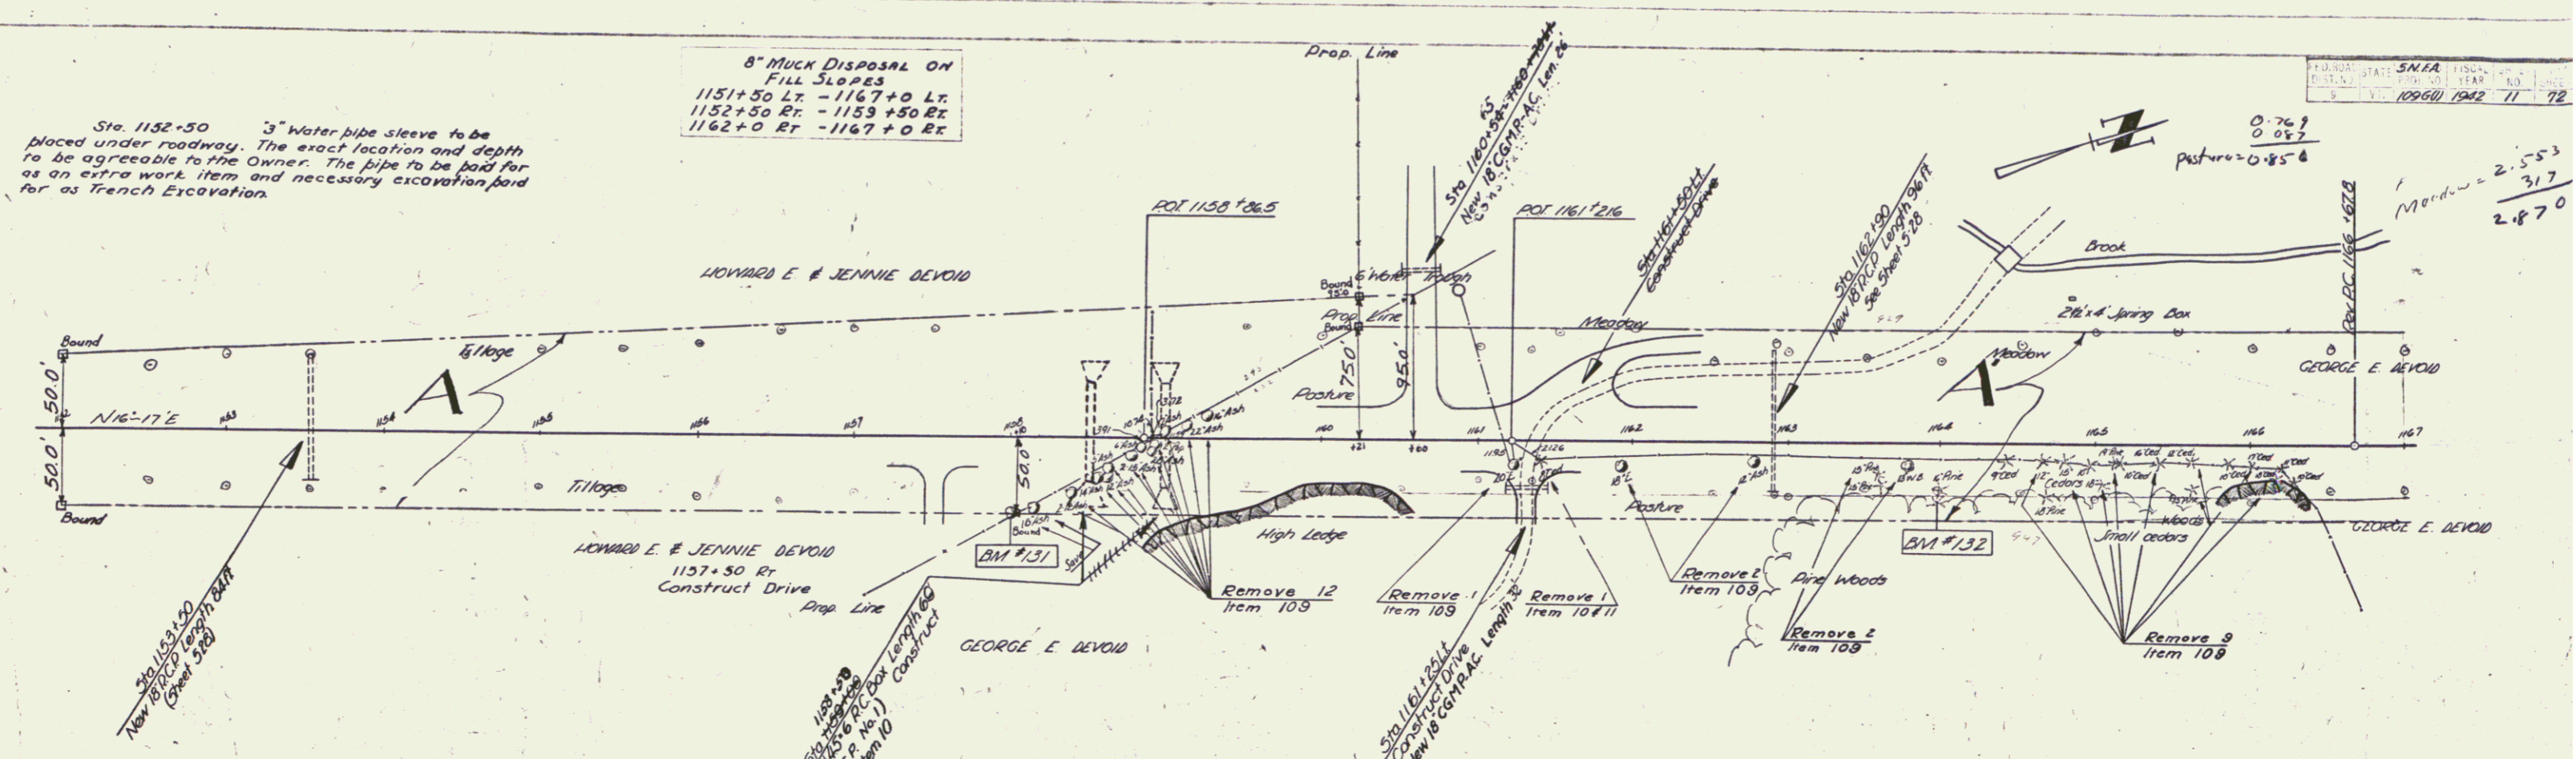

PARCEL	INSTRUMENT	DATE	GRANTOR	GRANTEE	RECORDED SALISBURY BOOK PAGE DATE	REMARKS
A	CONDEM	5-2-41	HOWARD E. & JENNIE DEVOID	ST. OF VT.	19 372-78 5-2-41	
A	CONDEM	5-2-41	GEORGE DEVOID	ST. OF VT.	19 372-78 5-2-41	

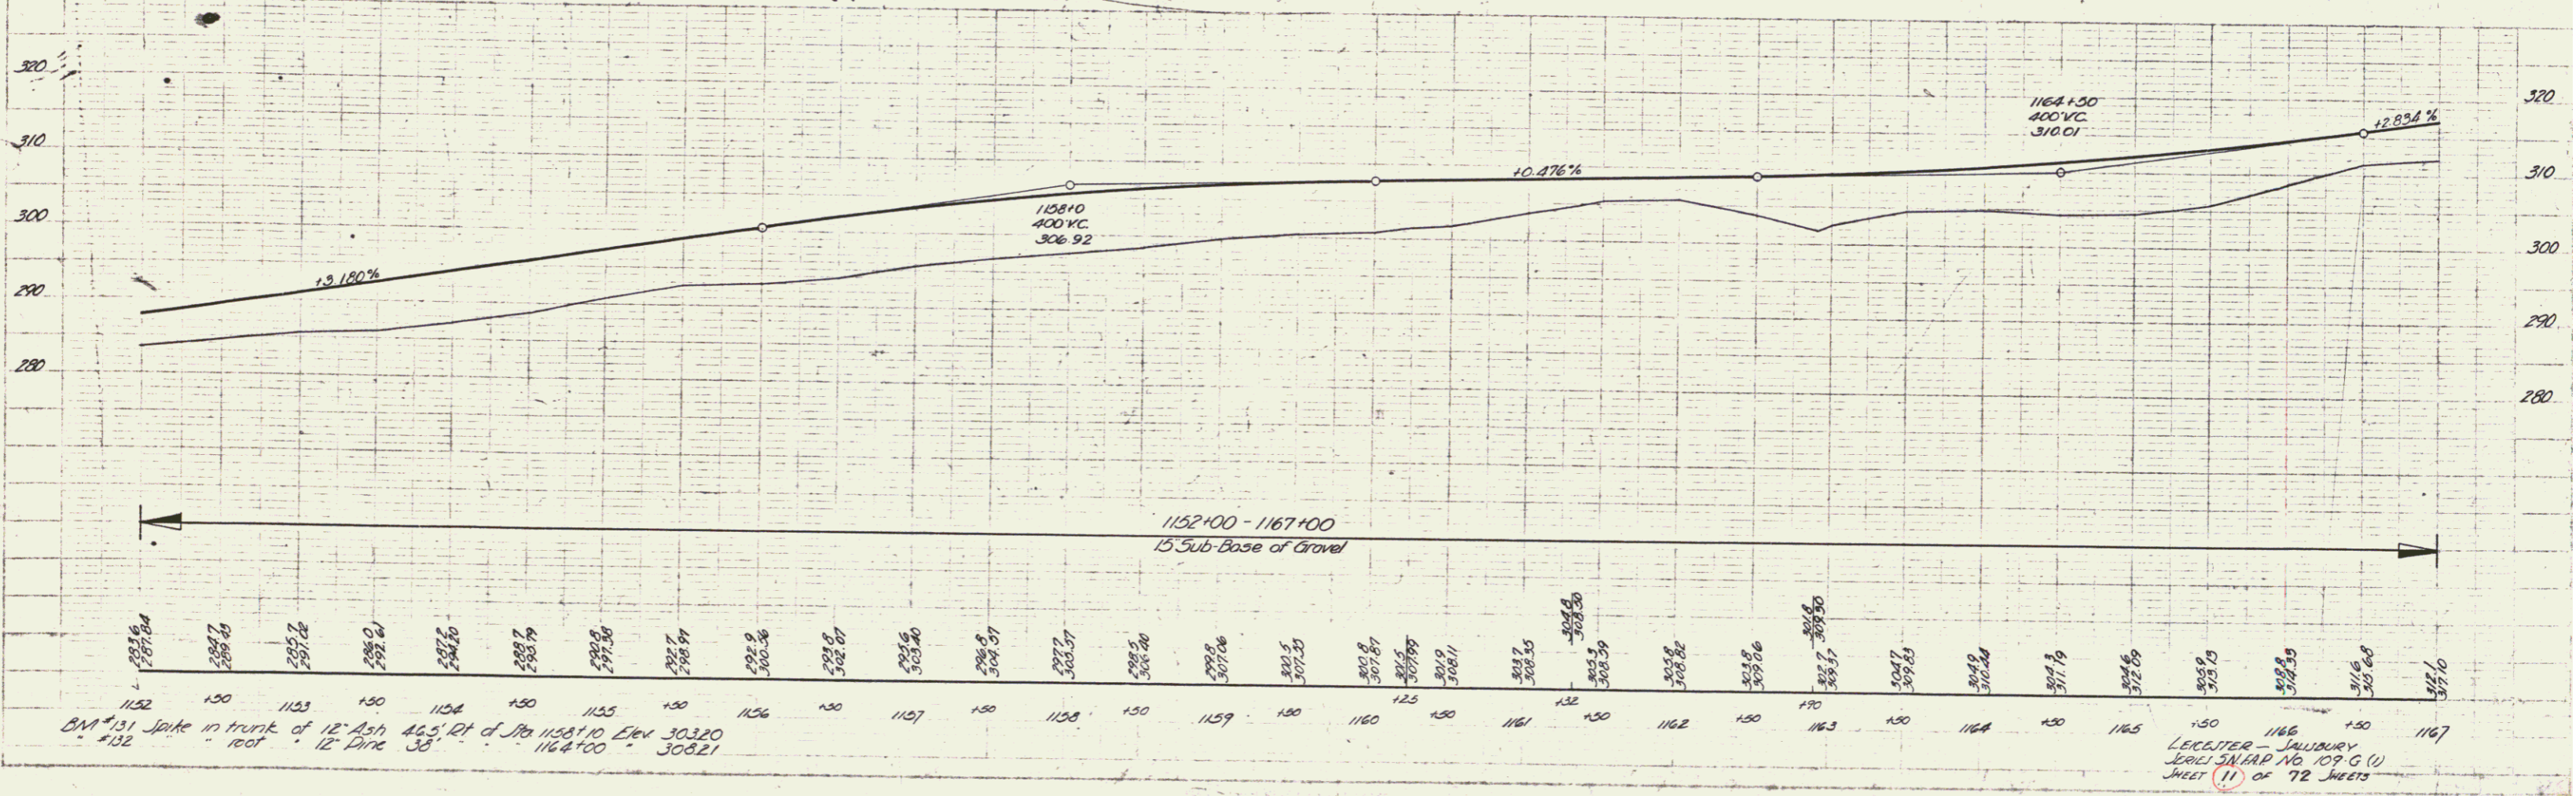

S. L. LORAIN  
 L. LORAIN  
 L. LORAIN

LEICHTER - SALISBURY  
 SERIAL SURVAY NO. 109 G (U)  
 SHEET (11) OF 72 SHEETS