

INDEX OF SHEETS

SHEET NO.	TITLE PAGE
1	TITLE PAGE
2	TYPICAL CROSS-SECTIONS OF IMPROVEMENT (BITUMINOUS CONCRETE PAVEMENT, ITEM 361-B MOD.)
3-4	ITEM QUANTITY SHEETS
5	ITEM DRAINAGE SHEET
6-7	EARTHWORK SHEETS (HWY)
8	EARTHWORK SHEET (CHANNEL)
9-14	PLAN AND PROFILE SHEETS
15	GENERAL PLAN (BRIDGE)
16	PRELIMINARY INFORMATION SHEET (BRIDGE)
17	ABUTMENT PLAN AND PYLON DETAILS
18	PIER DETAILS
19	FRAMING AND DECK PLANS
20	REINFORCING SCHEDULE
21	BRIDGE STANDARD SHEET SCB-30-60
22	BRIDGE STANDARD SHEET SCB-D-60
23	BRIDGE STANDARD SHEET SB-50-60 SHEET 1 OF 2 - CURB AND ALUM. RAILING DETAILS
24	BRIDGE STANDARD SHEET SB-50-60 SHEET 2 OF 2 - ALT. GALV. METAL RAILING DETAILS
25	BRIDGE STANDARD SHEET SB-20-60, DETAILS B, C, E, F OR G, H & K.
26	BRIDGE STANDARD SHEET SB-22-60, ENTIRE SHEET (EXPANSION JOINTS OVER PIERS)
27	BRIDGE STANDARD SHEET SB-AS-50, SKETCH PLAN 30' RDWY, VIEW A-A & DETAILS (APPROACH SLABS)
28	ROADWAY STANDARD SHEET A-61 DRILLING AND BLASTING OF SOLID ROCK SUBGRADE
29	ROADWAY STANDARD SHEET B-1 BANKING TABLES
30	ROADWAY STANDARD SHEET B-5 TYPICAL SLOPE GRADING
31	ROADWAY STANDARD SHEET B-16 DIVISIONAL ISLAND DESIGN
32	ROADWAY STANDARD SHEET C-1 CURBING
33	ROADWAY STANDARD SHEET D-1 PRECAST REINFORCED CONC. PIPE DROP INLETS
34	ROADWAY STANDARD SHEET D-2 CEMENT RUBBLE MASONRY
35	ROADWAY STANDARD SHEET D-3 GUTTERS
36	ROADWAY STANDARD SHEET D-4 FLUSHING BASINS
37	ROADWAY STANDARD SHEET E-1 BARRICADES, SIGNS AND LIGHTS (ROADWAY)
38	ROADWAY STANDARD SHEET G-3 THREE CABLE GUARD RAIL WITH STEEL POSTS
38-A	ROADWAY STANDARD SHEET G-4 MARKERS (WOOD & STEEL)
38-B	ROADWAY STANDARD SHEET J-1 MARKERS (PROJECT AND BOUNDARY)
39-40	GROSS SECTIONS
50-59	CHANNEL SECTIONS
27-A & 27-B	R.C.C.P. - 8-62 STA. 1331+50
27-C	R.C.C.P. - 8-62 STA. 1354+25
37-A	BRIDGE STANDARD SHEET D-8
36-A	ROADWAY STANDARD SHEET D-8
36-B	ROADWAY STANDARD SHEET D-11

REINFORCED CONCRETE DROP INLETS
DETAILS OF GRATES & COVERS FOR DROP INLETS

STATE OF VERMONT
DEPARTMENT OF HIGHWAYS
PROPOSED IMPROVEMENT


TOWNS OF SALISBURY AND MIDDLEBURY
COUNTY OF ADDISON
U.S. ROUTE 7
BRANDON - MIDDLEBURY ROAD

FEDERAL AID PROJECT

BEGINNING AT A POINT IN THE TOWN OF SALISBURY 3.964 MILES NORTHERLY OF THE LEICESTER - SALISBURY TOWN LINE AND EXTENDING NORTHERLY 1.610 MILES, INCLUDING BRIDGE.

LENGTH OF ROADWAY 8,298.70 FEET = 1.572 MILES
LENGTH OF BRIDGE 202.00 FEET = 0.038 MILES
LENGTH OF PROJECT 8,500.70 FEET = 1.610 MILES

DESIGNATION	DESIGNATION
AGT (1955)	2400
AGT (1975)	4100
DHV (1975)	570
D	55 %
T	8 %
V	60 MPH

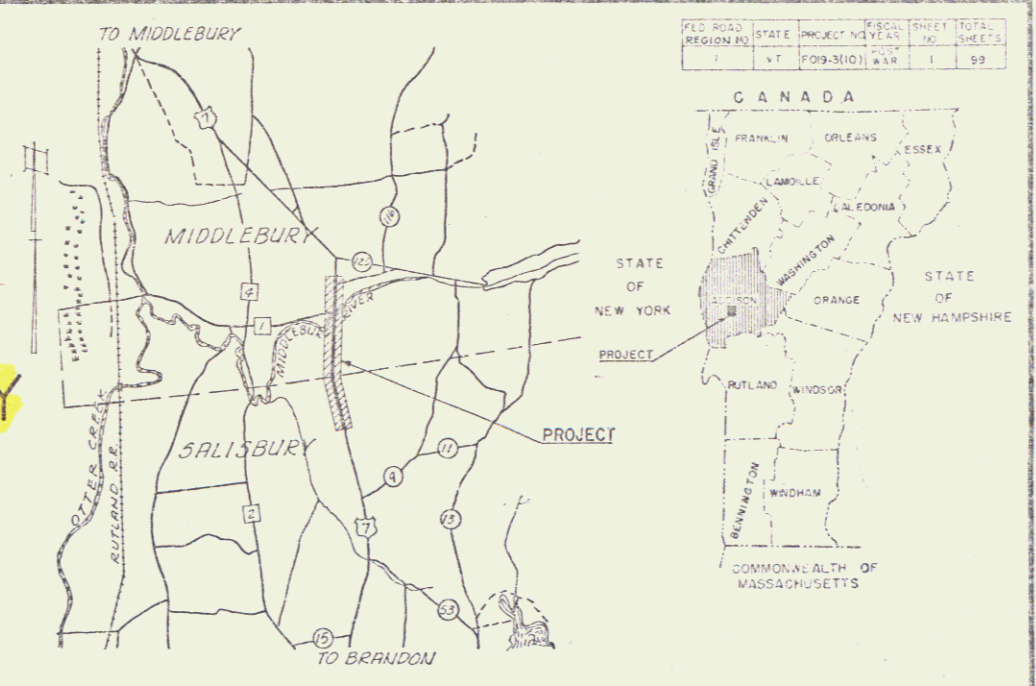

PROJECT NAME & NUMBER TYPE PAVEMENT AREA
SALISBURY-MIDDLEBURY F019-31(0) BIT. CONC. PAV'T. 22,669 S.Y.

RECORD PLANS

MATERIALS

SUBBASE OF GRAVEL - FOSTER PIT - MIDDLEBURY, VERMONT.
SUBBASE OF SAND - WHITNEY PIT - SALISBURY, VERMONT.
CRUSHED GRAVEL PLANT MIXED BASE COURSE & BITUMINOUS CONCRETE - L.M. PIKE & SON INC. (PLANT) - FLORENCE, VERMONT.
GRAVEL SHOULDERS, SAND, PEASTONE & CONCRETE CLASS "B" - JOSEPH P. CARRARA & SONS INC. - EAST MIDDLEBURY, VERMONT.
REFINED TAR - WITCO CHEMICAL CO. - WORCESTER, MASS.
TAR EMULSION - BORDEN-CHEMICAL CO. - NEW YORK CITY, N.Y.
ASPHALT - MOBIL OIL CO. - EAST PROVIDENCE, R.I.
STONE GRITS - VERMONT MARBLE CO. - FLORENCE, VERMONT.
REINFORCING STEEL - REPUBLIC STEEL CORP. - YOUNGSTOWN, OHIO.
STRUCTURAL STEEL - CITY IRON WORKS - WEATHERSFIELD, CONN.
REINF. CONC. PIPE & GUARD RAIL - S.T. GRISWOLD & CO. INC. - WILLISTON, VERMONT.
ASPH. CTD. CORR. GALV. MET. PIPE - NEW ENGLAND METAL PIPE CO. - WHITE RIVER JCT., VT.
STEEL PILING - BETHLEHEM STEEL CO. - BETHLEHEM, PA.
GRANITE BRIDGE CURB - BARRETT GRANITE CORP. - MILFORD, N.H.
GRANITE SLOPE EDGING - E.L. SMITH QUARRY - BARRE, VERMONT.
BRIDGE RAILING - WARD-WELLER CORP. - NEWTON LOWER FALLS, MASS.

CONTRACTOR: EDWIN R. PUTNAM & MILLER CONST. INC. - WINDSOR, VT.
RES. ENG. - FRANK E. ALDRICH.
INSPECTOR - R. BRADY.
RECORD PLANS - A.G. SPIDLE.

CONTRACT DATED - DECEMBER 3, 1962.
STARTED - DECEMBER 12, 1962.
COMPLETED & ACCEPTED - NOVEMBER 22, 1963.

REINFORCED CONCRETE DROP INLETS
DETAILS OF GRATES & COVERS FOR DROP INLETS

RECORD PLANS - A.G. SPIDLE
NOV 22, 1966

CONTRACTORS - EDWIN R. PUTNAM & MILLER CONST. INC.

EDWIN R. PUTNAM & MILLER CONST. INC.
BRIDGE WATER COR., VT.
Beginning at a point in the town of Salisbury 3.964 miles northerly of the Leicester - Salisbury Town Line and extending northerly 1.610 miles, including bridge.

SCALE: 1" = 60'


PREPARED: Paul B. Colman
DATE: 9-15-58

APPROVED: E.W. Bishop
DATE: May 16, 1962

APPROVED: [Signature]
DATE: 1-9-69

APPROVED: [Signature]
DATE: 1-16-1959

APPROVED: [Signature]
DATE: May 16, 1962

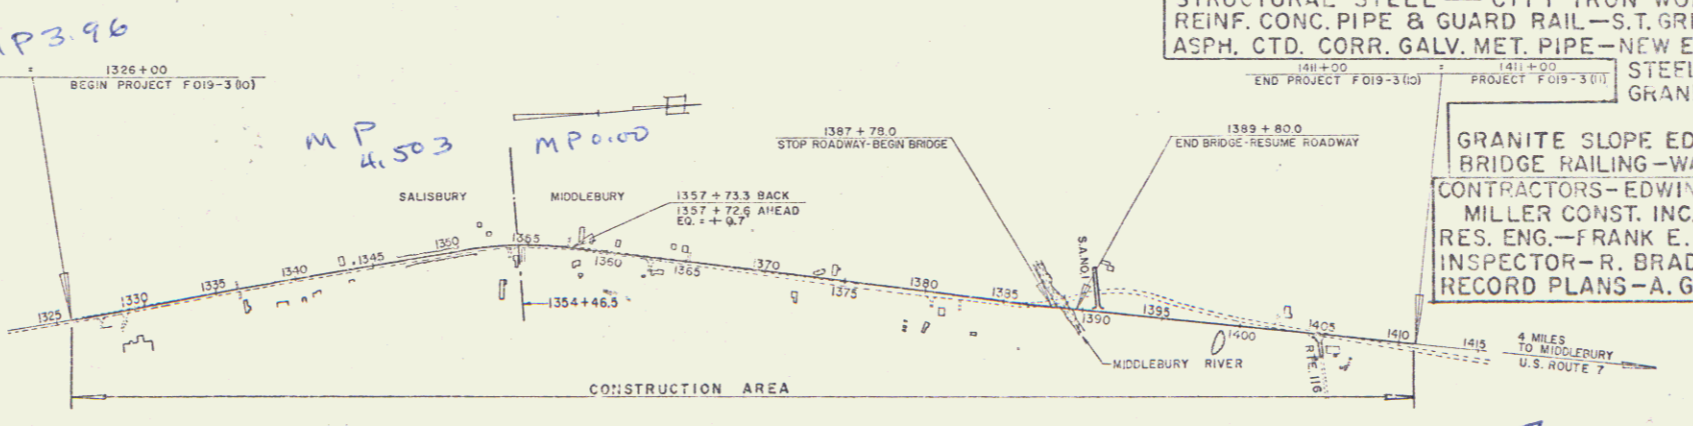

RIGHT-OF-WAY DIVISION
TOWN FILE
PERPETUAL
Town of U.S.7
(To Be Returned to R.O.W. Division)
Pin # 99R467

THESE PLANS ARE SUBJECT TO SUCH REVISIONS AS MAY BE REQUIRED BY THE BUREAU OF PUBLIC ROADS OR THE COMMISSIONER OF HIGHWAYS.

CONSTRUCTION IS TO BE CARRIED ON IN ACCORDANCE WITH THE PLANS AND THE STANDARD SPECIFICATIONS FOR HIGHWAY AND BRIDGE CONSTRUCTION OF JANUARY 1958 SUBMITTED TO THE BUREAU OF PUBLIC ROADS AND APPROVED JULY 4, 1958, INCLUDING ALL SUBSEQUENT APPROVED REVISIONS AND SUCH REVISED SPECIFICATIONS AND SPECIAL PROVISIONS AS MAY BE SUBMITTED WITH THE PLANS.

PREPARED	APPROVED	APPROVED	APPROVED	APPROVED	APPROVED	APPROVED
Paul B. Colman DATE: 9-15-58	E.W. Bishop DATE: May 16, 1962	[Signature] DATE: 1-9-69	[Signature] DATE: 1-16-1959	[Signature] DATE: May 16, 1962	[Signature]	[Signature]

VERMONT PROJECT NO. 702 DATE 9-15-58

DEPARTMENT OF COMMERCE
BUREAU OF PUBLIC ROADS

SALISBURY-MIDDLEBURY ROAD PROJECT F019-31(0)

SHEET 0 OF 11 SHEETS