
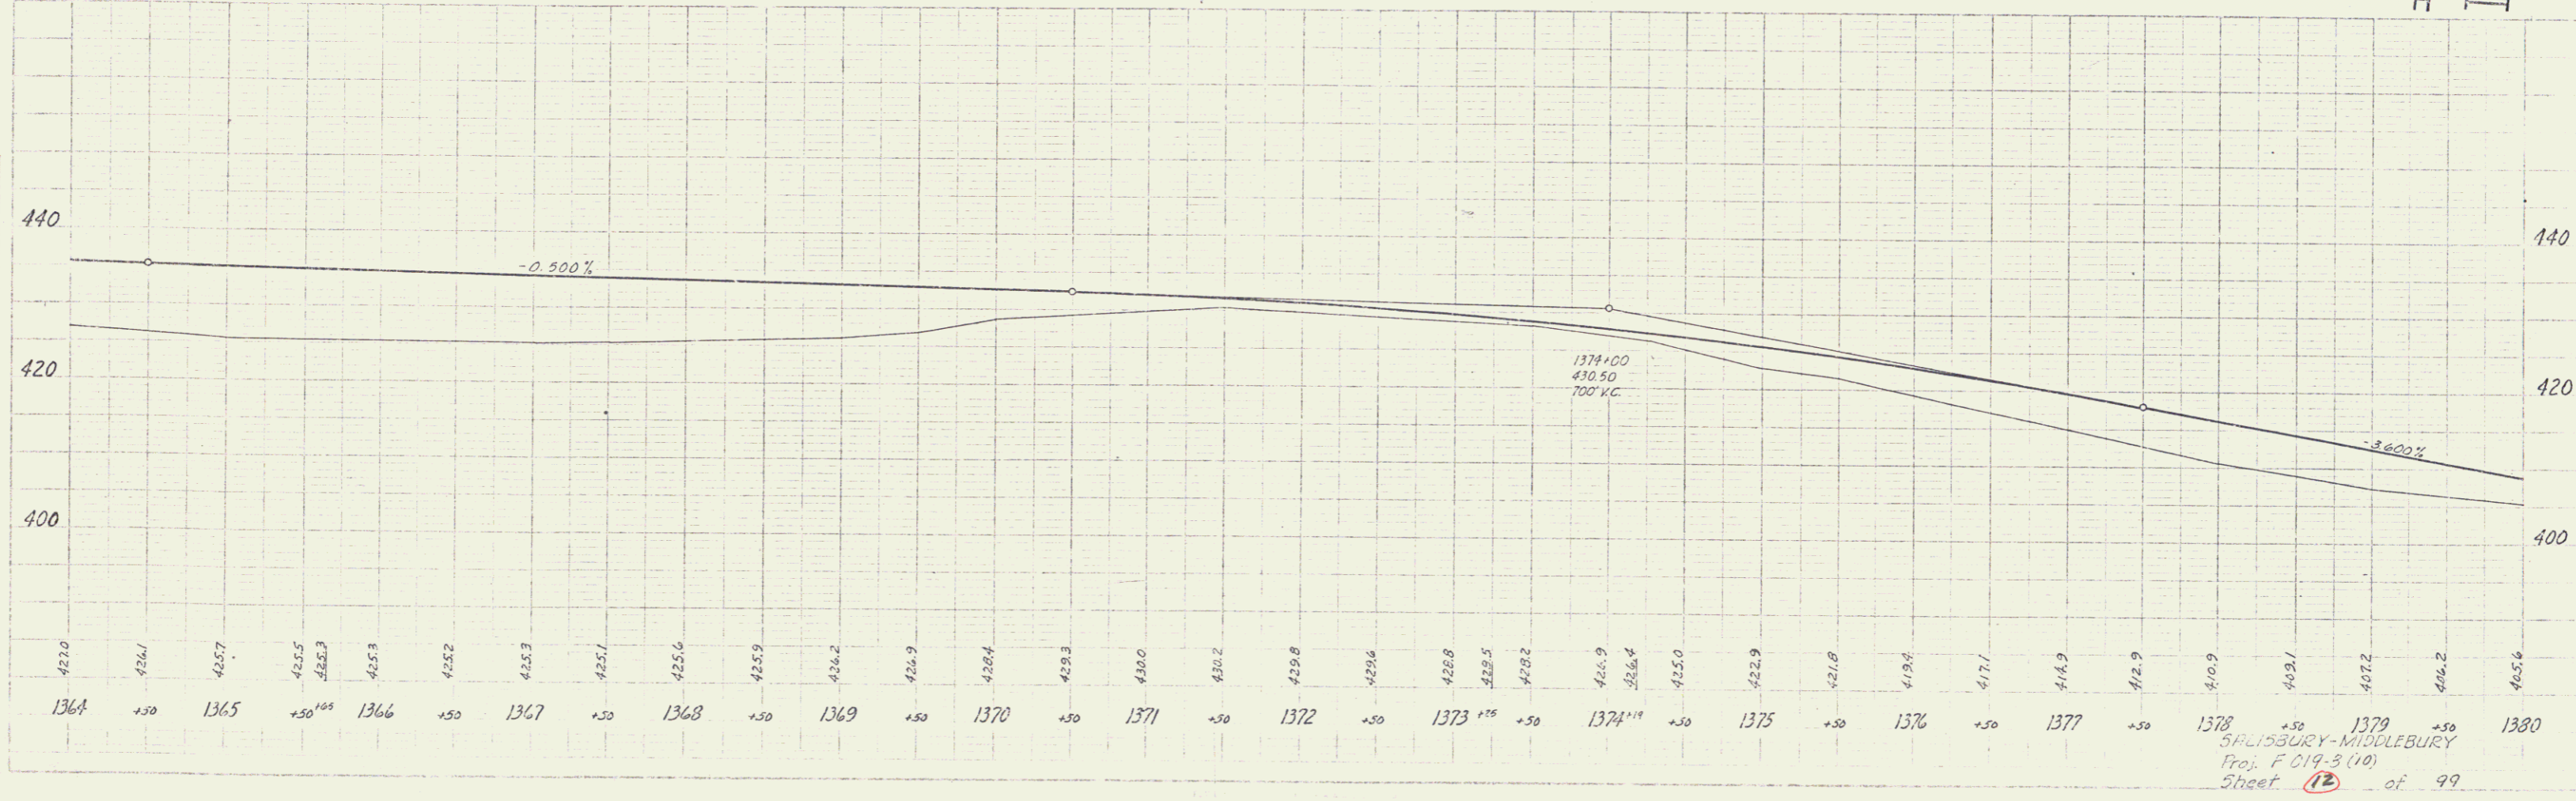


12-52
2-56
WCU
5-58
Traced

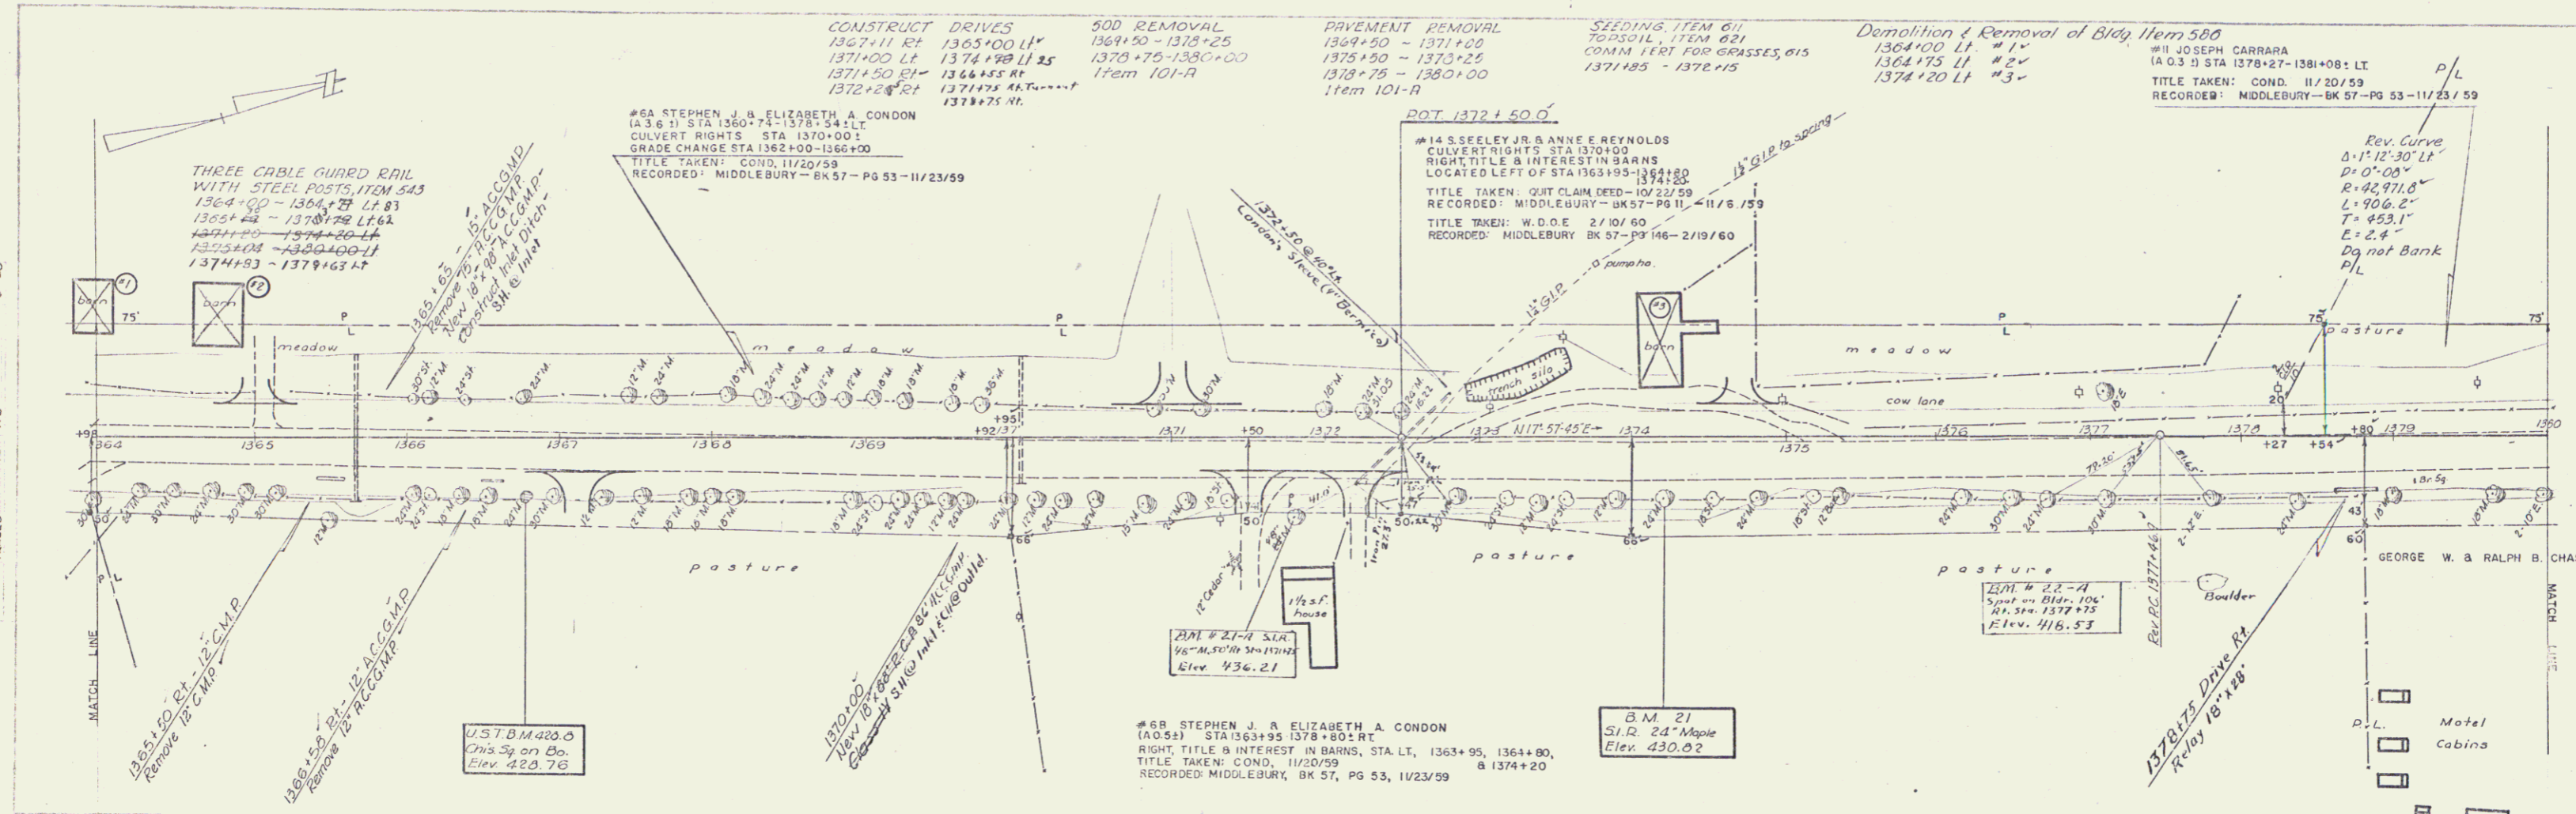

5