


Seeding, Item 011
 Topsoil, Item 021
 Com. m. Fertilizer for Grasses, Item 015
 1402+25 - 1403+25 LT.

TYPICAL SECTION
 VT. Rte. 116

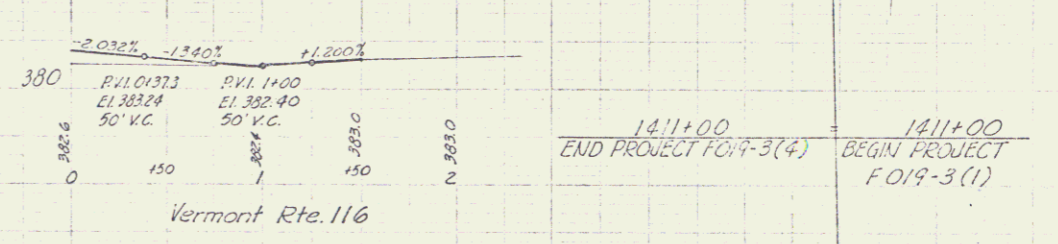

1396	1397	1398	1399	1400	1401	1402	1403	1404	1405	1406	1407	1408	1409	1410	1411	1412
------	------	------	------	------	------	------	------	------	------	------	------	------	------	------	------	------

1411+00
 END PROJECT FO19-3(4)
 1411+00
 BEGIN PROJECT
 FO19-3(1)
 5 SALISBURY - MIDDLEBURY
 Proj. F O19-3(00)
 Sheet 14 of 99