

INDEX OF SHEETS

1.	Title Page	
2.	Typical Sections	
3.	Summary of Quantities and Drainage Sheet	
4-5.	Earthwork and Grade Sheets	
6.	Blank	
7-9.	R.O.W. Layouts	
10-13.	Plan and Profile Sheets	
14.	Blank	
15.	A-61 Slopes in Solid Rock Excavation	12/ 8/71
16.	B-1 Banking Tables	12/ 8/71
17.	B-5 Embankment on Earth Slope	12/ 6/71
18.	D-2 Cement Rubble Masonry Headwalls	3/ 8/72
19.	D-4 Underdrain Flushing Basin	7/17/72
20.	D-6 Reinf. Conc. Drop Inlet w/Grate	12/ 6/71
21.	C-11 Cast Iron Grate - Type A	4/25/72
22.	E-2 Road Const. Approach Signs	12/14/71
23.	E-5 Road Const. Signs Detachment Projects	12/14/71
24.	E-6 On-Project Const. Signs	12/14/71
25.	G-4 Steel Marker Posts	12/ 8/71
26.	J-1 Boundary Markers	12/ 6/71
27-49.	Cross Sections - Mainline	
50-52.	Cross Sections - TR 9	

STATE OF VERMONT
DEPARTMENT OF HIGHWAYS




PROPOSED IMPROVEMENT

TOWN OF MIDDLEBURY
COUNTY OF ADDISON

ROUTE U.S. 7

MIDDLEBURY - VERGENNES ROAD

Pin # 99R468

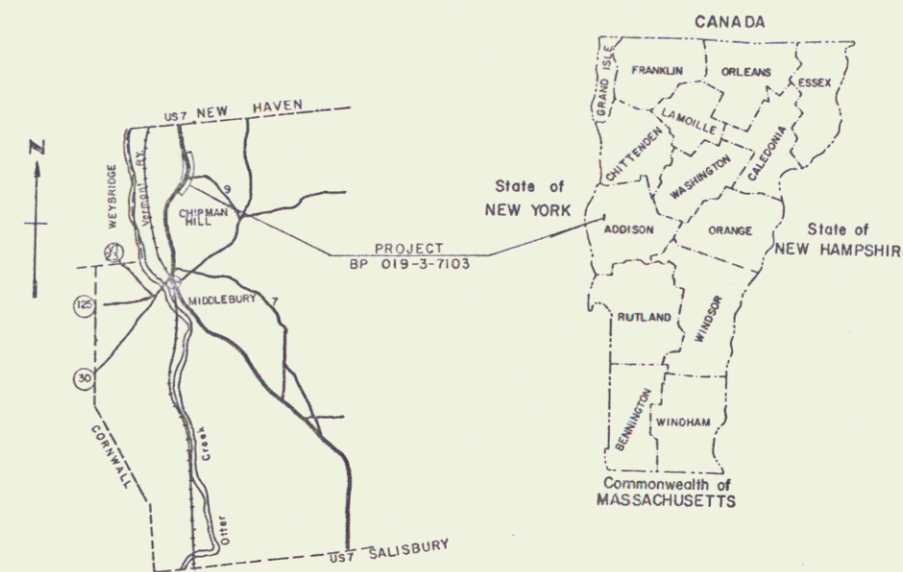


BEGINNING AT A POINT 1.013 MILES SOUTHERLY OF THE
MIDDLEBURY-NEW HAVEN TOWN LINE, AND EXTENDING IN A NORTH-
EASTERLY DIRECTION 0.484 MILES.

LENGTH OF PROJECT 2,450 FEET = 0.464 MILES

TRAFFIC DATA

1971 ADT : 4,470
1971 DHV : 580
C : 53%
T : 4%
V : 60 MPH

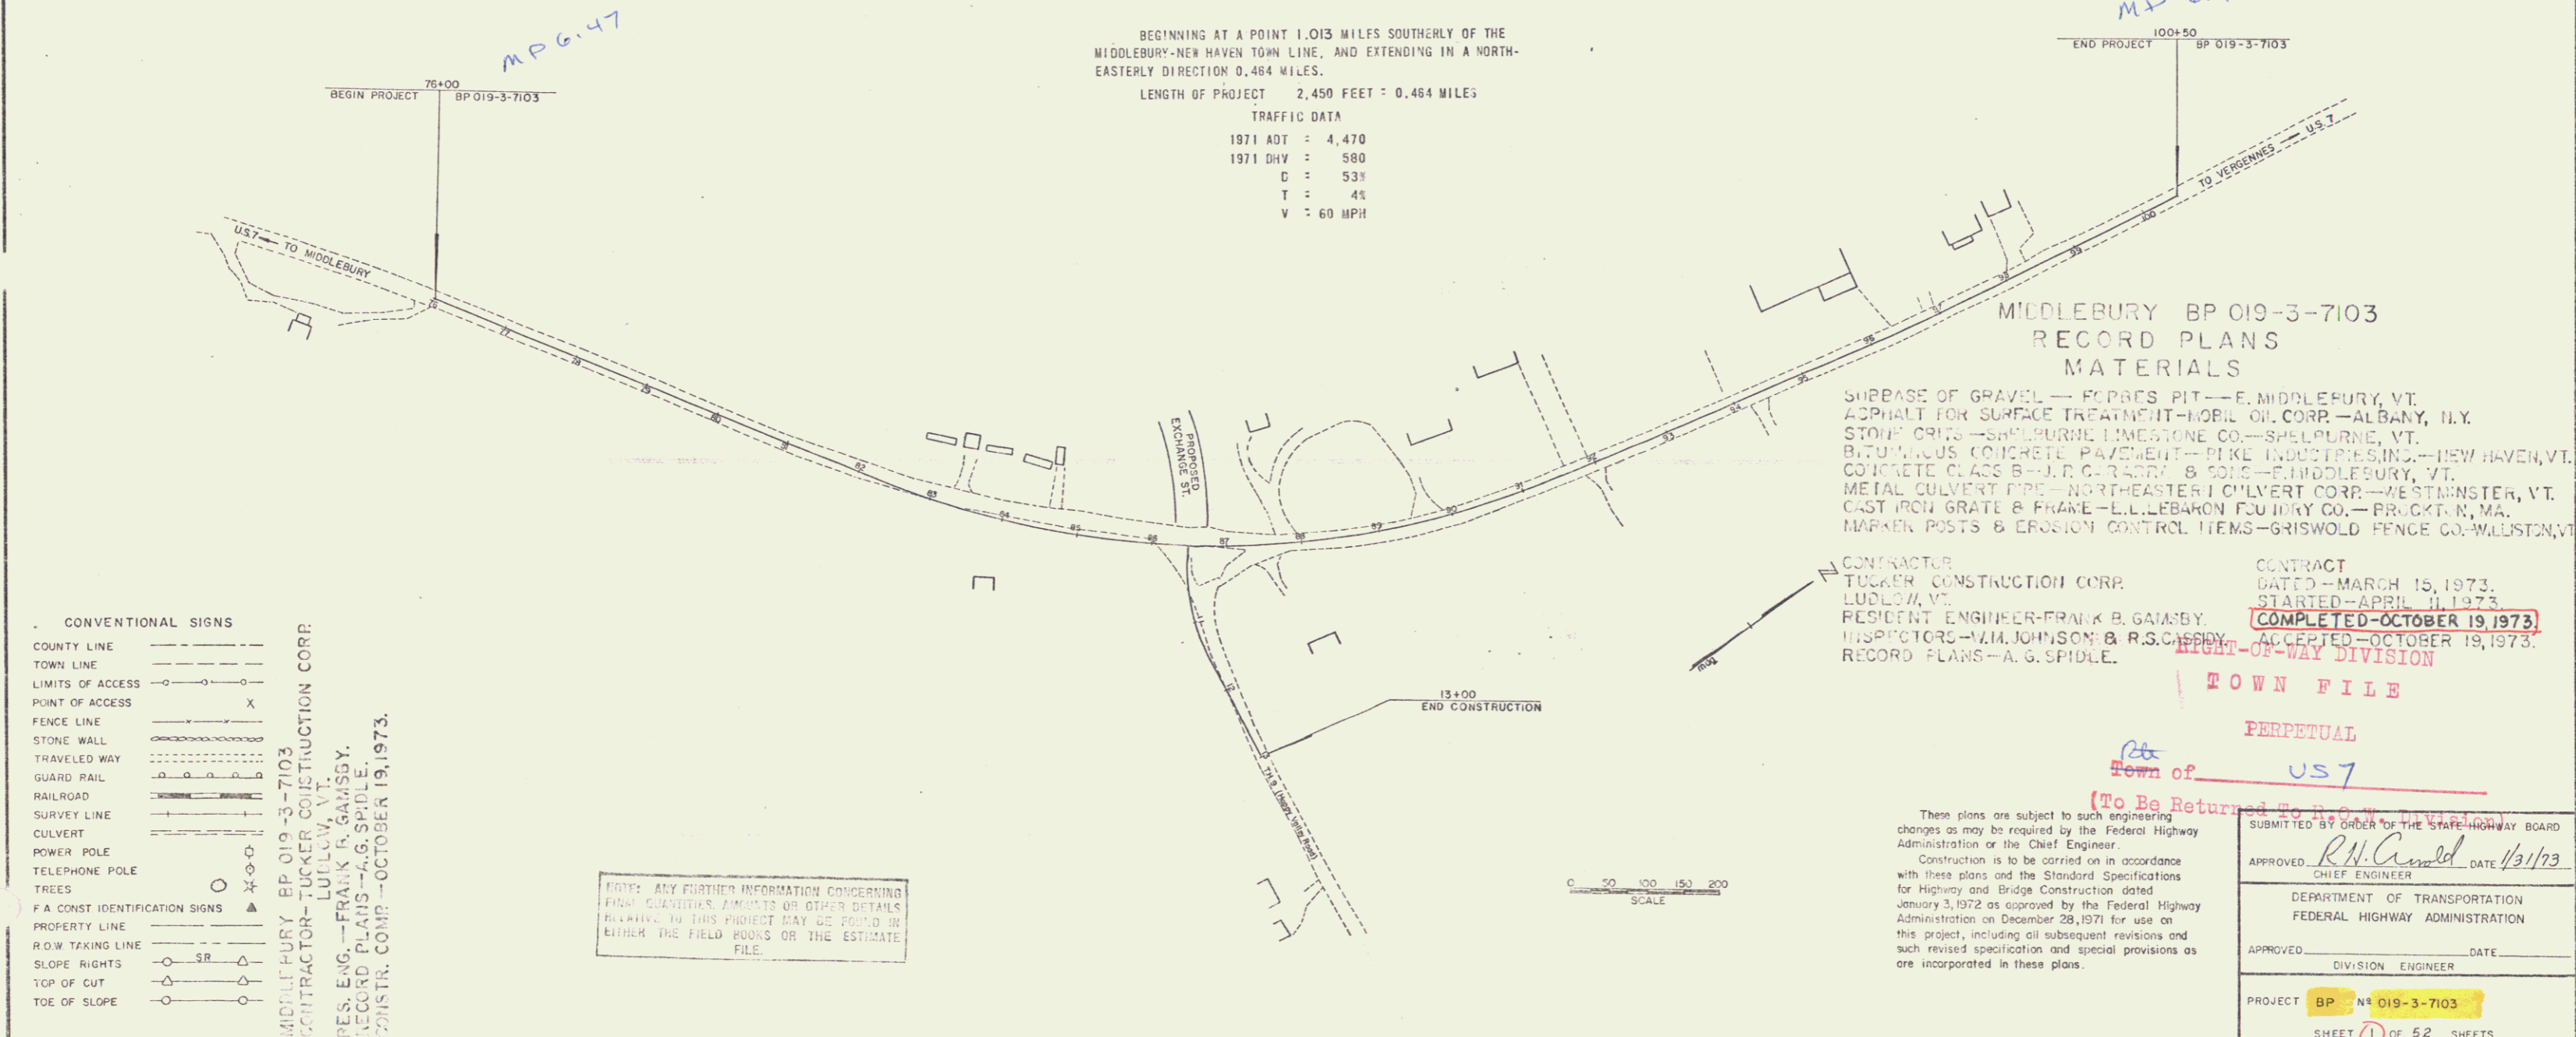

CONVENTIONAL SIGNS

COUNTY LINE	---
TOWN LINE	- - - -
LIMITS OF ACCESS	o---o
POINT OF ACCESS	X
FENCE LINE	=====
STONE WALL	-----
TRAVELED WAY
GUARD RAIL	o---o
RAILROAD	====
SURVEY LINE	---
CULVERT	---
POWER POLE	o---o
TELEPHONE POLE	o---o
TREES	o---o
F.A. CONST. IDENTIFICATION SIGNS	▲
PROPERTY LINE	---
R.O.W. TAKING LINE	---
SLOPE RIGHTS	SR
TOP OF CUT	△
TOE OF SLOPE	○

MIDDLEBURY, BP 019-3-7103
CONTRACTOR-TUCKER CONSTRUCTION CORP.
LUDLOW, VT.
RES. ENG.-FRANK B. GAINSBY.
RECORD PLANS-A.G. SPIDLE.
CONSTR. COMP.-OCTOBER 19, 1973.

NOTE: ANY FURTHER INFORMATION CONCERNING
FINAL QUANTITIES, AMOUNTS OR OTHER DETAILS
RELATIVE TO THIS PROJECT MAY BE FOUND IN
EITHER THE FIELD BOOKS OR THE ESTIMATE
FILE.

SURFACE OF GRAVEL - FORBES PIT - E. MIDDLEBURY, VT.
ASPHALT FOR SURFACE TREATMENT - MOBIL OIL CORP. - ALBANY, N.Y.
STONE CRITS - SHELBURNE LIMESTONE CO. - SHELBURNE, VT.
BITUMINOUS CONCRETE PAVEMENT - PIKE INDUSTRIES, INC. - NEW HAVEN, VT.
CONCRETE CLASS B - J.R. CARRON & SONS - E. MIDDLEBURY, VT.
METAL CULVERT PIPE - NORTHEASTERN CULVERT CORP. - WESTMINSTER, VT.
CAST IRON GRATE & FRAME - L.L. LEBARON FOUNDRY CO. - BROOKTON, MA.
MARKER POSTS & EROSION CONTROL ITEMS - GRISWOLD FENCE CO. - WELLSVILLE, VT.

CONTRACTOR
TUCKER CONSTRUCTION CORP.
LUDLOW, VT.
RESIDENT ENGINEER - FRANK B. GAINSBY.
INSPECTORS - W.M. JOHNSON & R.S. CASBIDY.
RECORD PLANS - A.G. SPIDLE.

CONTRACT
GATED - MARCH 15, 1973.
STARTED - APRIL 11, 1973.
COMPLETED - OCTOBER 19, 1973.
ACCEPTED - OCTOBER 19, 1973.

RIGHT-OF-WAY DIVISION

TOWN FILE

PERPETUAL

Town of US 7

(To Be Returned To Dept. of Highways)

These plans are subject to such engineering
changes as may be required by the Federal Highway
Administration or the Chief Engineer.
Construction is to be carried on in accordance
with these plans and the Standard Specifications
for Highway and Bridge Construction dated
January 3, 1972 as approved by the Federal Highway
Administration on December 28, 1971 for use on
this project, including all subsequent revisions and
such revised specification and special provisions as
are incorporated in these plans.

SUBMITTED BY ORDER OF THE STATE HIGHWAY BOARD

APPROVED: *R.N. Arnold* DATE 1/31/73
CHIEF ENGINEER

DEPARTMENT OF TRANSPORTATION
FEDERAL HIGHWAY ADMINISTRATION

APPROVED: _____ DATE _____
DIVISION ENGINEER

PROJECT BP # 019-3-7103

SHEET 1 OF 52 SHEETS

