

WOOD GUARD RAIL REQUIRED
 CONVEYER STATION LEFT RIGHT
 100+50 ~ 24

CABLE GUARD RAIL REQUIRED
 STATIONS LEFT CONSTANT PIPE LENGTH
 107+25-107+70 27 40 30'
 121+25-123+00 75 20 35'

NEW REIN. CONCRETE PIPE CONVEYERS REQUIRED
 STATION DIAM. LENGTH CONGR. CONC. RIGID STEEL
 100+50 10 48 21'3" 102 lbs.



DRIVEWAY PIPE CONVEYERS REQUIRED
 (REIN. CONCRETE PIPE)
 STATION LEFT DIAM. LENGTH CEMENT RUBBLE MASONRY
 107+25 R 12 20 2.3 cubic yards
 115+06 R 12 20 2.3 cubic yards
 107+19 L 24 28 5.4 cubic yards

WOOD GUIDE POSTS REQUIRED
 STATION LEFT RIGHT
 122+00 1 ~

STANDARD UNDERDRAIN REQUIRED
 (4" P.C.G.M. PIPE)
 STATION LENGTH CEMENT RUBBLE MASONRY
 122+00 24 1 cubic yard

Parcel	Kind of Instrument	Date of Instrument	Grantor	Grantee	Recorded	Remarks
A & B	Q.C.D.	4-30-31	J. Kellogg	Staff	8	130 6-3-31

STATE OF ILLINOIS
 109 A 1031 11 122

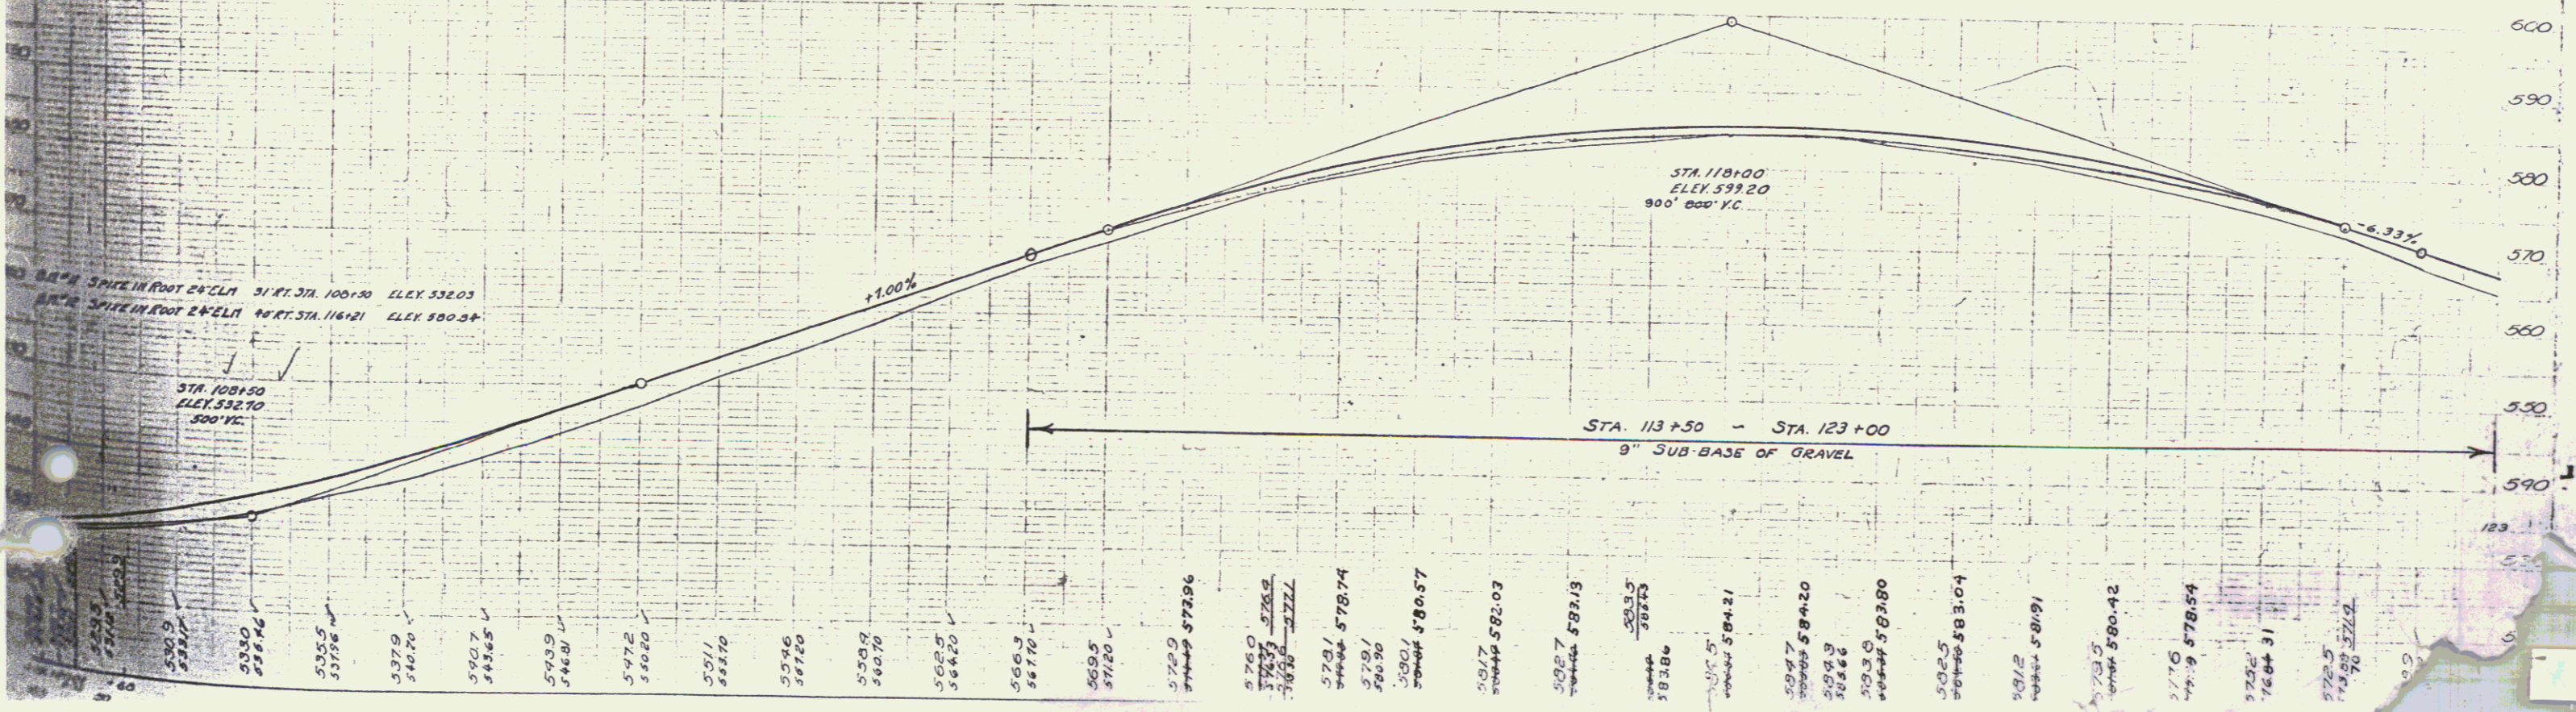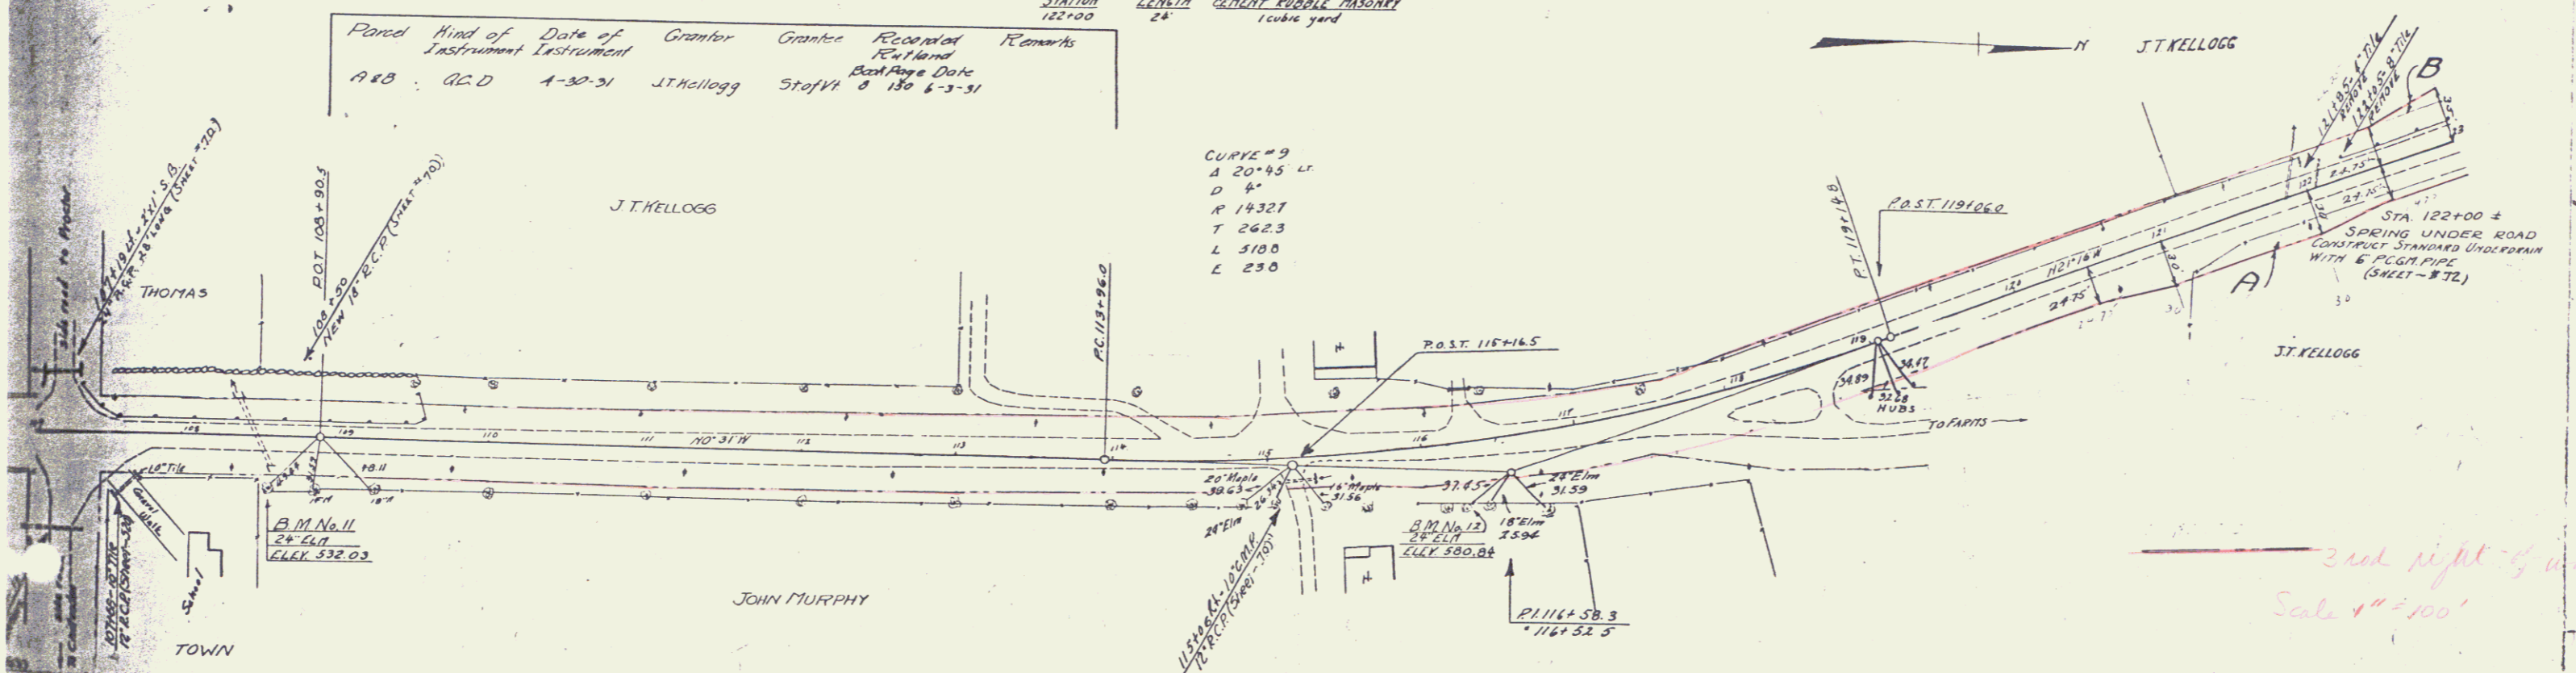

3rd night of work
 Scale 1"=100'