
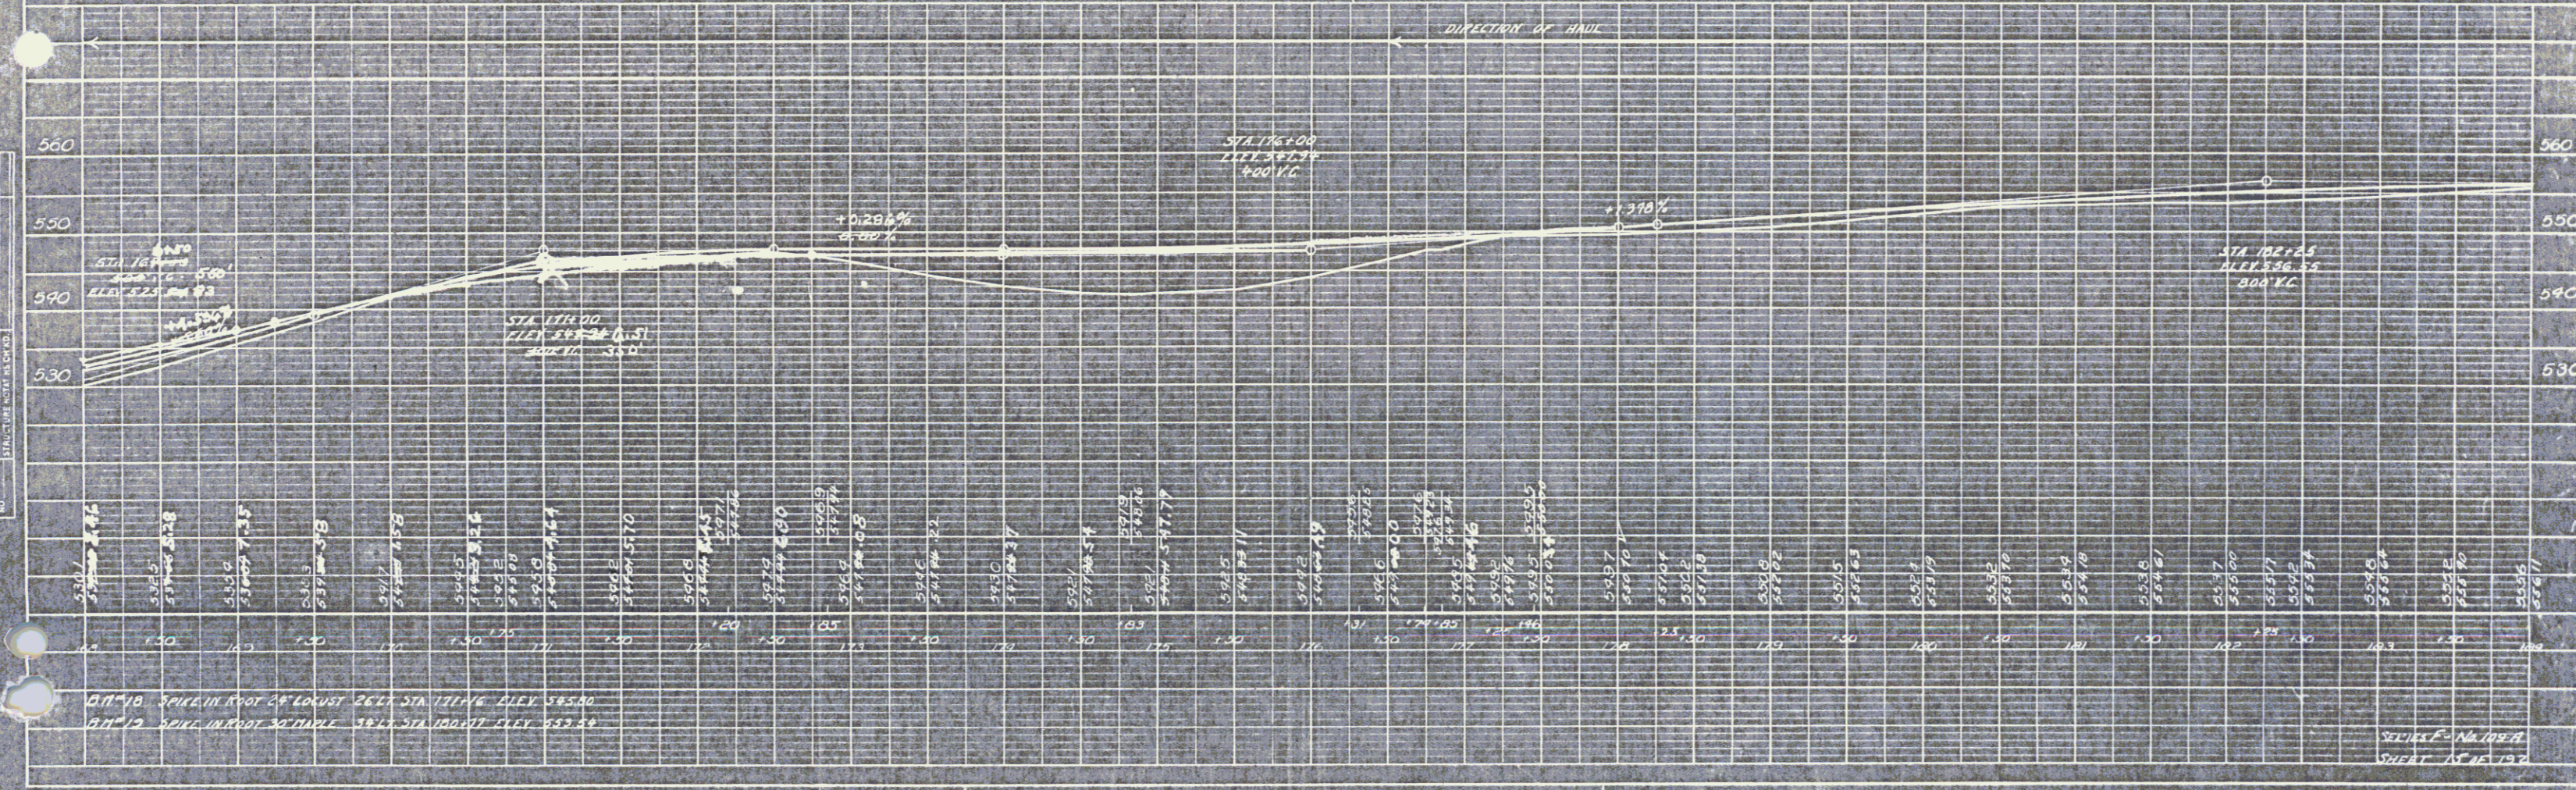


STATIONS	FROM	TO	LENGTH
174+24-175+4 RT	120	10'	160'
174+24-175+2 LT	12-B	10'	168'

NEW PINE LOGS TO PIPE CURBETS REQUIRED
 STATION 174+05 TO 174+15
 174+05 TO 174+15
 174+05 TO 174+15

DRAINAGE SPA. CURBETS REQUIRED
 STATION 177+15 TO 177+20
 177+15 TO 177+20
 177+15 TO 177+20

103 A 1831 15 192

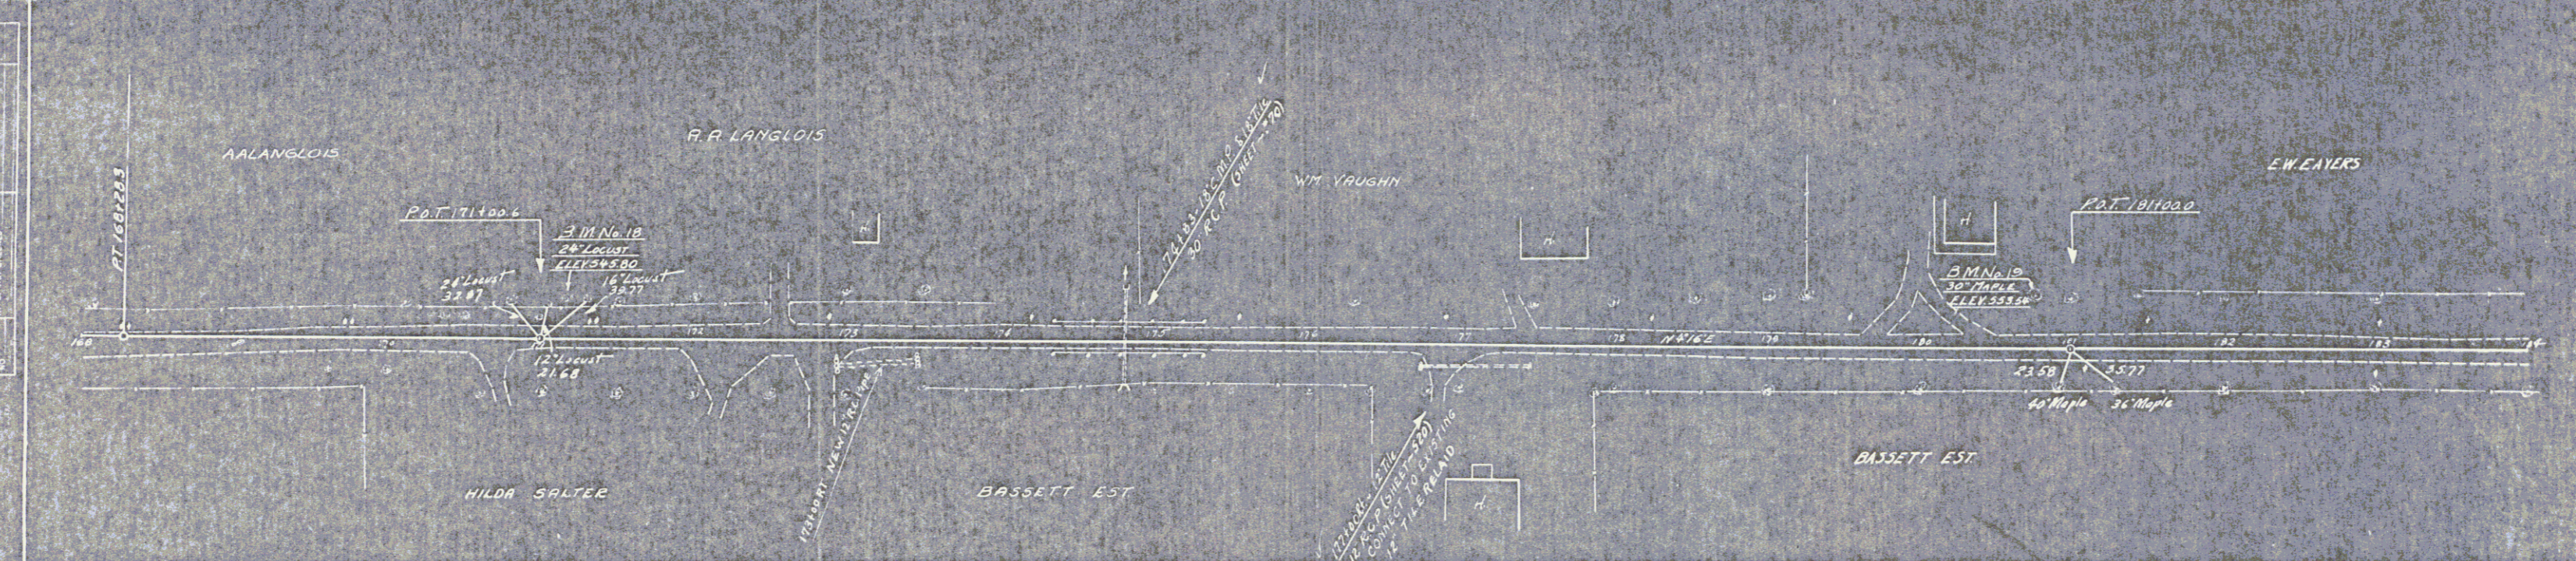

DATA: SPIKE IN SPOT 24' LOCUS 26' STA 171+00 ELEV 535.00
 SPIKE IN SPOT 30' THICK 30' STA 182+25 ELEV 556.58

SCALE: HORIZ. 1" = 40' VERT. 1" = 10'

This is not to scale (15) 14