

WOOD GUARD RAIL REQUIRED

CUVRET STA	LEFT	RIGHT
249+14	24'	24'

CABLE GUARD RAIL REQUIRED

STATIONS	LENG	CONSTANT	ANY LENGTH
253+75-255+99.02	224'	40'	264'
253+75-255+99.02	224'	40'	264'



NEW REIN CONCRETE PIPE CULVERTS REQUIRED

STATION	QUANT	LENG	CONC. A	CONC. C	REIN. STEEL
249+14	15'	40'	~	2.3cy	3.3 lbs.
254+11	15'	48'	1.5cy	~	54 lbs.

DRIVEWAY PIPE CULVERTS REQUIRED

STATION	LOAR.	DIAM.	LENG.	CEMENT	ROUNDS	MARKING
261+20	R	12" x 24"	23cy			

FILE NO.	STATE	YEAR	SHEET NO.	TOTAL SHEETS
109 A	1931	20	192	

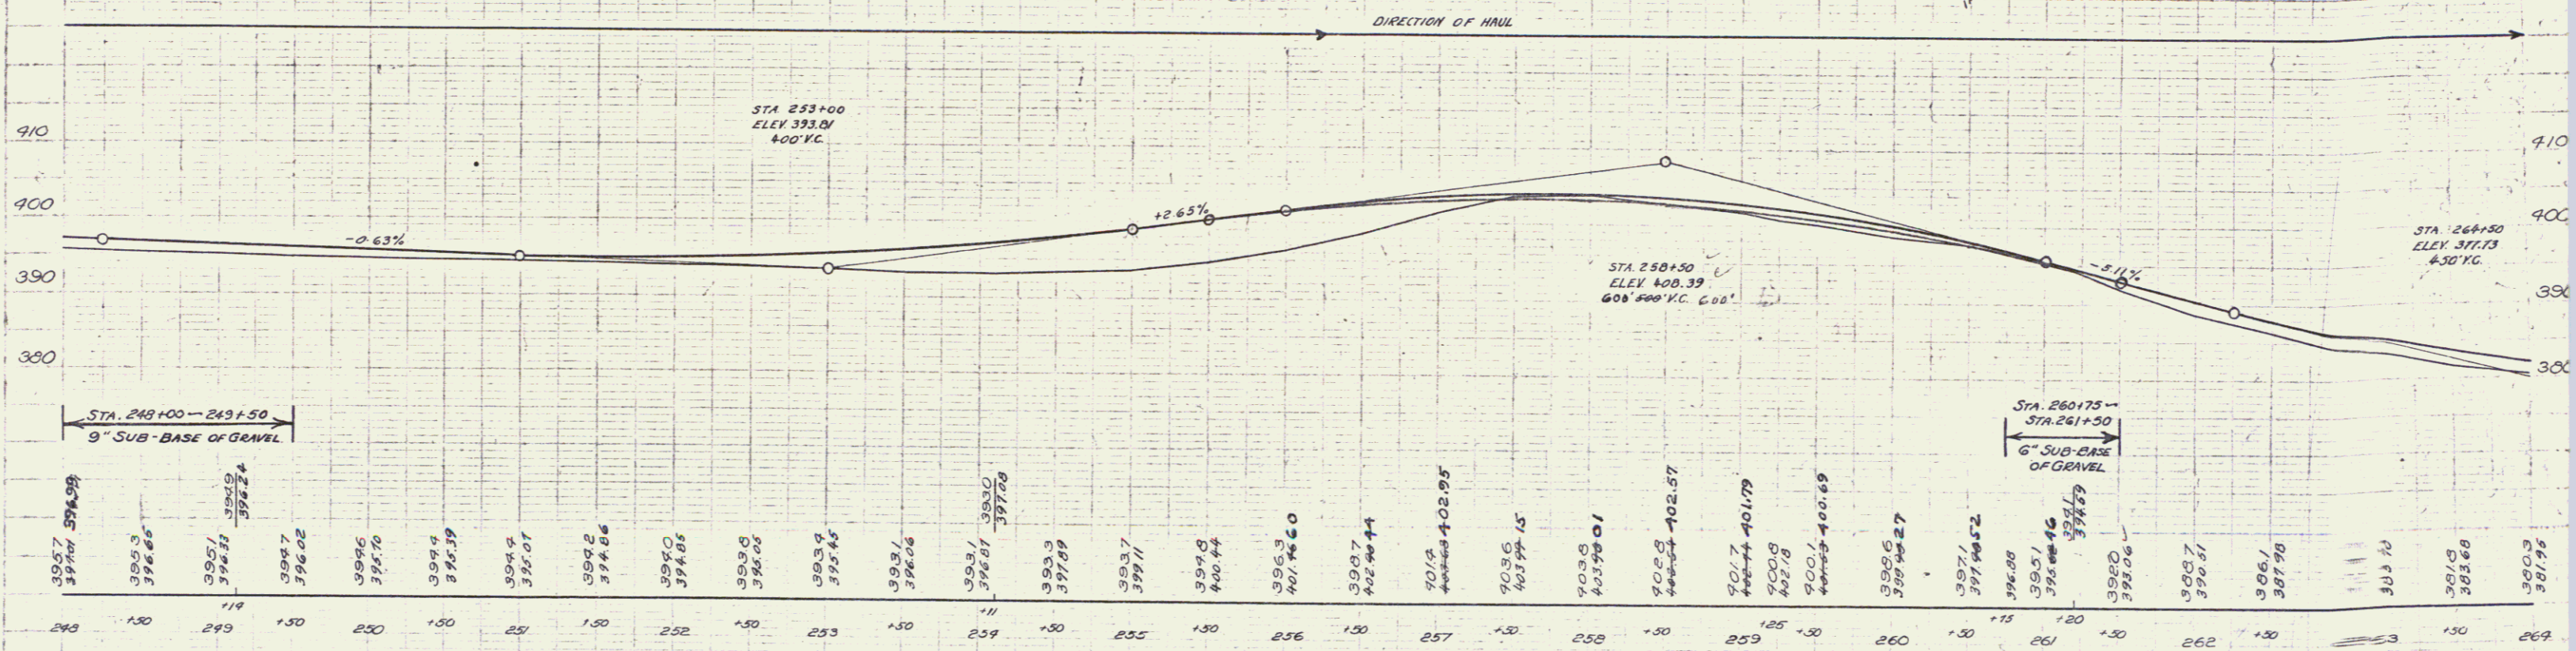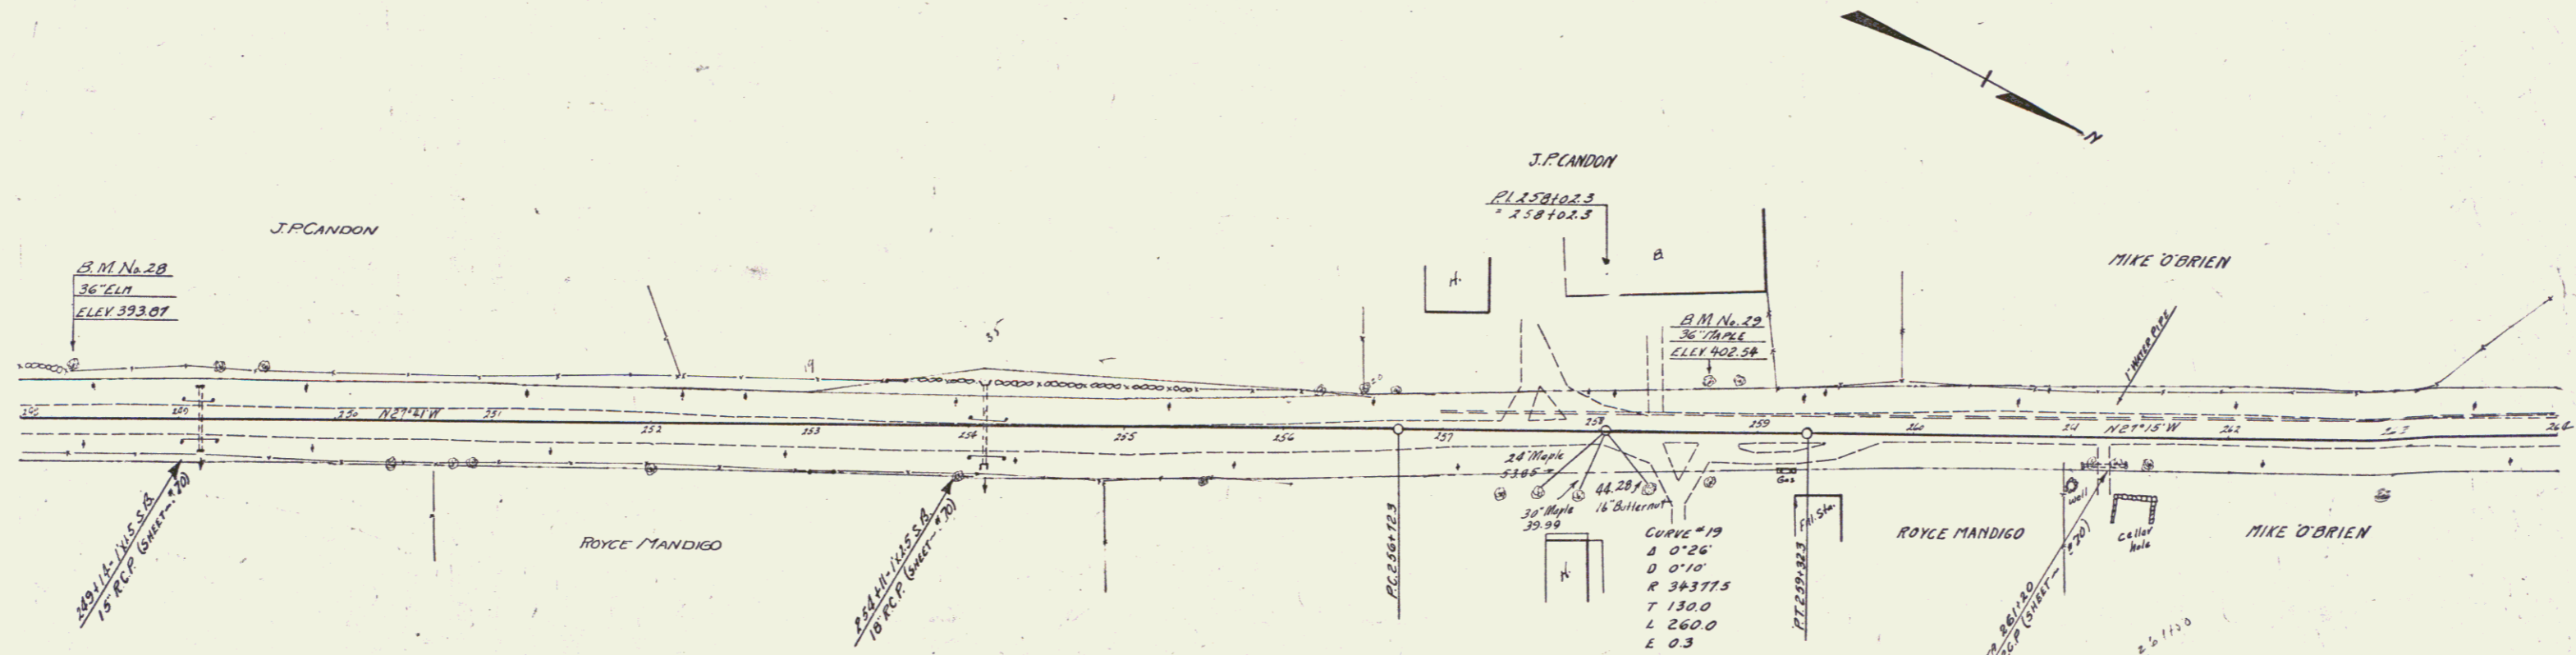

STA 248+00-249+50
 9" SUB-BASE OF GRAVEL
 STA 260+175-261+50
 6" SUB-BASE OF GRAVEL