
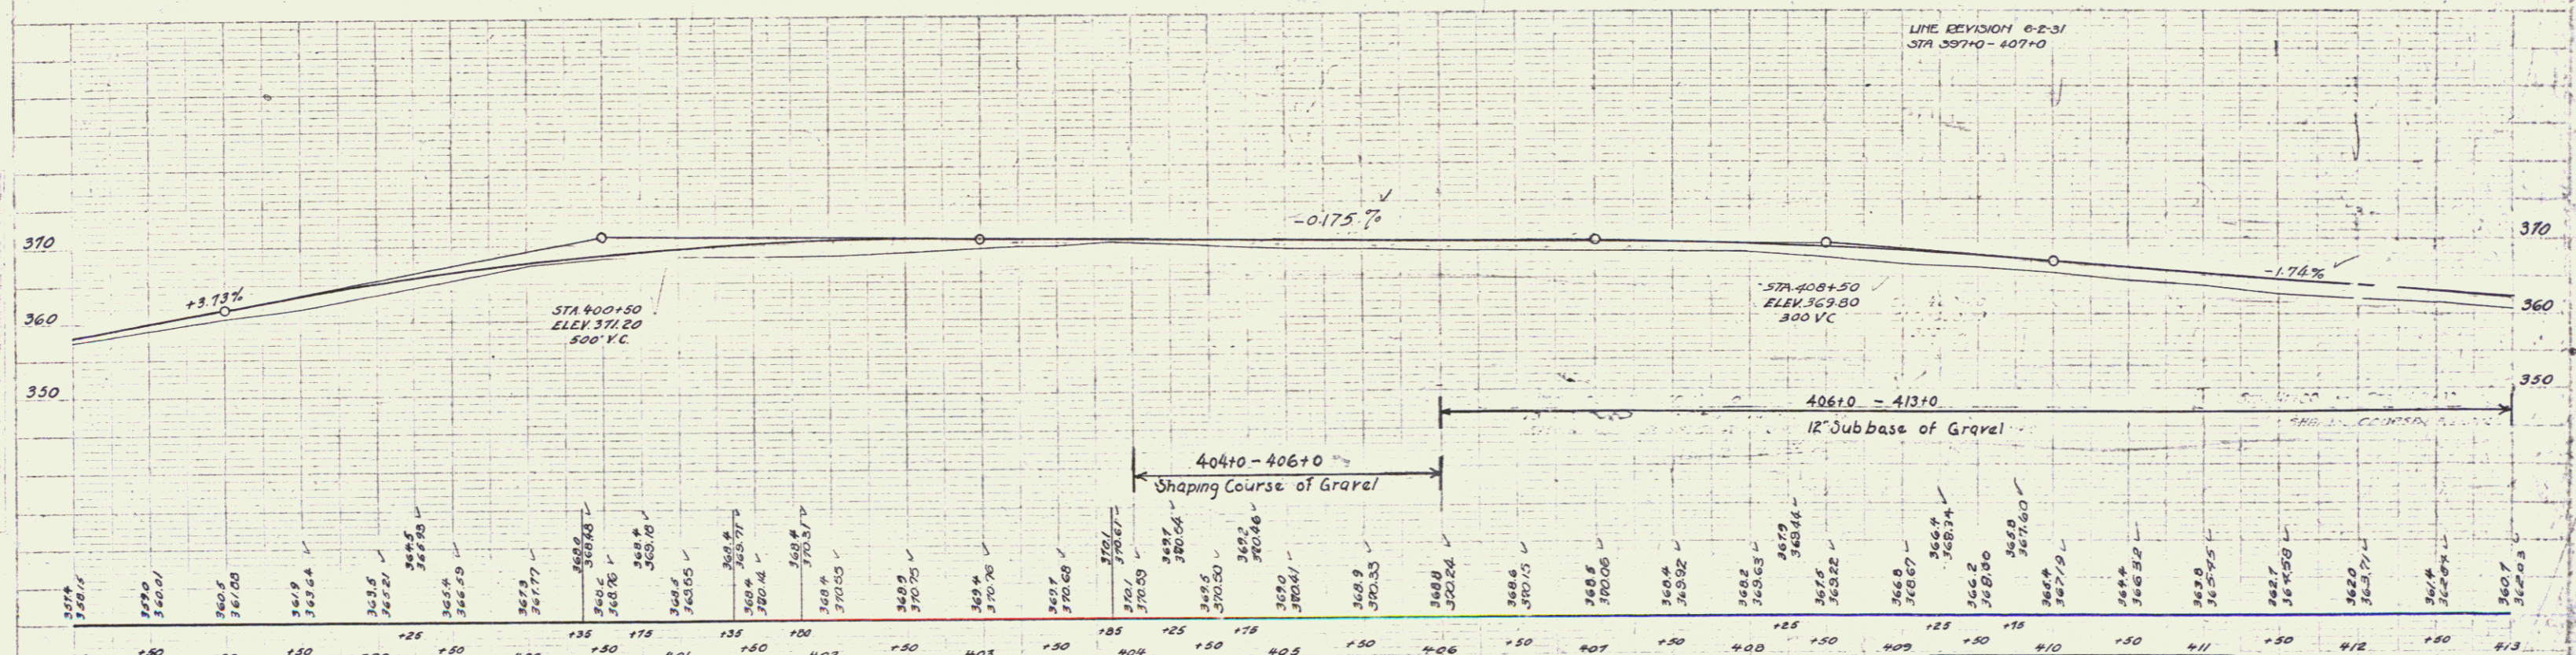


Parcel	Kind of Instrument	Date of Instrument	Grantor	Grantee	Recorded Plat/Book/Sheet	Remarks
A	R.O.D.	5-9-31	J.G.N. Shelvey	St. of Yt.	41 118-130 2-28-31	

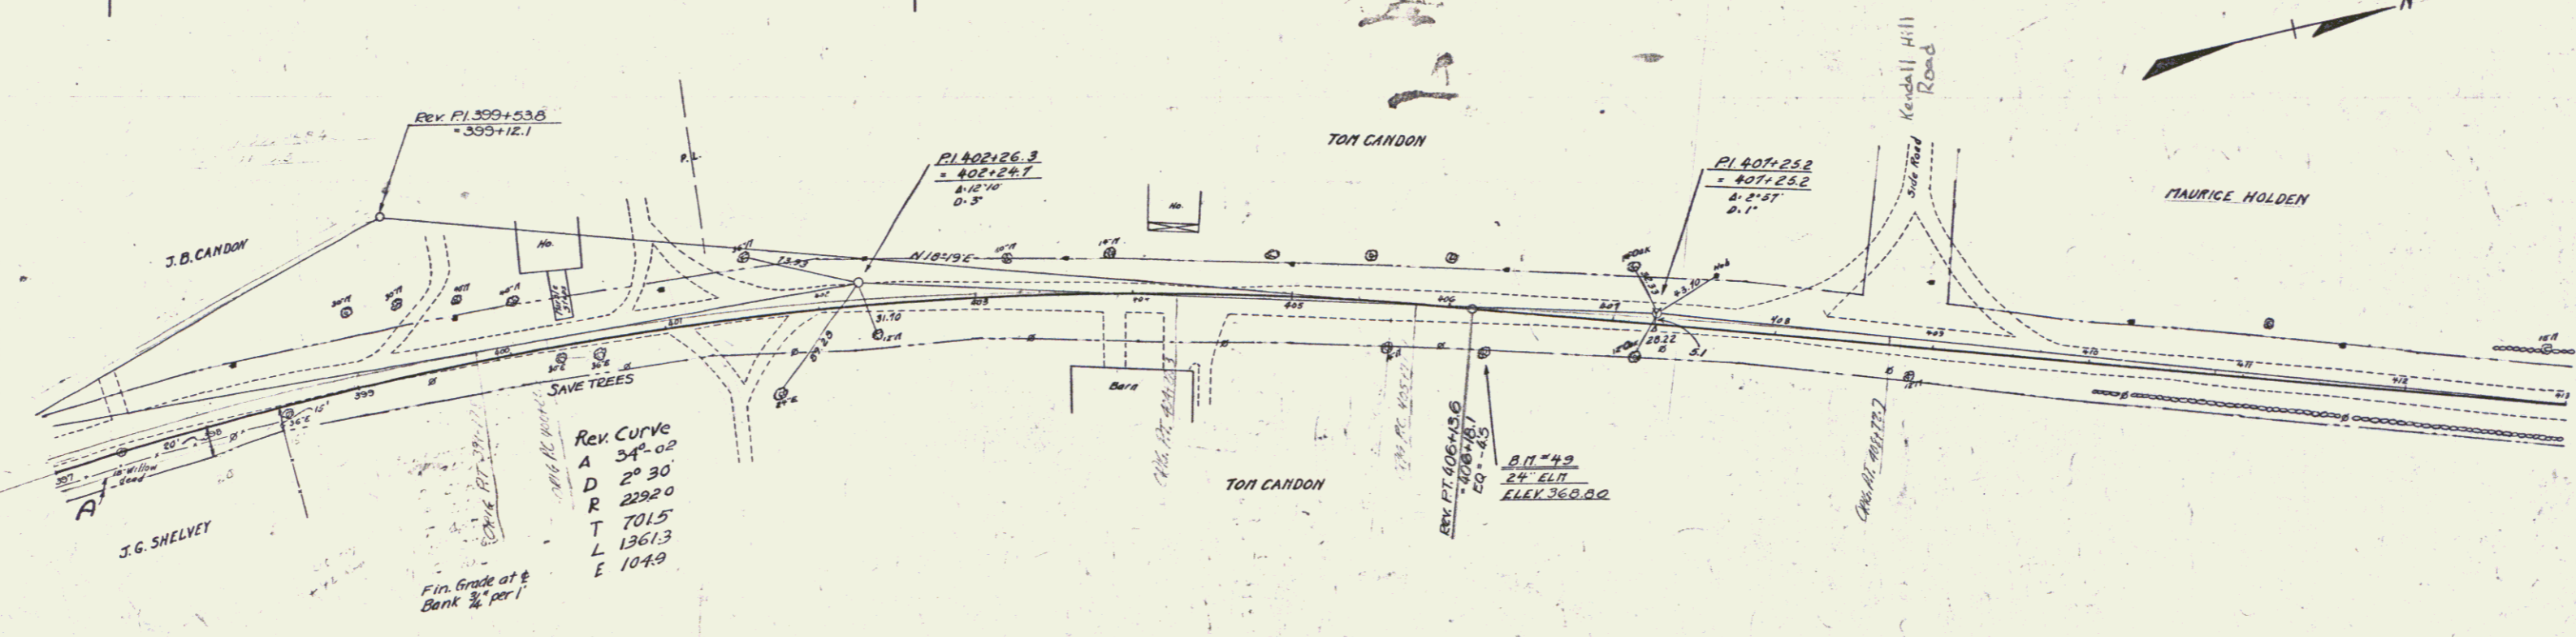

B.M. # 49 SPIKE IN ROOT 24' ELM 25' FT. STA. 406+21 ELEV 360.00

GRADE REVISION 0-7-31  
 ORIG. PI. Sta 408+0 300' V.C. Elev 368.35  
 REV. PI. Sta 408+0 300' V.C. Elev 369.80  
 ORIG. Sta 406+25-411+0 12' Sub-base of Gravel  
 ELEV. 368.35-369.80  
 ORIG. Sta 411+0-413+0 Shaping Course of Gravel  
 REV. Sta 404+0-413+0 12' Sub-base of Gravel

SERIES F 110 109-B  
 SHEET 30 OF 132