


WOOD GUMBO RAIL REQUIRED

CONCRETE STA	LEFT	RIGHT
444+16	24'	24'
449+97	24'	24'

NEW REIN. CONCRETE PIPE CULVERTS REQUIRED

STATION	DIAM	LENG	GRS.A	GRS.C	REIN. STEEL
444+16	15"	44'	23y	33/100	
449+97	15"	40'	14y	12y	1/16lb.

NO. 109-A 1991 33 192

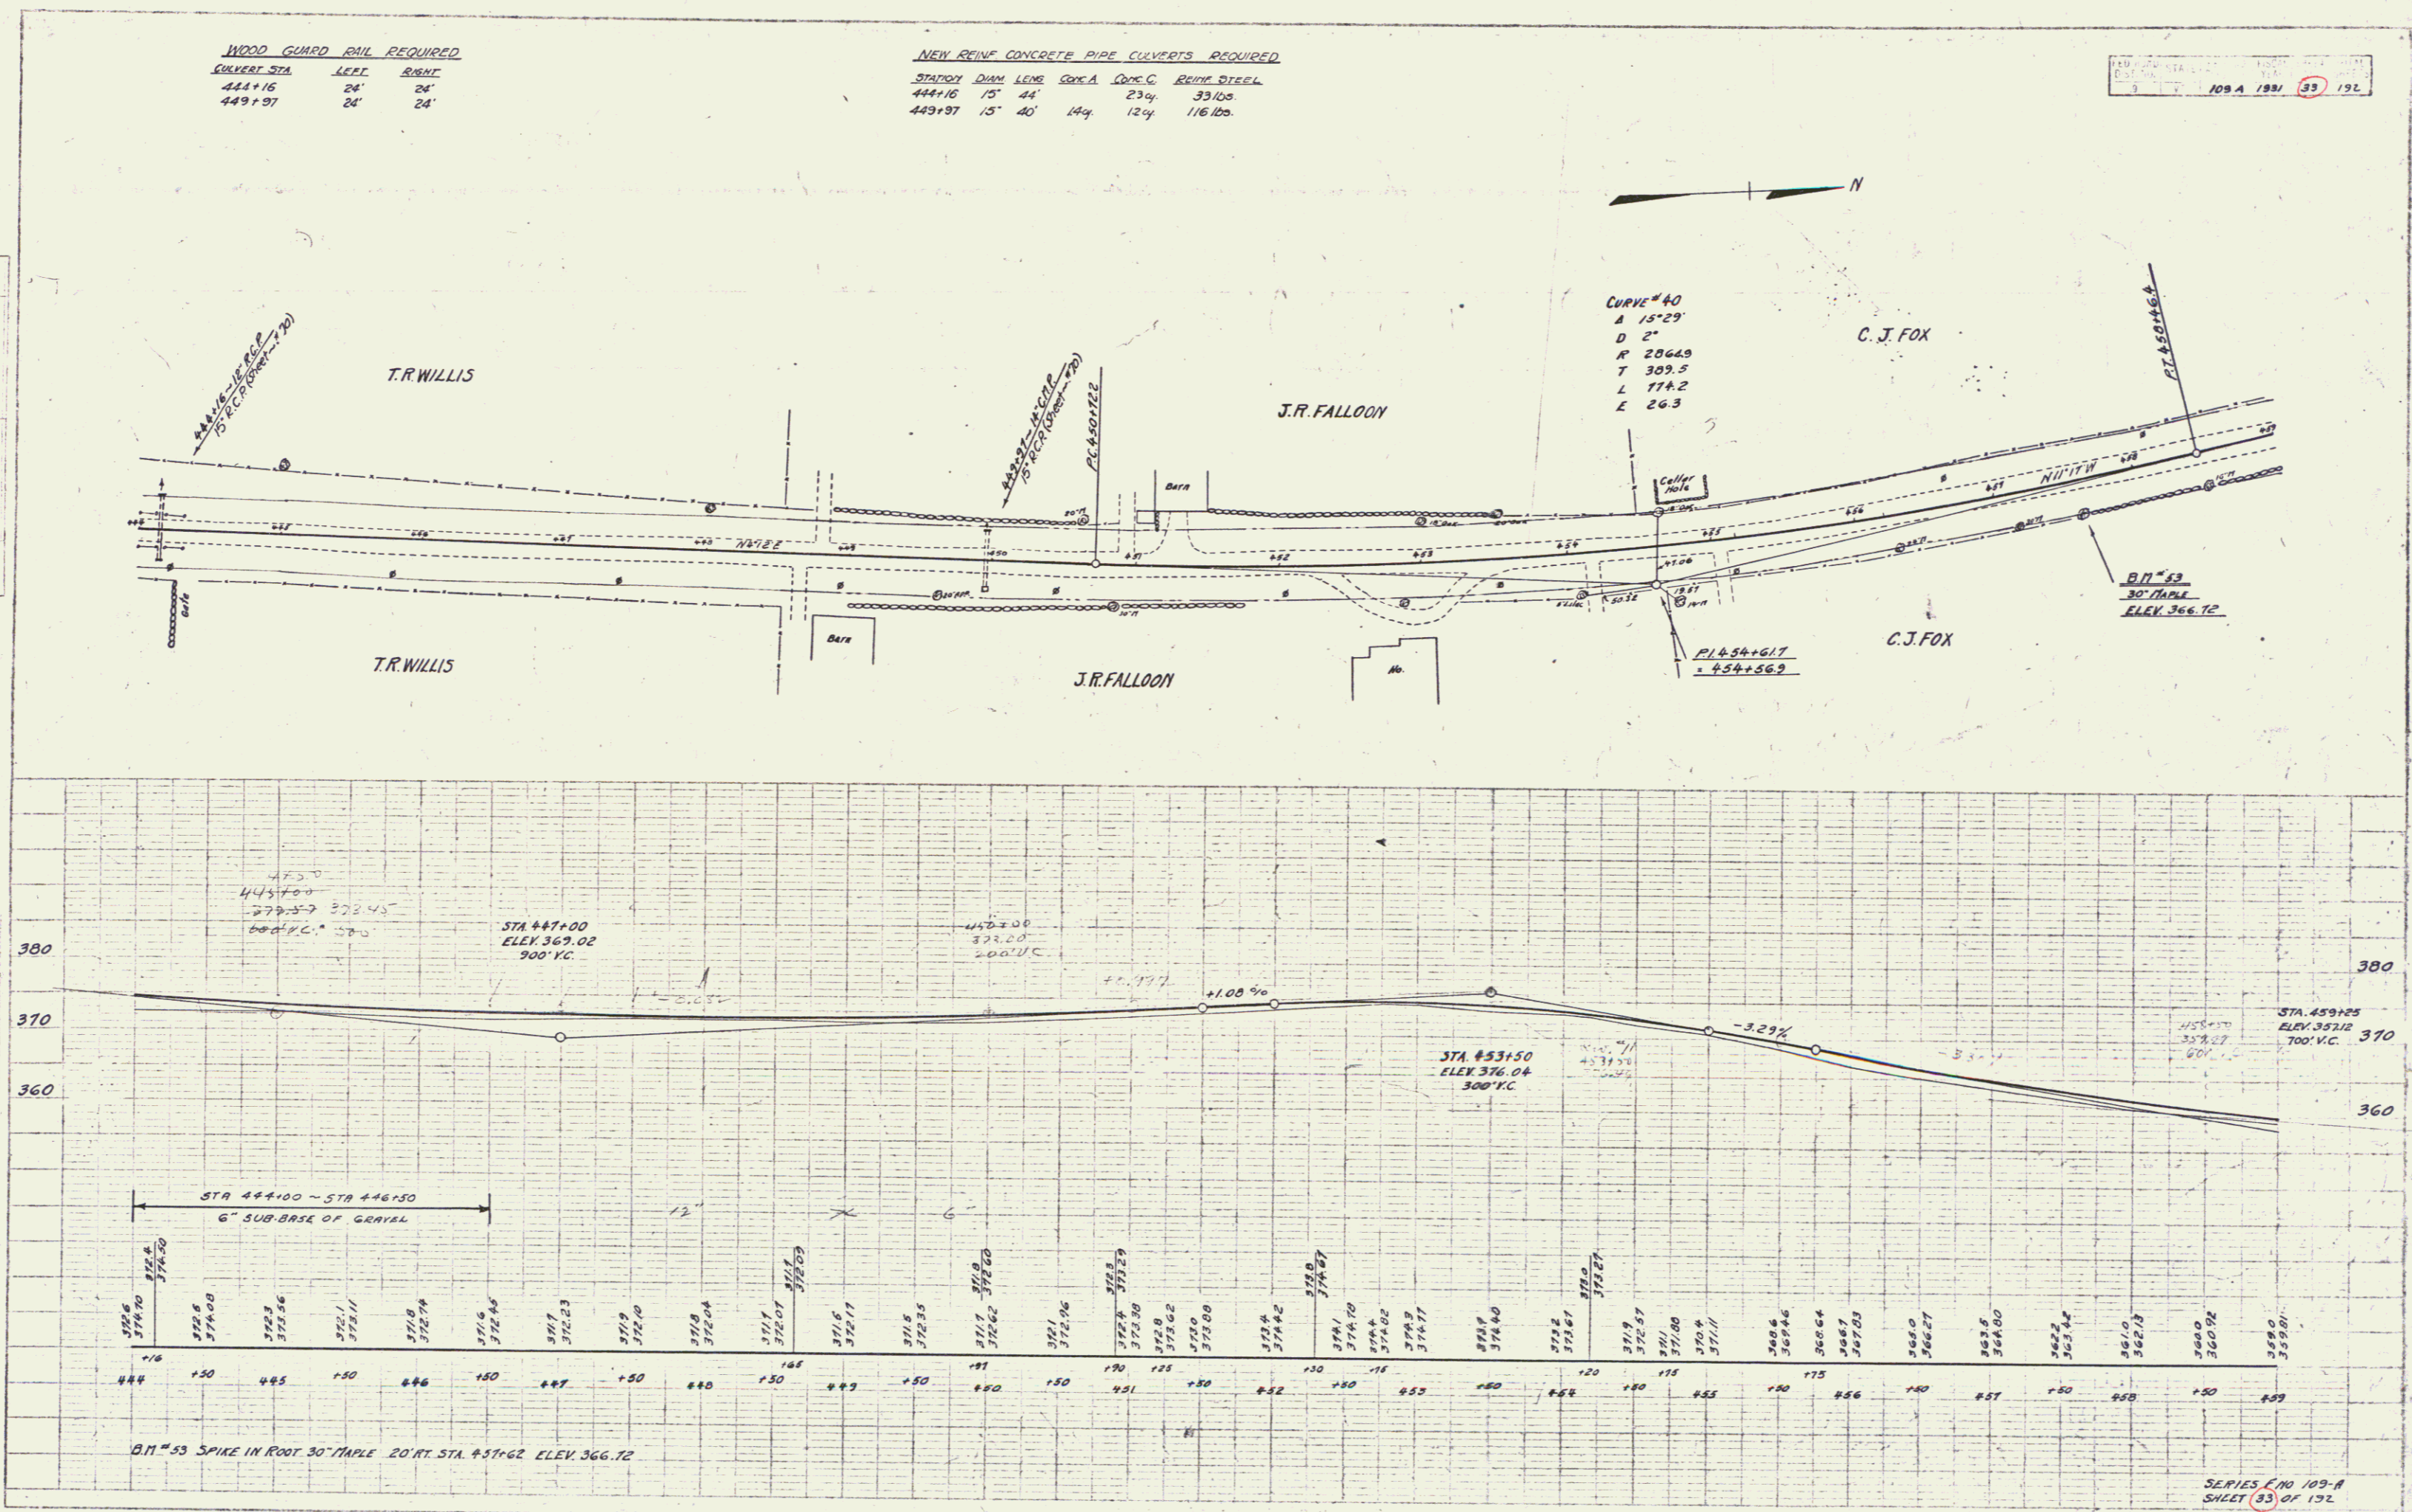

PLAN
 SCALE 1" = 40'
 DATE 10/1/91

PROFILE
 SCALE 1" = 10'
 DATE 10/1/91

SERIES NO 109-A
SHEET 33 OF 132