

CABLE GUARD RAIL REQUIRED

STATIONS	LENG.	CONSTANT	PIV. LENGTH
670+00-671+64 LT. 184'	20'	184'	
685+00-686+00 LT. 100'	20'	120'	
685+00-686+00 RT. 100'	20'	120'	

NEW REINF. CONCRETE PIPE CULVERTS REQUIRED

STATION	DIA.	LENG.	CONC. P.	CONC. C.	REINF. STEEL
686+00	36"	108'	4.0 cy.	-	58 lbs.



GROUTED COBBLE GUTTER REQUIRED

STATIONS	LEAS.	WIDTH	LENGTH	AREA
684+80-686+00 LT.	3'-6"	120'	46.6 sqyds	
684+80-686+00 RT.	3'-6"	120'	46.6 sqyds	

FED. ROAD STATE PER. AID. FISCAL YEAR PER. NO. 1 1931 40 192

Parcel	Kind of Instrument	Date of Instrument	Grantor	Grantee	Recorded	Remarks
B	A.C.D.	4-29-31	EE Kimberley	St of R. 64	5-2-31	
A'	"	4-29-31	AE EUGAN. Woods	"	64 234	5-2-31
A"	"	7-15-32	JH & JH Severy	"	64 236	7-28-32

CURVE
 Δ 3+44' 32.4"
 D 11'
 R 572.7
 T 146.7 170.0
 L 875.3 340.0
 E 3-0 2.5

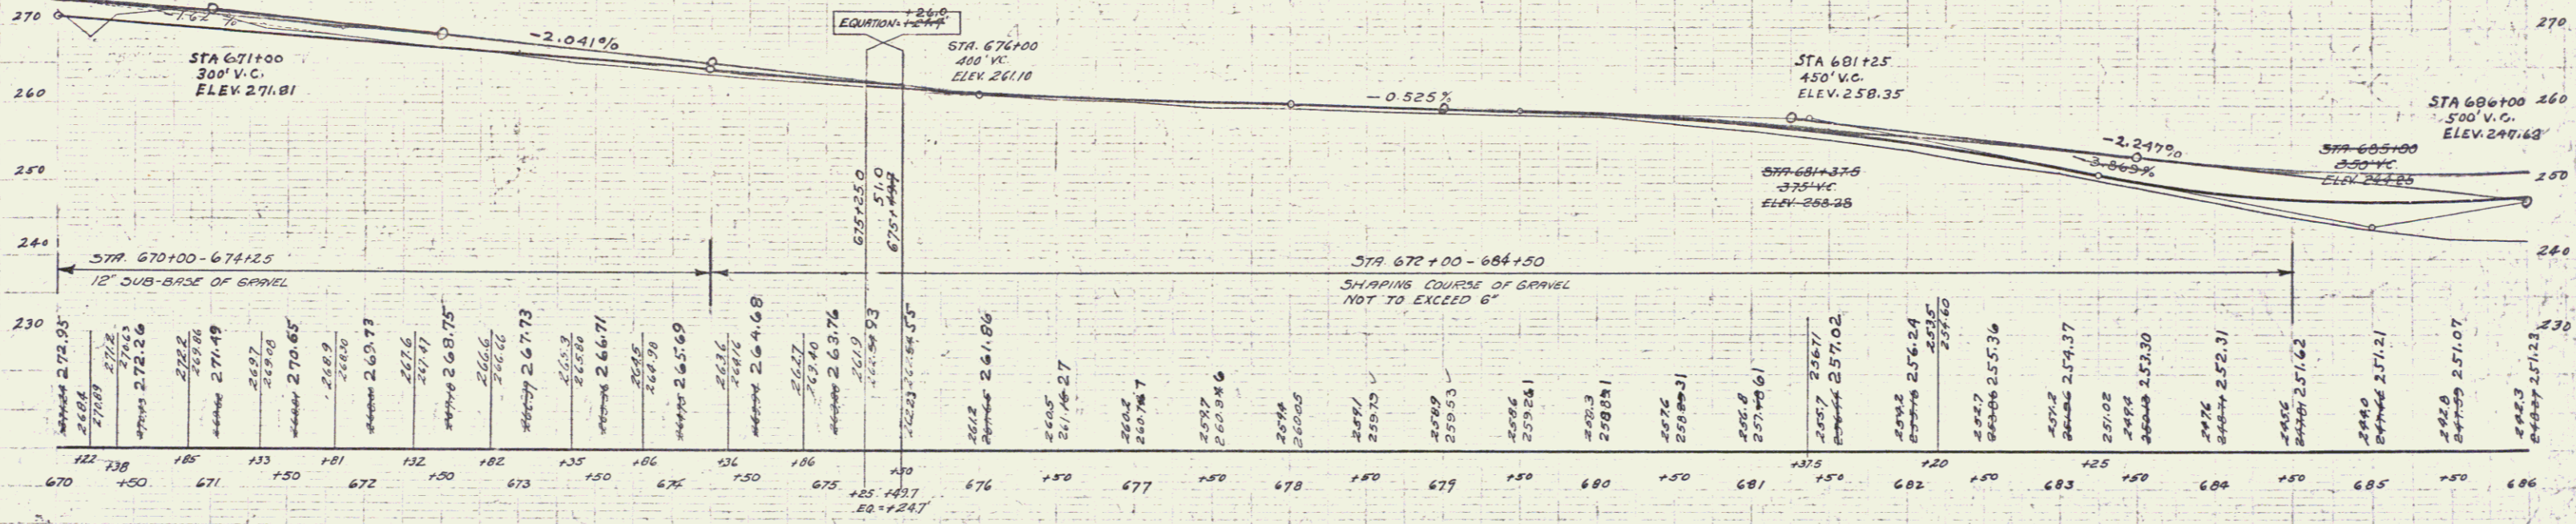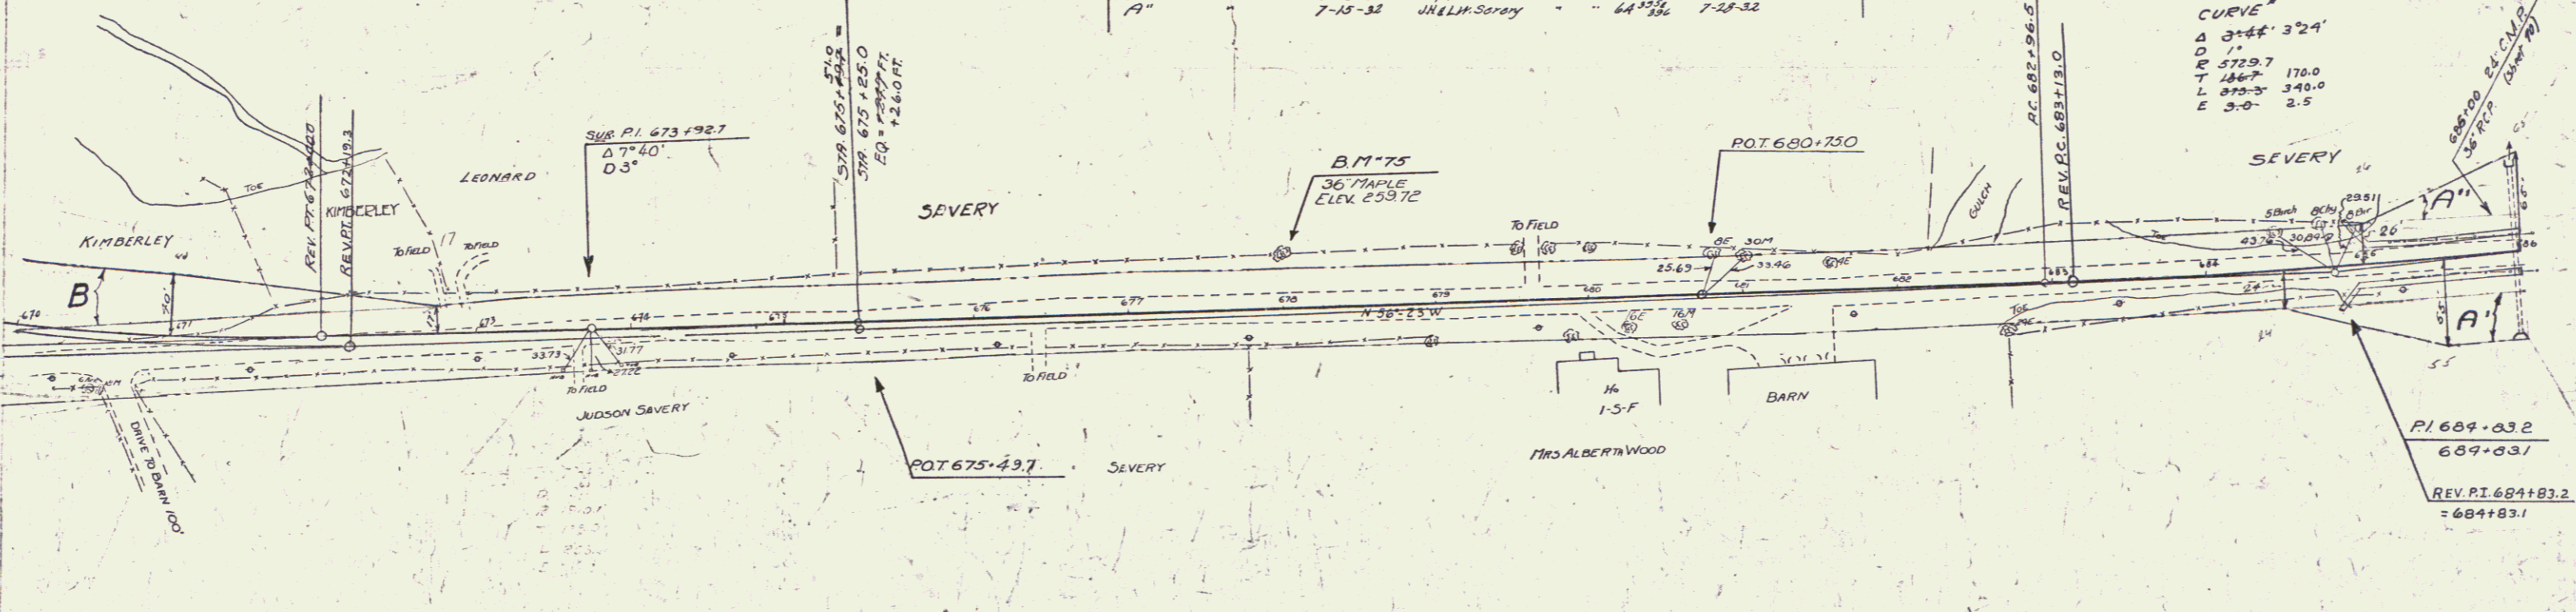

B.M. 75 SPIKE IN Root 36' MAPLE 3/4" 675+00 ELEV. 253.72

SERIES F 109A SHEET 48 OF 192

50