

WOOD GUARD RAIL REQUIRED
 CULVERT STATION LEFT RIGHT
 724+37 24' 24'



NEW REINF. CONCRETE PIPE CULVERTS REQUIRED
 STATION DIM. LENS CONCR. CONCR. REINF. STEEL
 724+37 10' 40' - 3.0% 33 lbs

CONCRETE CURB AND GUTTER REQUIRED
 STATIONS L OR R WIDTH CURB HGT CONC. R. REINF. STEEL
 729+25 - 729+00 LR 2'-0" 6" 4.8% 57 lbs.

FED. ROAD STATE PROJ. NO. YEAR
 VT. 109-A 1931 31 192

Parcel	Kind of Instrument	Date of Instrument	Grantor	Grantee	Recorded	Remarks
A	O.C.D.	A-30-31	CHAS. W. RICHARDSON	ST. J. P. RICHARDSON	Book Page Date	64 21 5-2-31

CURVE
 Δ 38°39' 42"
 D 7'
 R 8150
 T 2872
 L 5521
 E 489

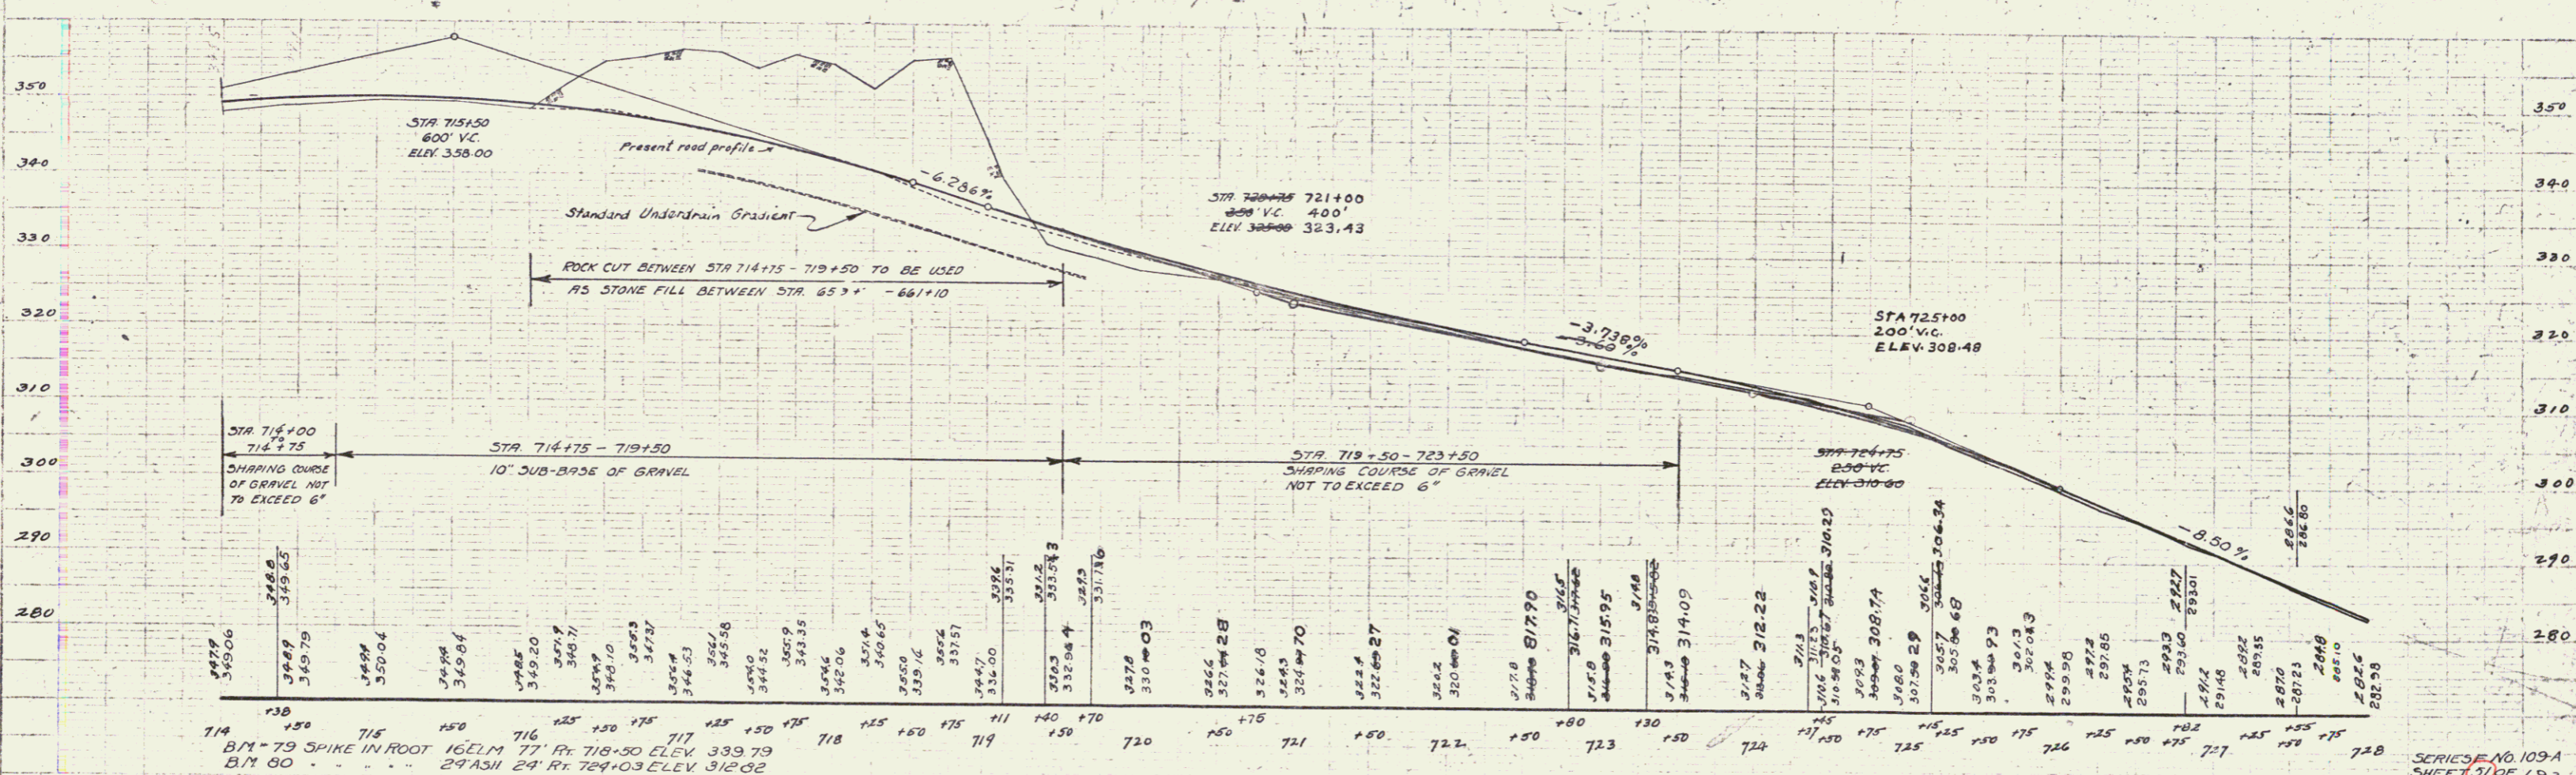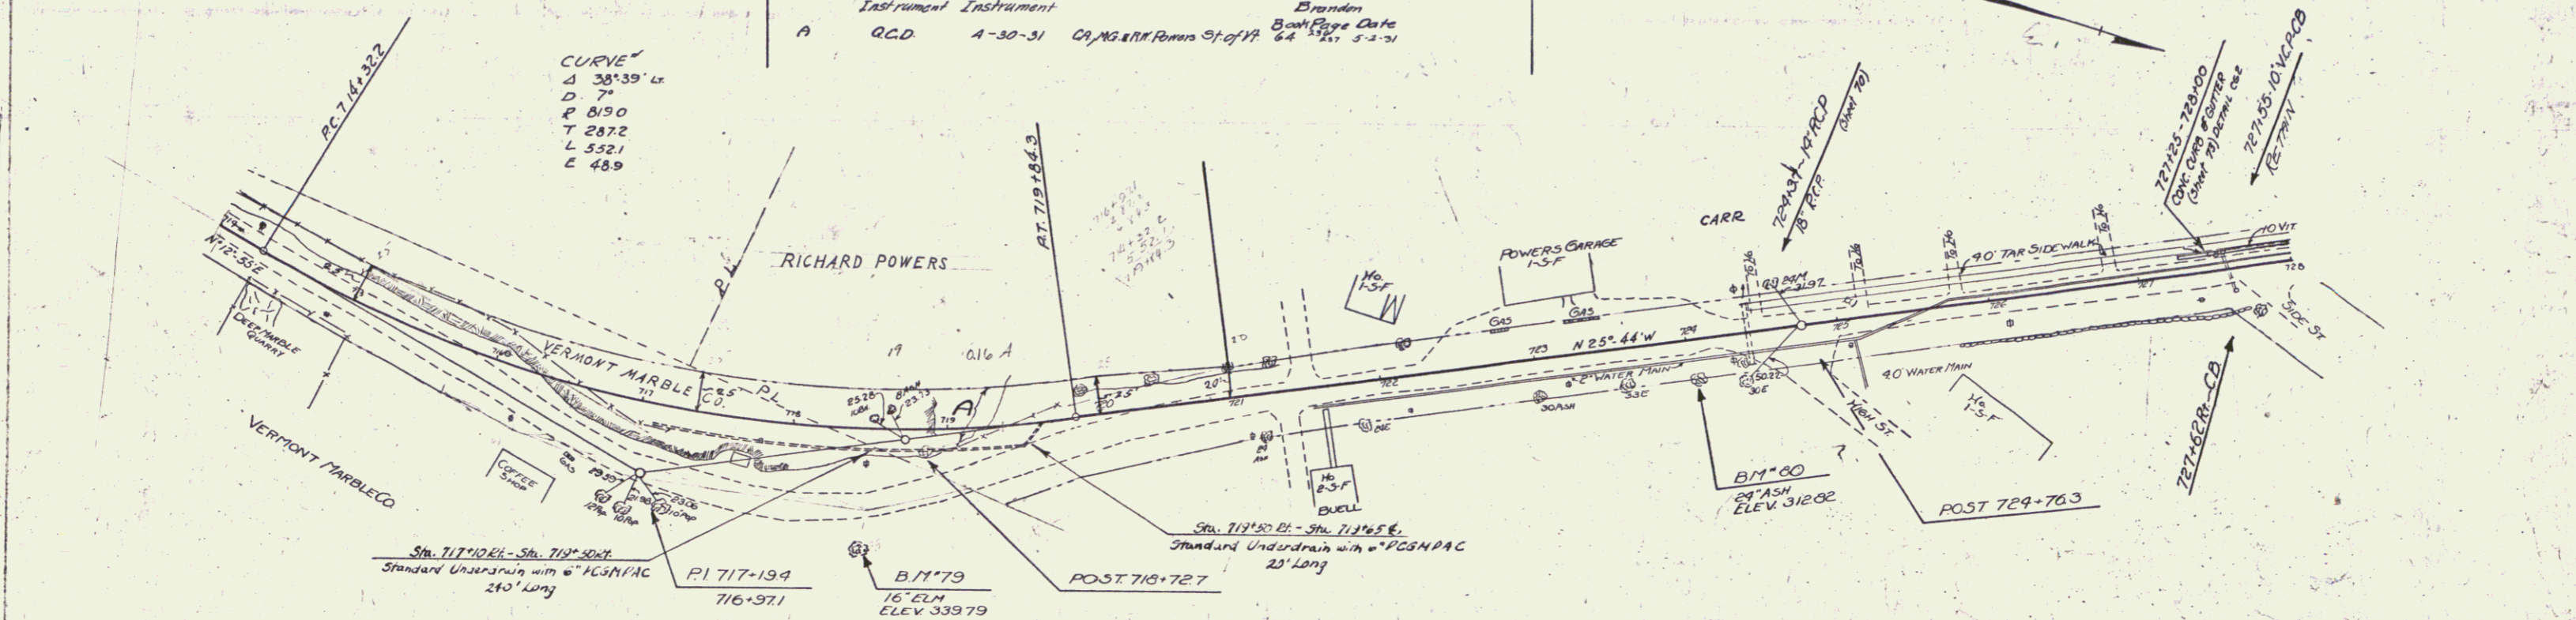

M. G. BERRY
 10-23-31
 101

SERIES NO. 109-A
 SHEET 31 OF 192

53