


FED. ROAD DIST. NO.	STATE	FED. AID	PROJECT SHEET NO.	TOTAL SHEETS
1097(2)	VT		1941	4

PLAN	DATE
DESIGNED BY	
CHECKED BY	
DATE	

PROFILE	DATE
DESIGNED BY	
CHECKED BY	
DATE	

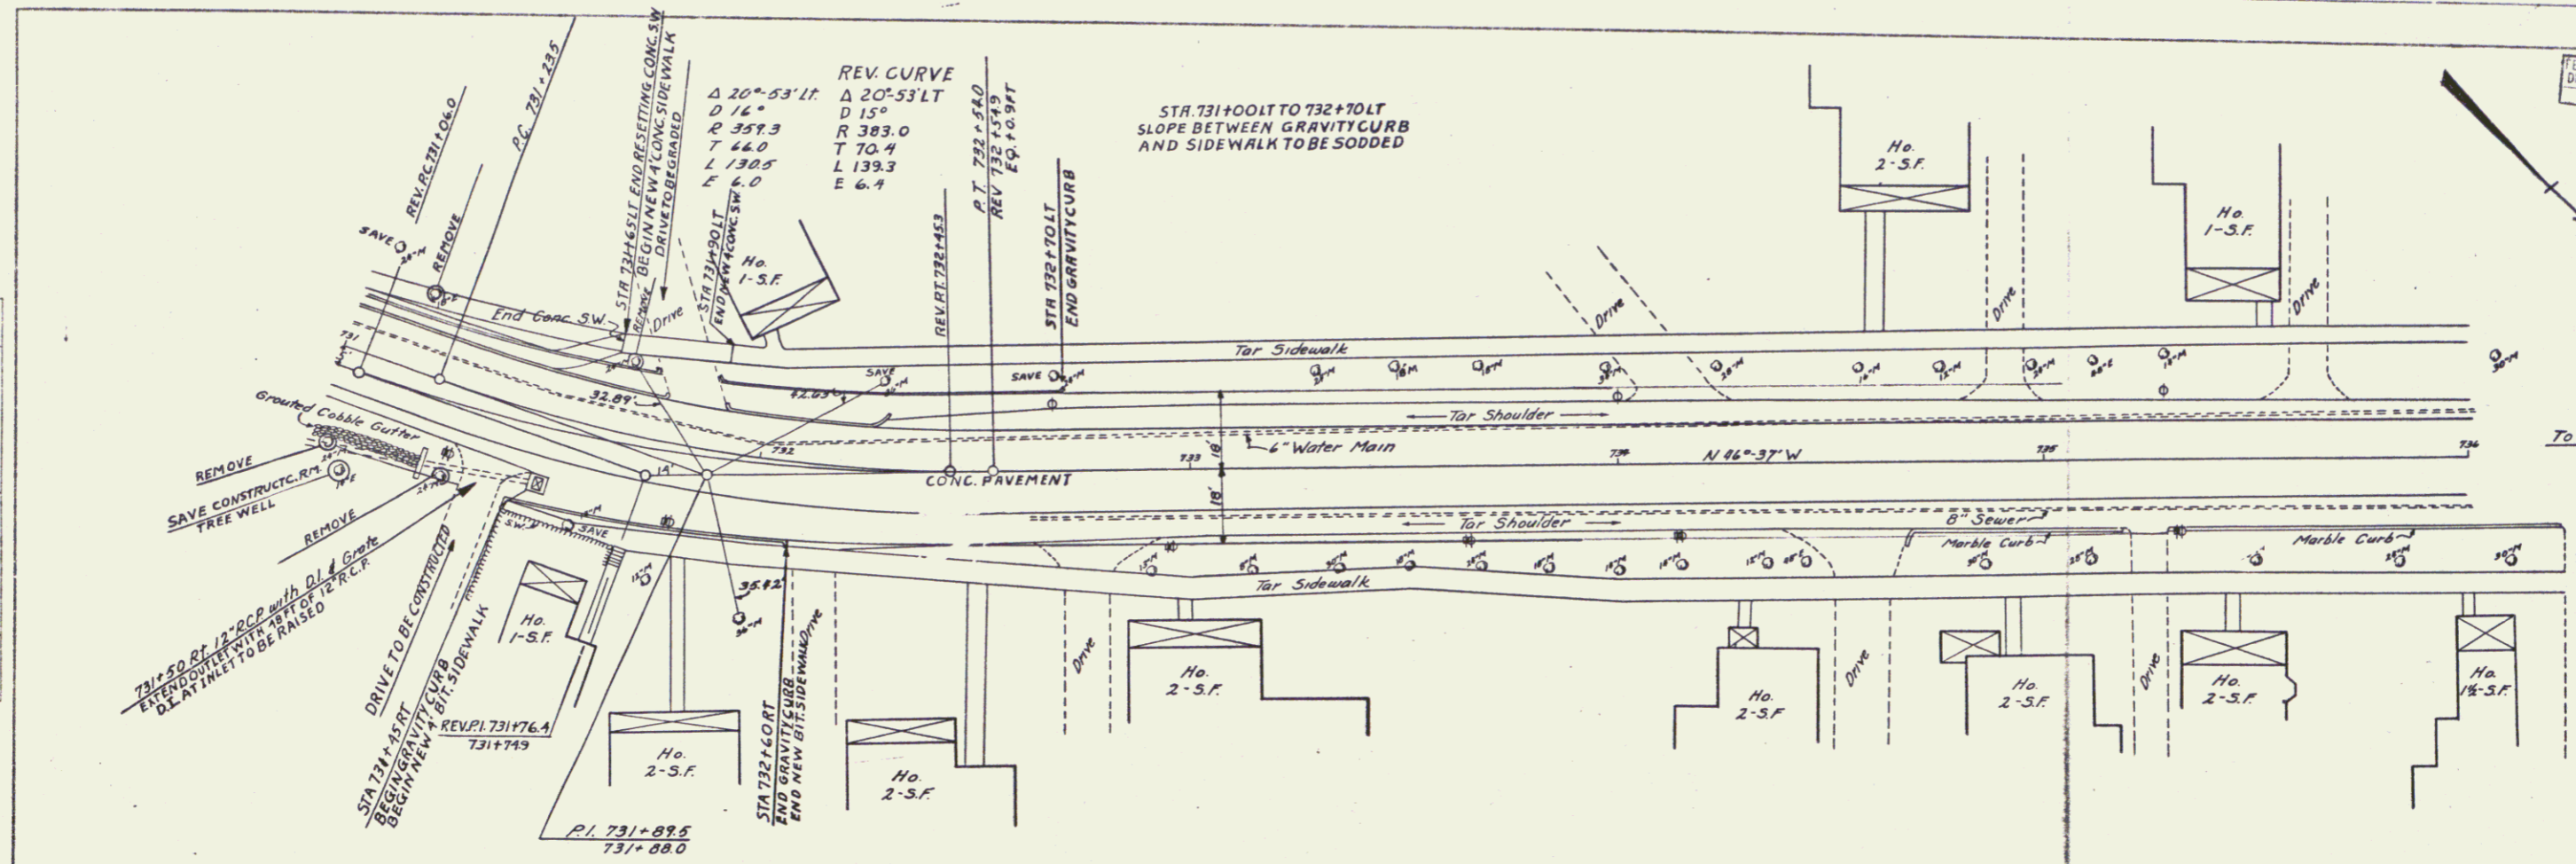

BRANDON VILLAGE F.A.P. 103A
 WIDENING US 1 TO 36 FT CURB TO CURB
 STA 730+00 - 733+00
 SCALE 1" = 20 FT
 SHEET 2 OF 4 SHEETS