


FED. ROAD DIST. NO.	STATE	FED. AID P.C.	FISCAL YEAR	SHEET NO.	TOTAL SHEETS
9	VT	109-A	1931	17	17

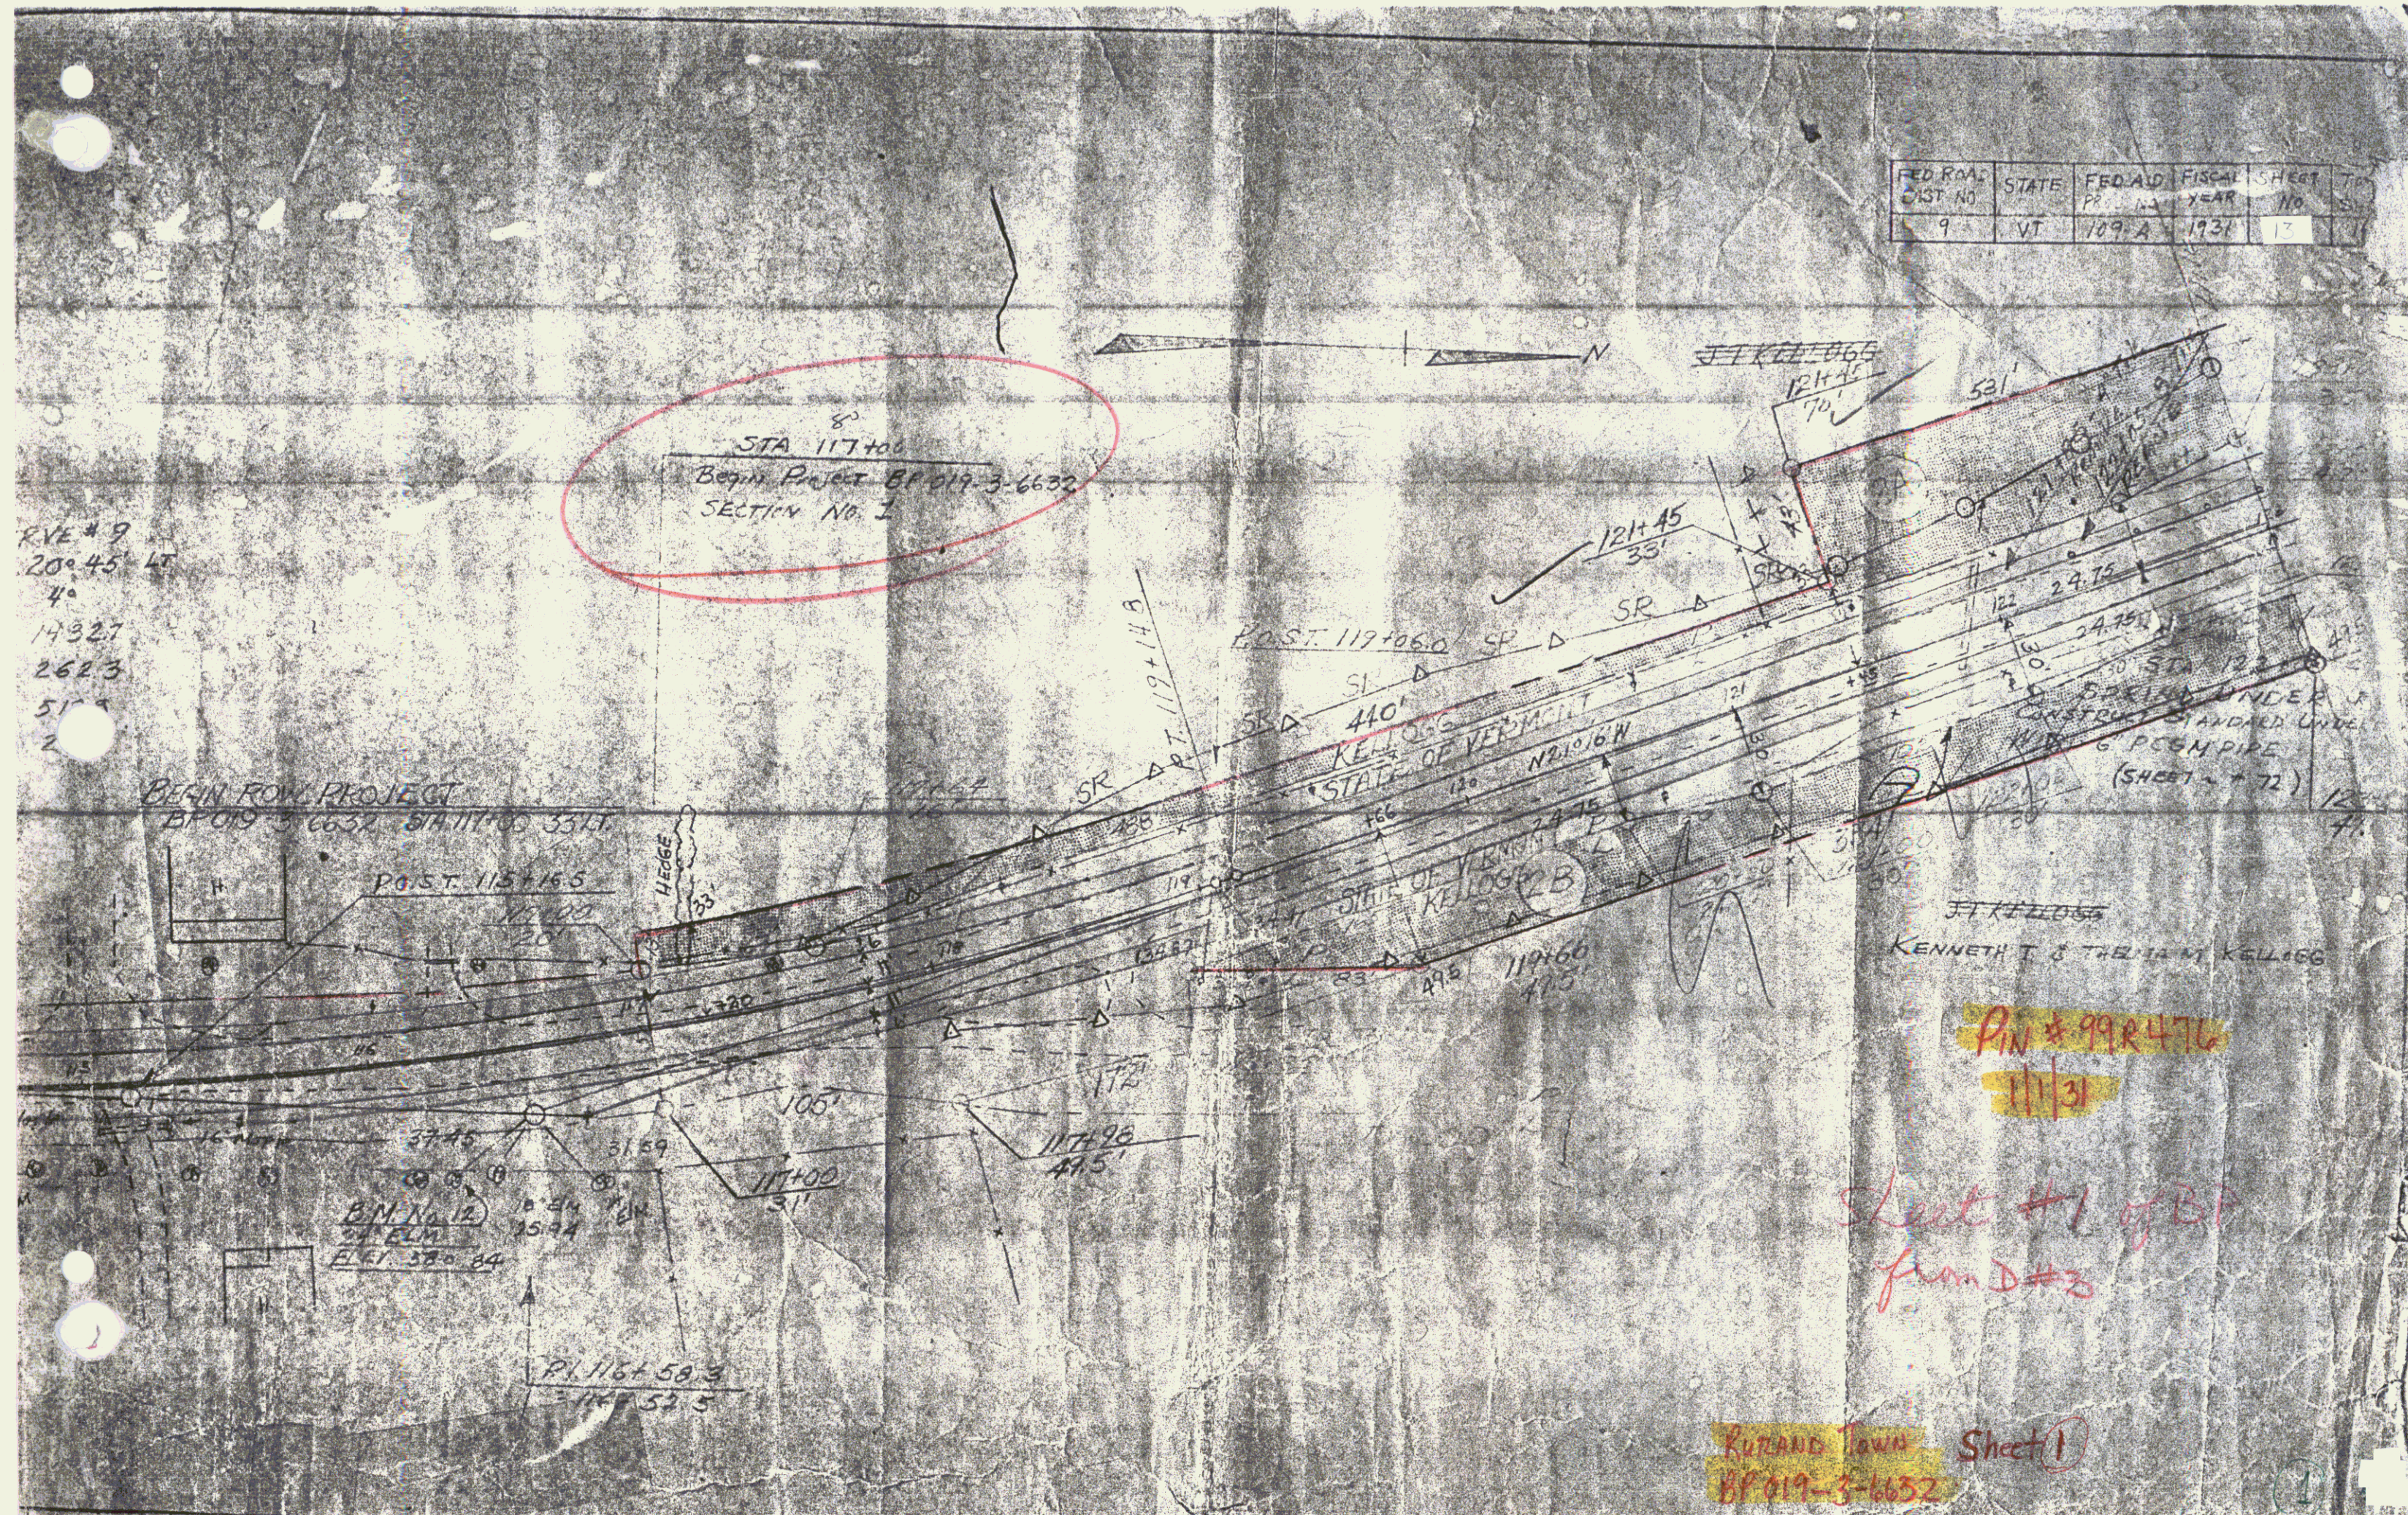

R.V.E. # 9
20° 45' 45"
4°
14327
262.3
51.9
2

KENNETH T. & THELMA M. KELLOGG

Pin # 99R476
11/31

Sheet #1 of BP
from D#3

Rutland Town Sheet 1
BP 019-3-6632