

CURB GUARD RAIL REQUIRED

STATIONS	LENG.	CONSTANT	PIV. LENGTH
153+00-161+52 RT	352'	40'	392'

WOOD GUARD RAIL REQUIRED

CULVERT STA.	LEFT	RIGHT
156+60	24'	24'
160+96	24'	24'
164+91	24'	—

NEW REIN. CONCRETE PIPE CULVERTS REQUIRED

STATION	DIAM.	LENG.	CONG. A	CONG. C	REIN. STEEL
156+60	18"	44'	1.0 cy	—	52 lbs.
160+96	15"	44'	—	2.3 cy	53 lbs.


NEW REIN. CONCRETE BOX CULVERT REQUIRED

STATION	SIZE	CONG. A	CONG. C	REIN. STEEL
164+91	3.5' x 6'	26 cy	—	1766 lbs.

PLANNING STATE
 DISTRICT
 708A
 1931
 74
 192

Permit	Kind of Instrument	Date of Instrument	Grantor	Grantee	Revised	Remarks
A	C.C.D.	5-28-31	Hildah Satter	Stef. P.	41 1285	5-2-33
B	"	1-30-31	A.A. & E. Langley's	"	41 1285	5-3-31

HILDAH SALTER
 PETER & SHEILA J. KAPITAN

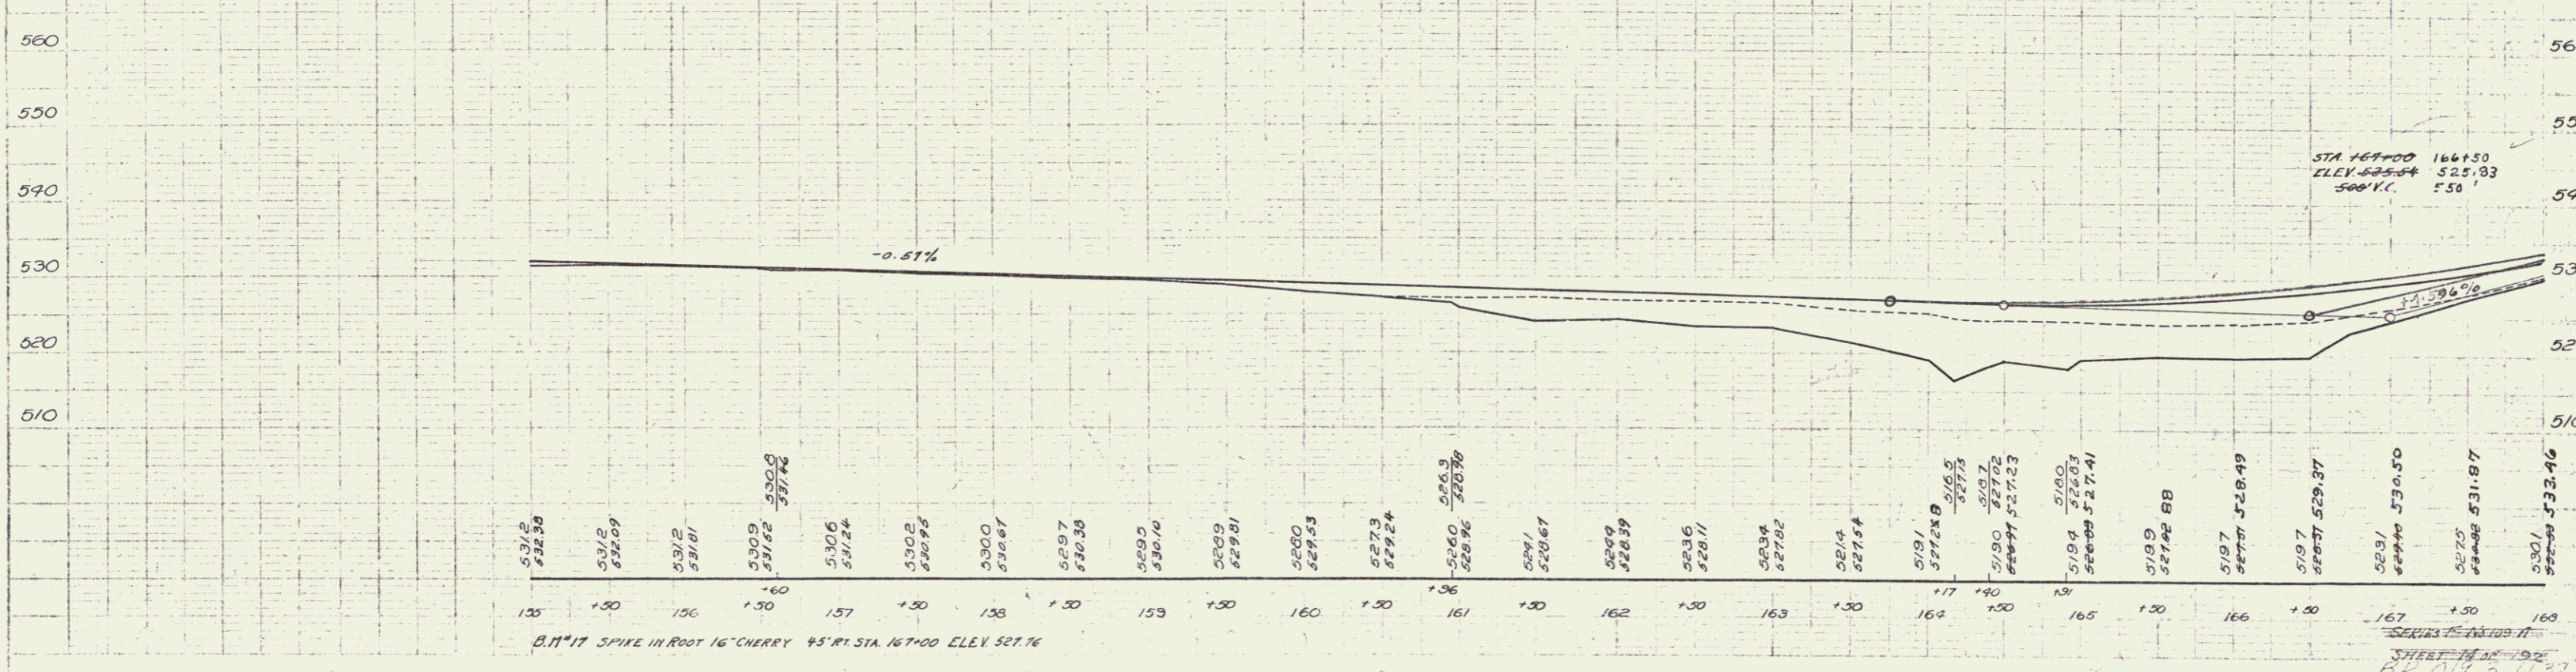

STA 167+00 166+50
 ELEV. 527.76 525.83
 500' V.C.

B.M. #17 SPIKE IN ROOT 16" CHERRY 45' RT. STA. 167+00 ELEV. 527.76

SHEET 4 OF 7