

CHOLE GUARD RAIL REQUIRED

STATIONS	LENG.	CONSTANT	NO. LENGTH
189+50-189+64 LT.	296'	40'	336'
189+50-192+50 RT.	304'	40'	344'
192+182-193+130 LT.	48'	40'	.88
192+730-194+00 RT.	160'	140'	200
193+66-194+66 LT.	80'	40'	120



NEW REIN. CONCRETE BOX CULVERT REQUIRED

STATION	SIZE	CONC.	REIN. STEEL
191+62	3x3	2444	1682 162

Parcel	Kind of Instrument	Date of Instrument	Owner	Grantee	Recorded Plat No.	Remarks
A	Q.C.D.	5-9-31	F.J. DeForge	Stef. H.	41 137-2	5-22-31
A'	"	5-28-31	W.F. Baird	"	41 138-1	5-28-31
B	"	5-28-31	Hubert Salter	"	41 135-6	5-28-31

appears no acquisitions were made from Hubert Marcell, Shelvey & Hotel in 1969 for B.P. project
 E.C. WHEELER
 A. NEWMAN

CURVE #13
 A 19'14"
 D 3"
 R 1910.1
 T 323.6
 L 641.1
 E 27.2

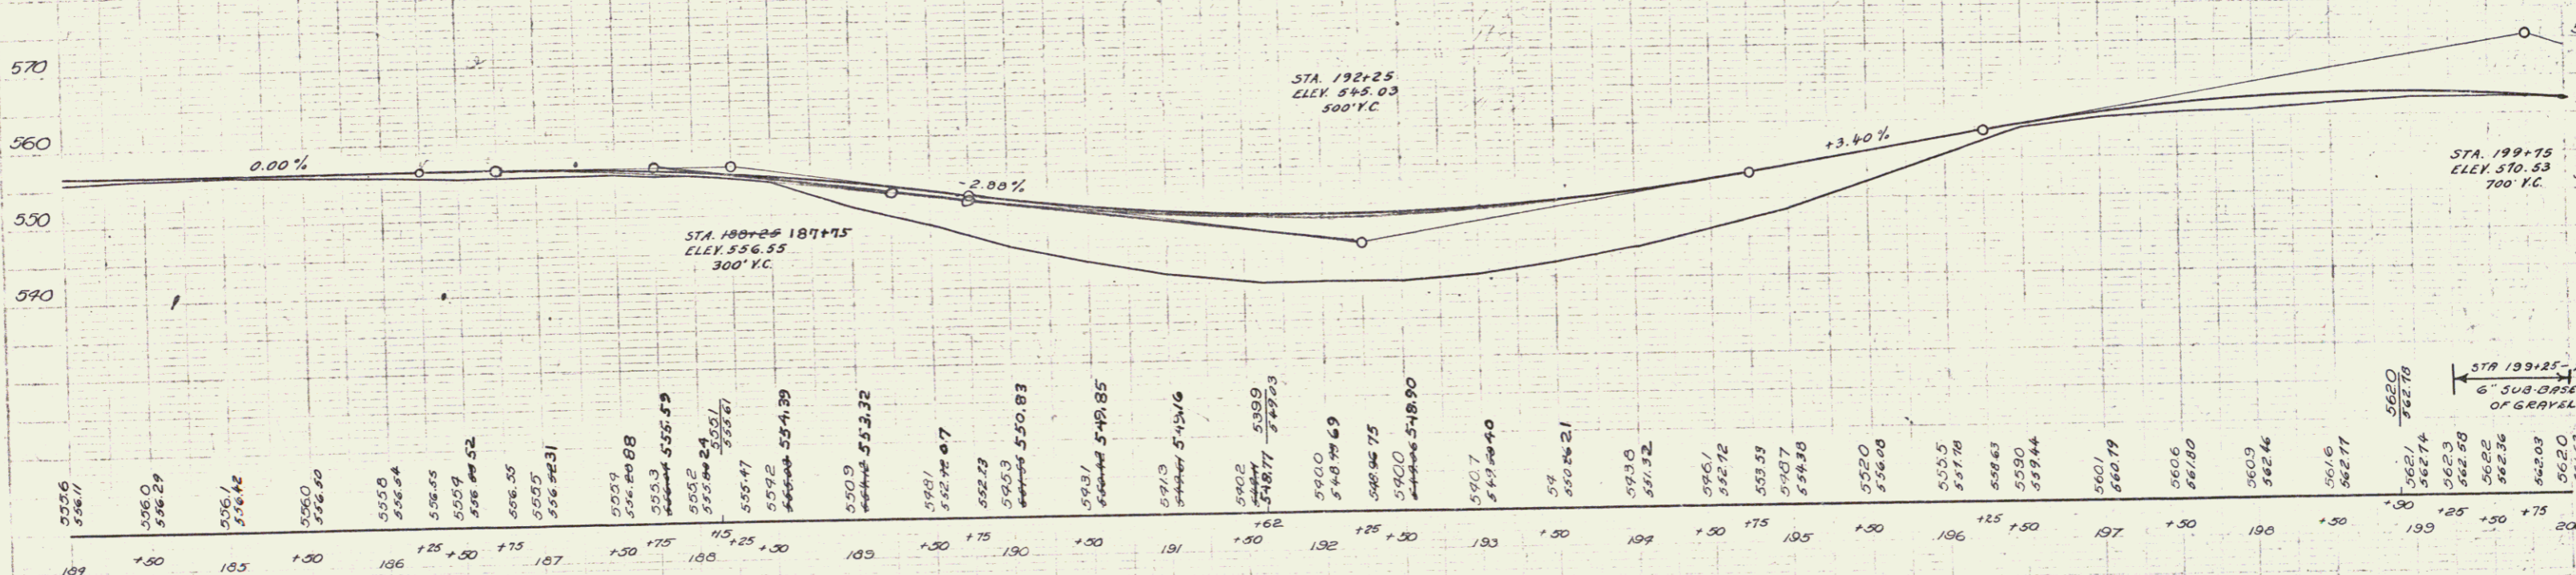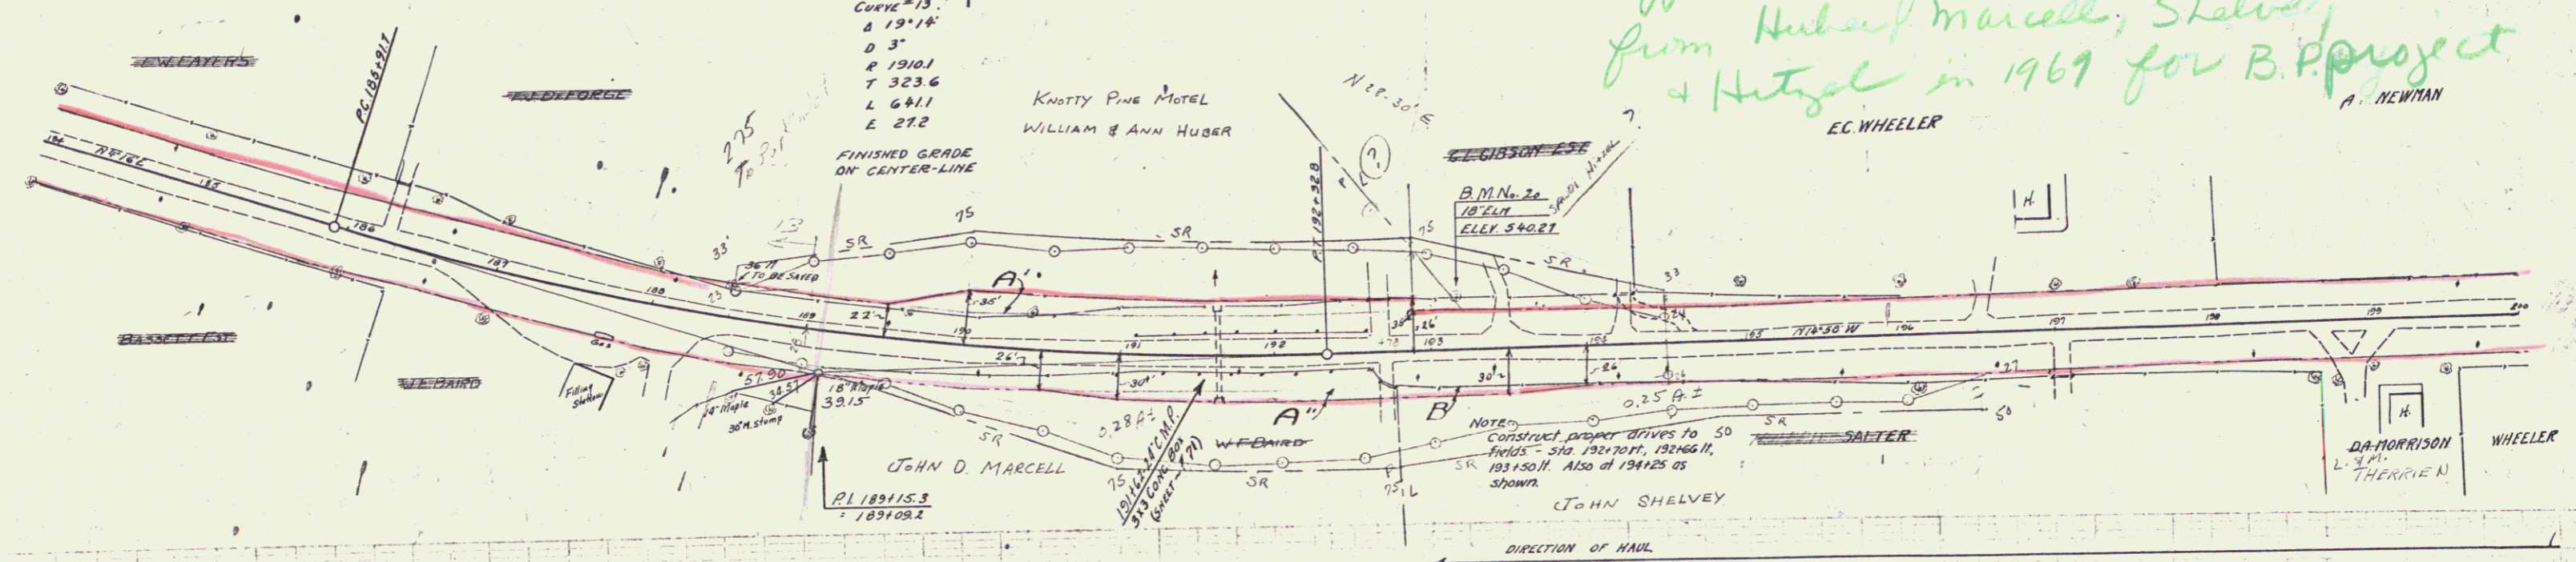

0.17" #20 SPIKE IN ROOT 18" Lx11 32" Lx1. STA. 193+18 ELEV. 540.27