


FED. ROAD DIST. NO.	STATE	FED. AID P.C.	FISCAL YEAR	SHEET NO.	TOTAL SHEETS
9	VT	109-A	1931	17	

STA 117+00
 Begin Project BP 019-3-6632
 SECTION NO. 1

R.V.E. # 9
 20° 45' 45"
 4°
 14327
 262.3
 51.5
 2

BEGIN ROW PROJECT
 BP 019-3-6632 STA 117+00 331.1

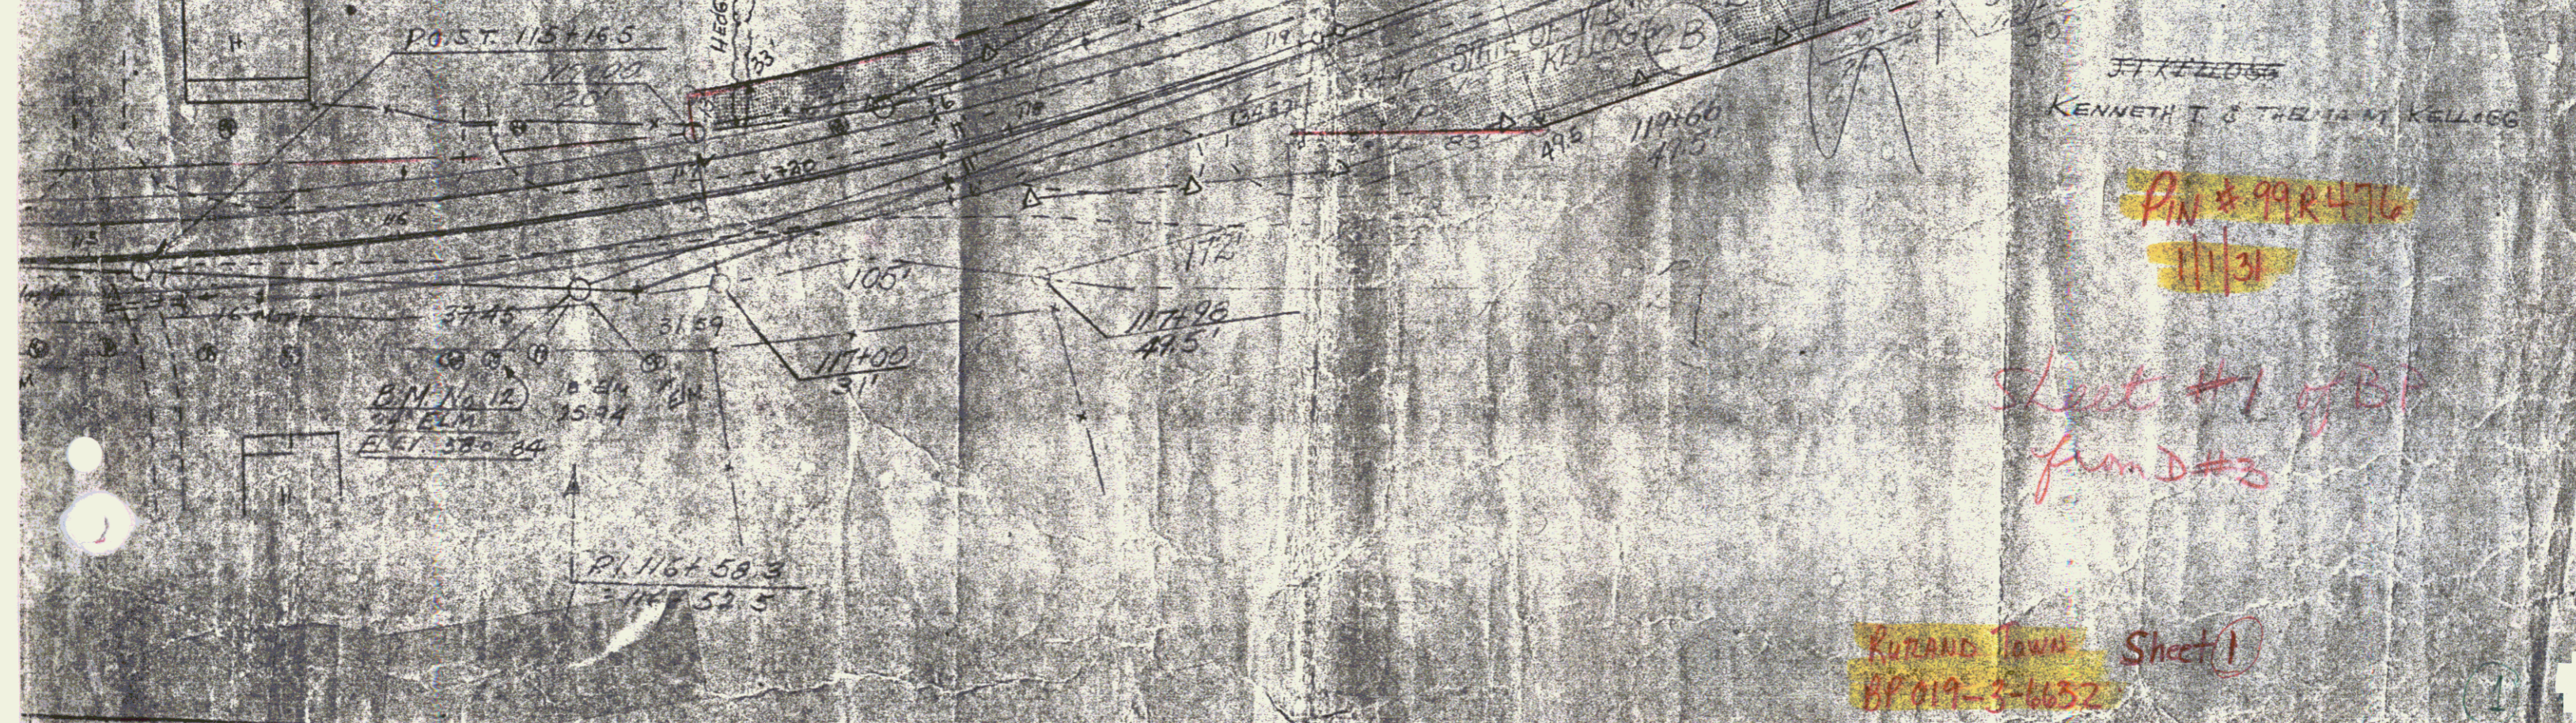

WOOD GUARD RAIL REQUIRED

CULVERT STATION	LEFT	RIGHT
124+30	24'	24'
129+36	24'	24'
135+29	24'	24'

CABLE GUARD RAIL REQUIRED

STATIONS	LENS CONSTANT	PIV. LENGTH
123100-126120 LT.	349'	20'
126100-129100 LT.	100'	20'
129100-132100 RT.	100'	20'

NEW REIN. CONCRETE PIPE CULVERTS REQUIRED

STATION	DIAM.	LENS	CONC. A	CONC. B	REIN. STEEL
125+30	18"	40'	~	3 1/2"	33 lbs.
129+36	15"	40'	~	2 1/2"	33 lbs.
135+29	15"	40'	~	2 1/2"	33 lbs.

STANDARD UNDERDRAIN REQUIRED



(6" PAV. C.G.M. PIPE)

STATIONS	LENS	CEMENT RUBBLE MASONRY
125+50 RT. - 129+50 LT.	410'	10 cubic yards

STATE OF VERMONT
 DISTRICT 1
 109 A 1931 192

Parcel	Kind of Instrument	Date of Instrument	Grantor	Grantee	Recorded Book Page	Date	Remarks
B	G.C.D.	4-30-31	J.T. Kellogg	State of Vt.	8	6-3-31	Drain Sta. 123+50
A, B, C, D	Chin. #1	12-30-31	M.K. Fish et al	State of Vt.	8	2-15	

right-of-way
See Town file for more information
J. Lewis 10/31/85

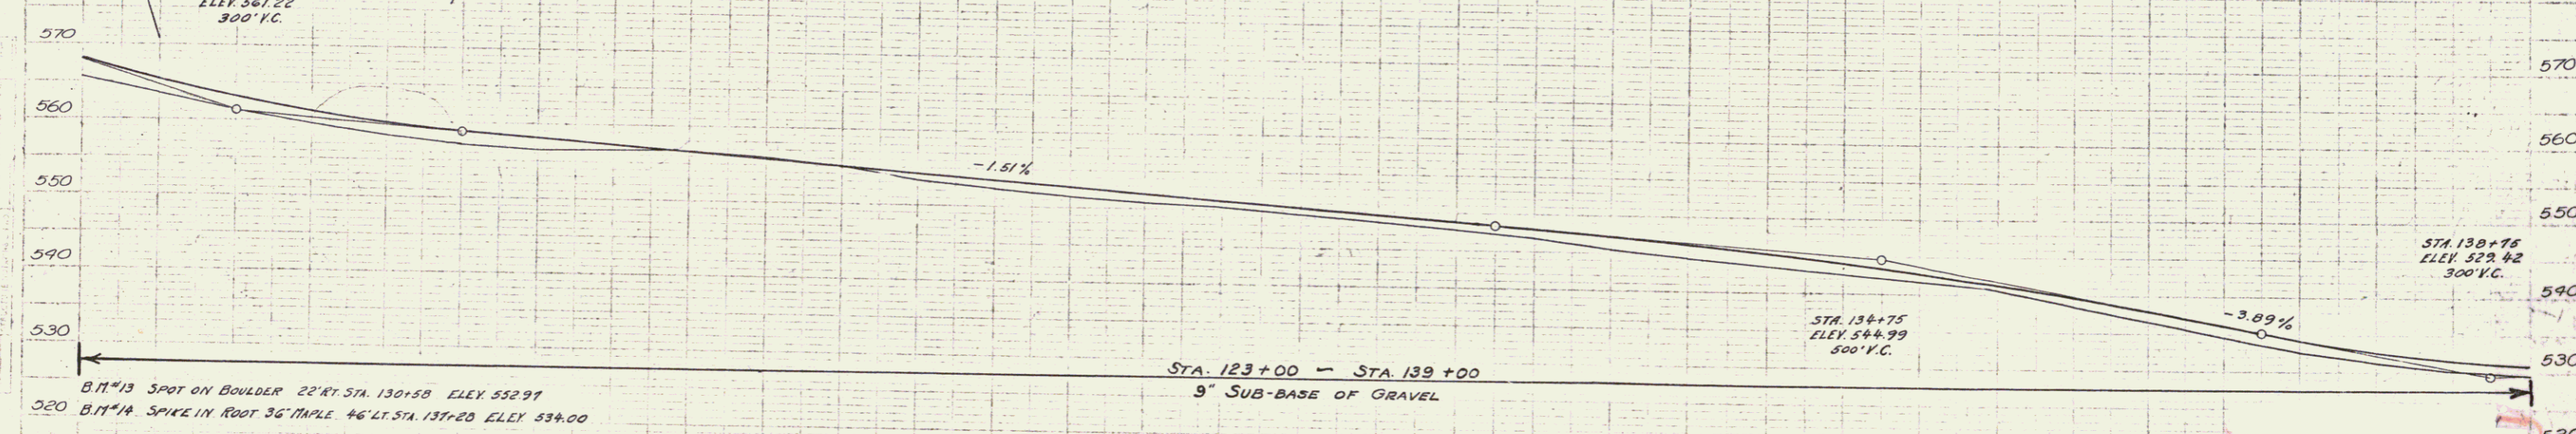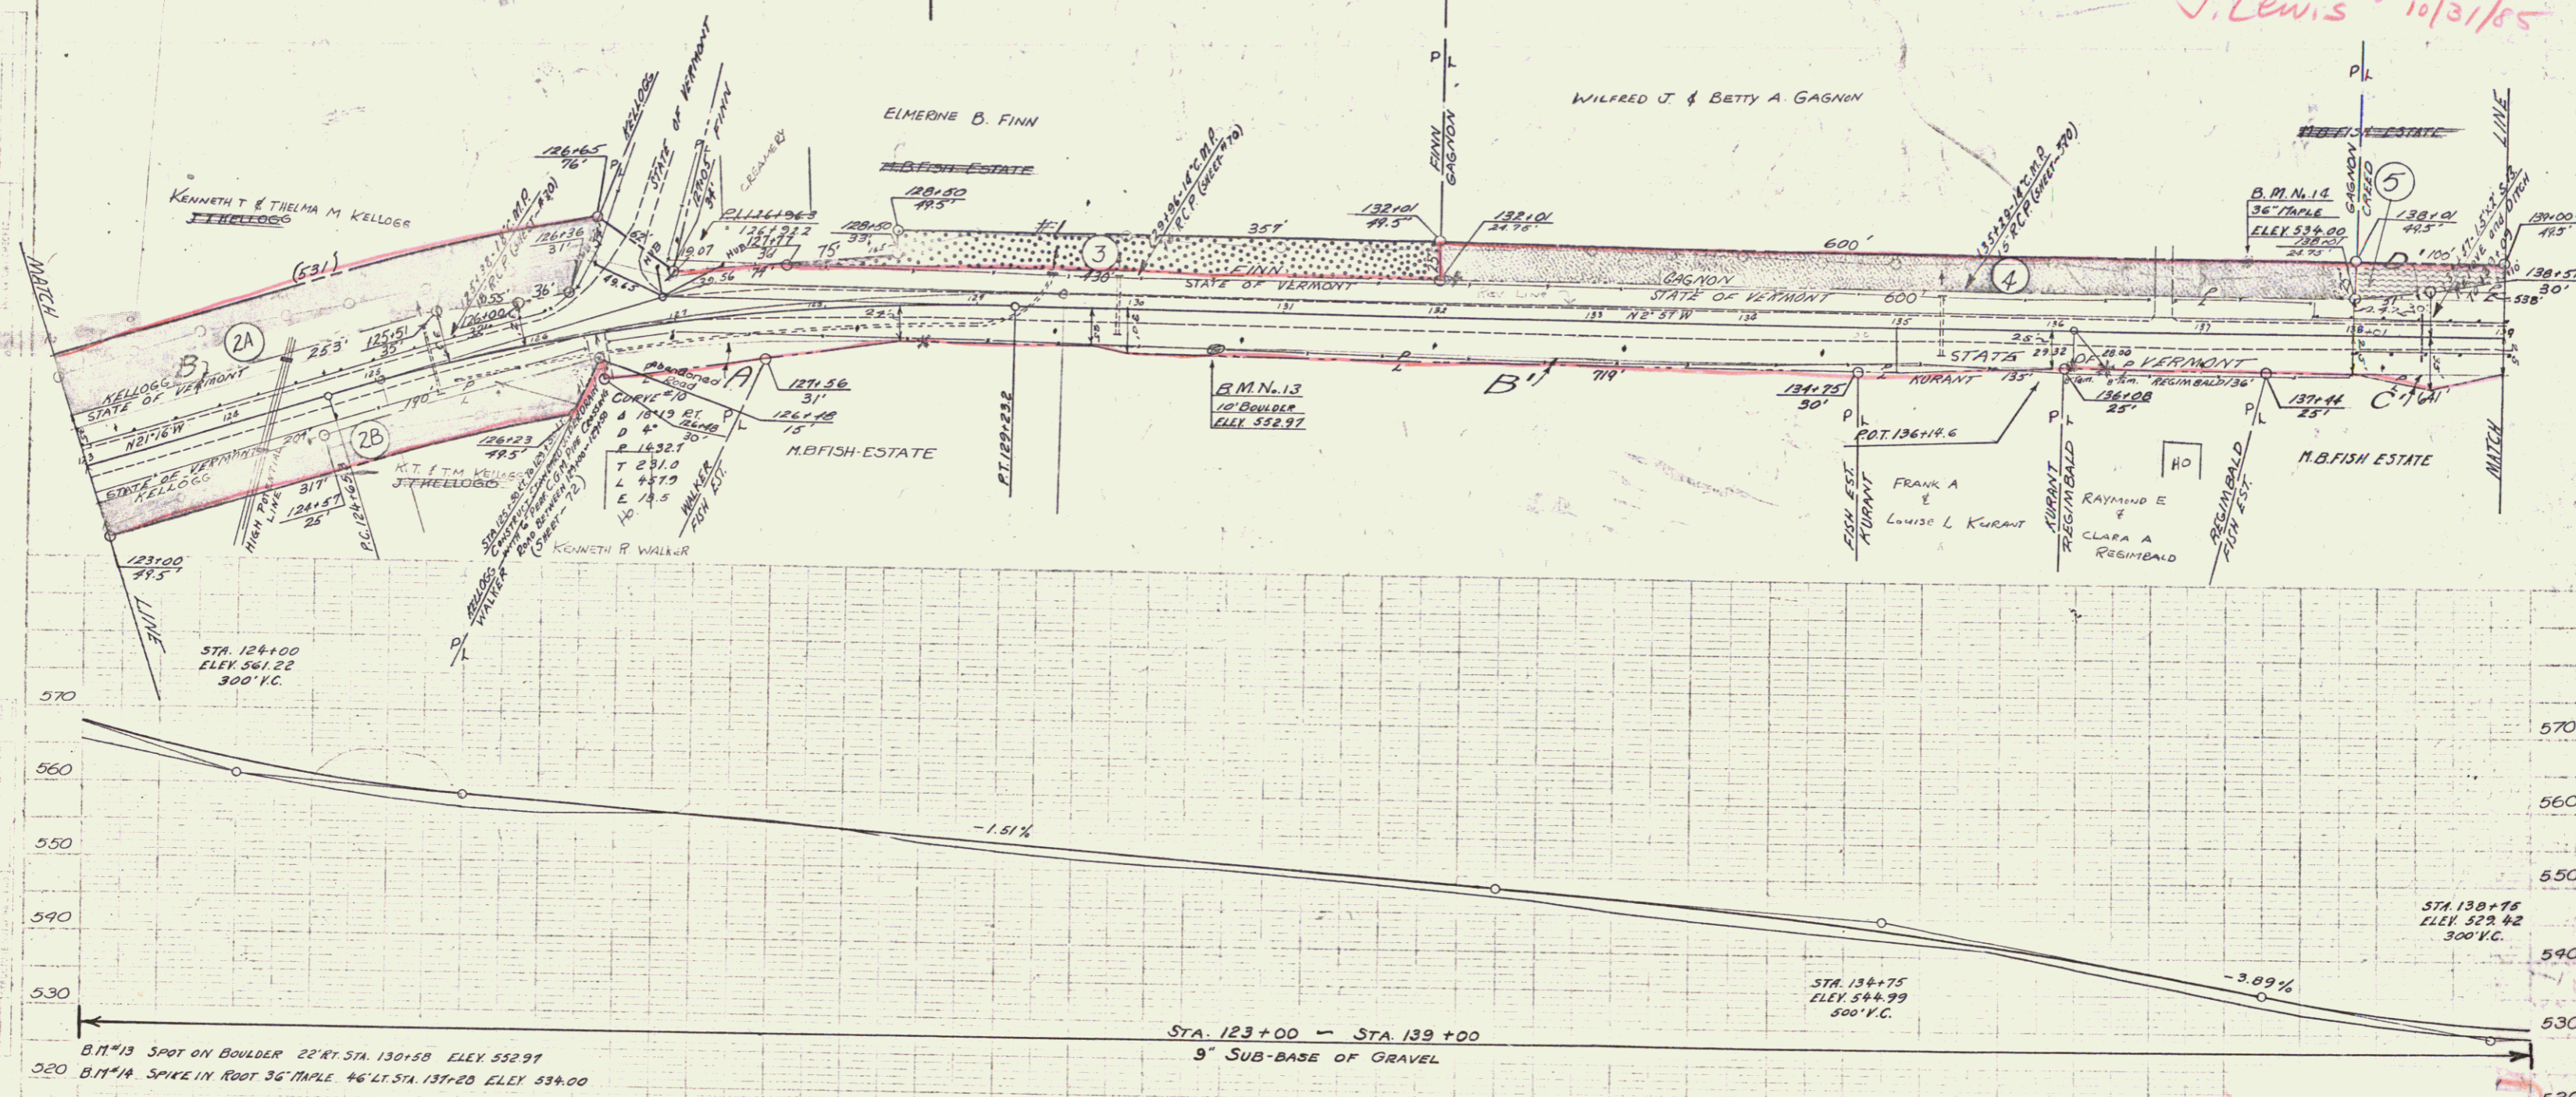

565.0	563.6	561.4	559.7	558.1	557.2	556.6	555.8	555.0	554.3	553.2	552.2	551.4	550.2	549.2	548.6	547.9	547.4	546.9	546.2	545.6	544.8	544.3	543.8	543.4	543.0	542.8	542.6	530.0
-------	-------	
SHEET 13 OF 127
 BE 017-3-6632
 SHEET 2 OF 7



WOOD GUARD RAIL REQUIRED				CABLE GUARD RAIL REQUIRED			
CULVERT STATION	LEFT RIGHT	STATION	LENG	SPACING	PIV LENGTH	STATION	LENG
145123	24	24	139100-140130 LT	190'	20'	139100-139140 RT	40'
150106	24	24	148150-152102 LT	352'	40'		392'

NEW REINFORCED CONCRETE PIPE CULVERTS REQUIRED			
STATION	DIAM	LENG	CONCRETE REINFORCING
139103	30"	44'	3.2 cy
150106	10"	44'	3.0 cy

CULVERT REPAIRS REQUIRED			
STATION	TYPE	EXTENSION	CONCRETE REINFORCING
145123	2125	7'0" RT	0.8 cy
			333 lbs

DRIVEWAY PIPE CULVERTS REQUIRED			
STATION	LENG	DIAM	CONCRETE REINFORCING
150125	12'	24"	2.3 cu yds

Found	Kind of Instrument	Date of Instrument	Quantity	Granted	Recorded	Remarks
A	O.C.D.	5-28-31	W. S. S. S. S.	11	185	3-3-31 F. H. H.
A'	"	4-30-31	J. H. H.	11	182	5-3-31
C & D	"	4-30-31	J. H. H.	0	182	6-3-31 R. H. H.
D'	"	12-30-31	W. H. H.	0	115	

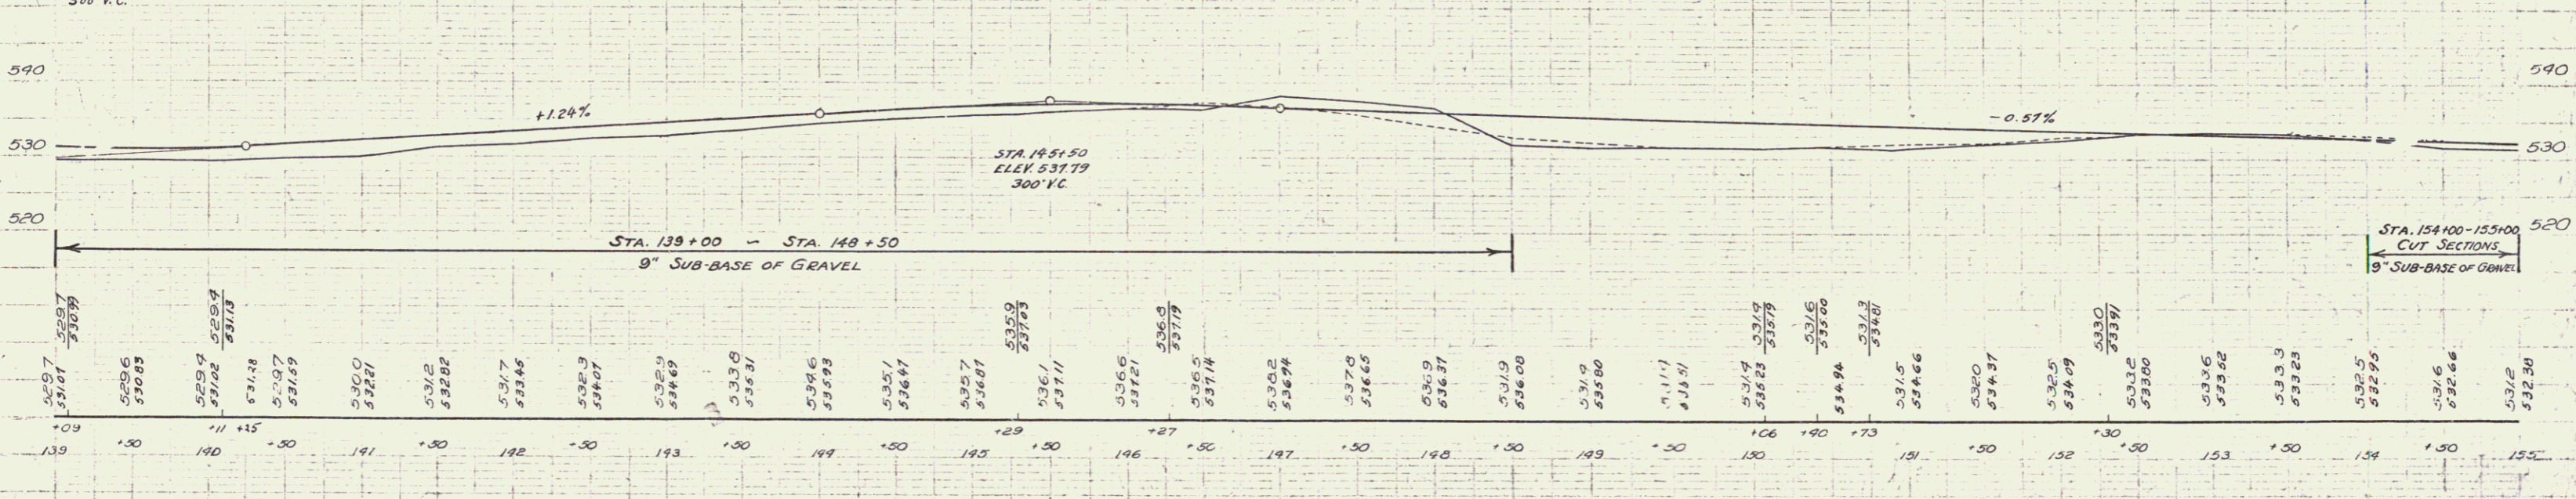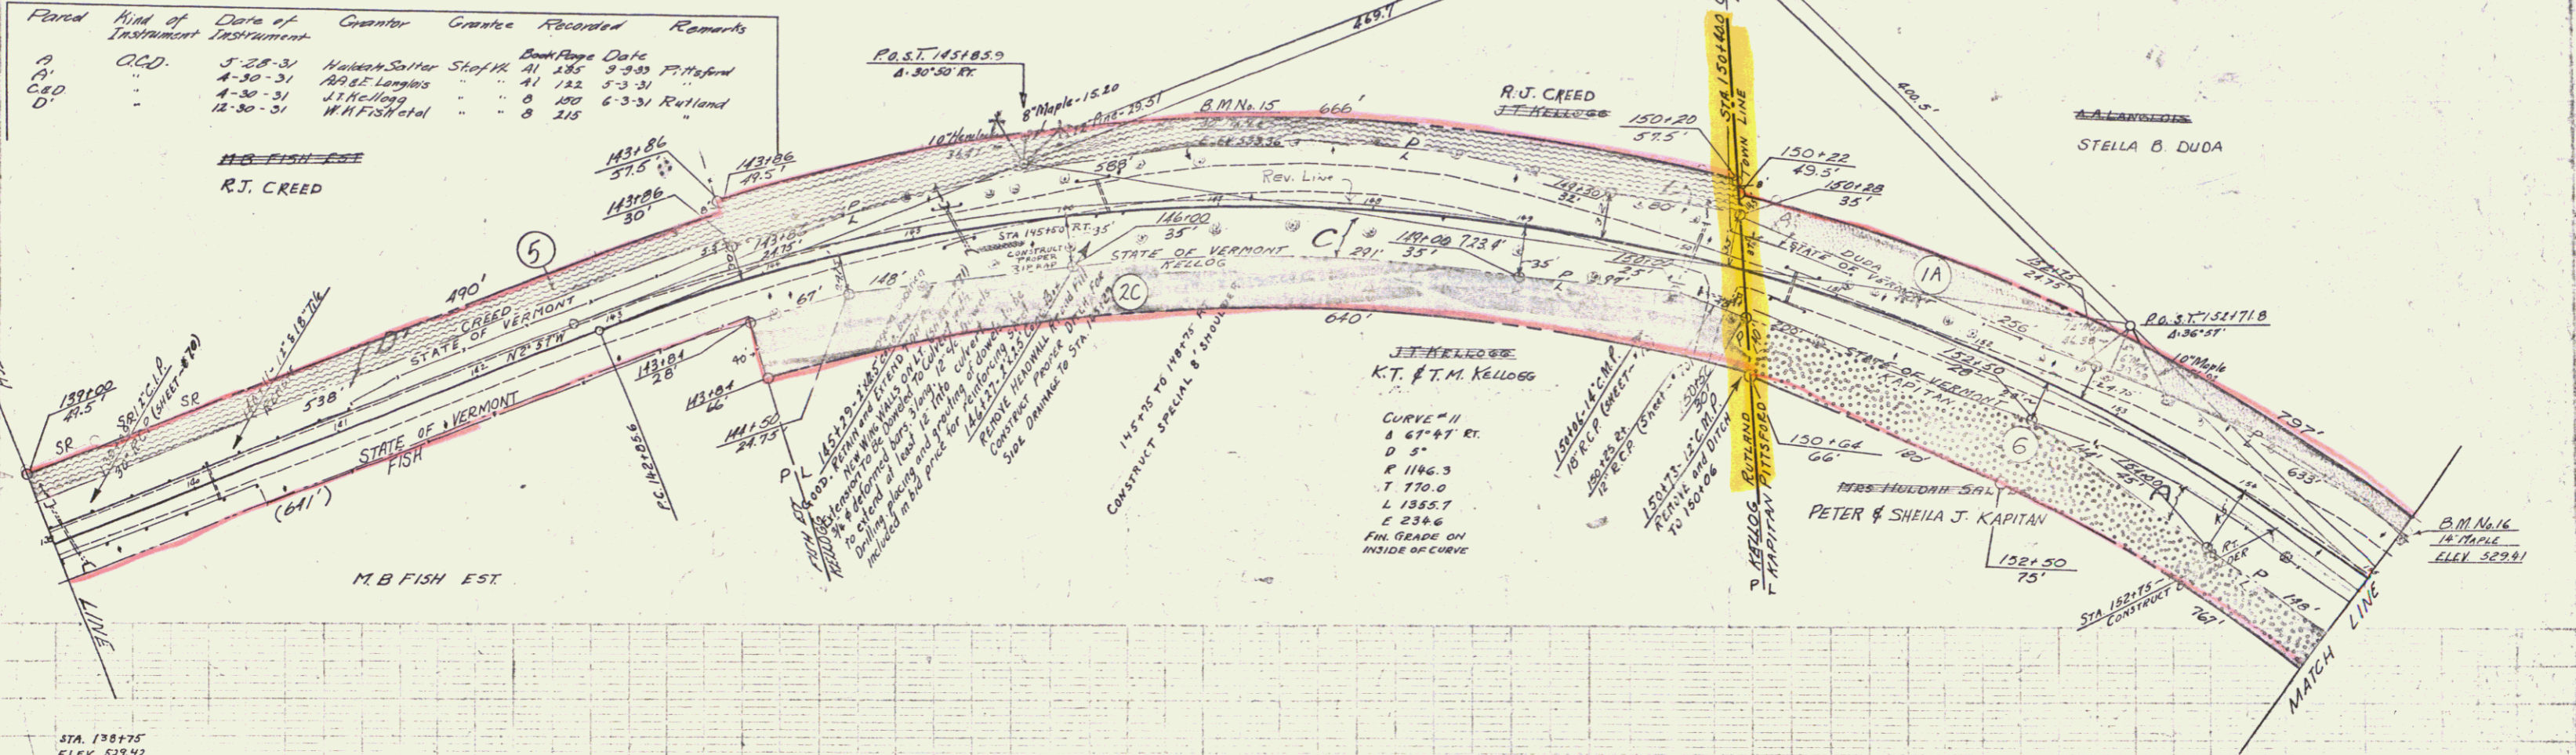

B.M. #15 SPIKE IN ROOT 30" MAPLE 95' LT. STA. 146+08 ELEV. 533.36
 B.M. #16 SPIKE IN ROOT 14" MAPLE 29' LT. STA. 155+04 ELEV. 529.41

STA. 139+00 - STA. 148+50
 9" SUB-BASE OF GRAVEL

STA. 154+00 - 155+00
 CUT SECTIONS
 9" SUB-BASE OF GRAVEL

SERIES P-2105-R
 SHEET 13-2-2002
 B.P. 017-3-6634
 SHEET 3 of 7

CURB GUARD RAIL REQUIRED

STATIONS	LENG.	CONSTANT	PIV. LENGTH
163+00-165+52 RT	352'	40'	392'

WOOD GUARD RAIL REQUIRED

CULVERT STA.	LEFT	RIGHT
156+60	24'	24'
160+96	24'	24'
164+91	24'	—

NEW REIN. CONCRETE PIPE CULVERTS REQUIRED

STATION	DIAM.	LENG.	CONG. A.	CONG. C.	REIN. STEEL
156+60	18"	44'	1.0 cy	—	5# 1/2s
160+96	15"	44'	—	2.3 cy	5# 1/2s


NEW REIN. CONCRETE BOX CULVERT REQUIRED

STATION	SIZE	CONG. A.	CONG. C.	REIN. STEEL
164+91	3' x 4'	26 cy	—	176# 1/2s

PLANNING STATE
 DISTRICT
 708A
 1931
 74
 192

Permit	Kind of Instrument	Date of Instrument	Grantor	Grantee	Recorded	Remarks
A	C.C.D.	5-28-31	Hildah Satter	Stef. P.	41 125	5-2-33
B	"	1-30-31	A.A. & E. Langley's	"	41 125	5-3-31


HILDAH SALTER
 PETER & SHEILA J. KAPITAN

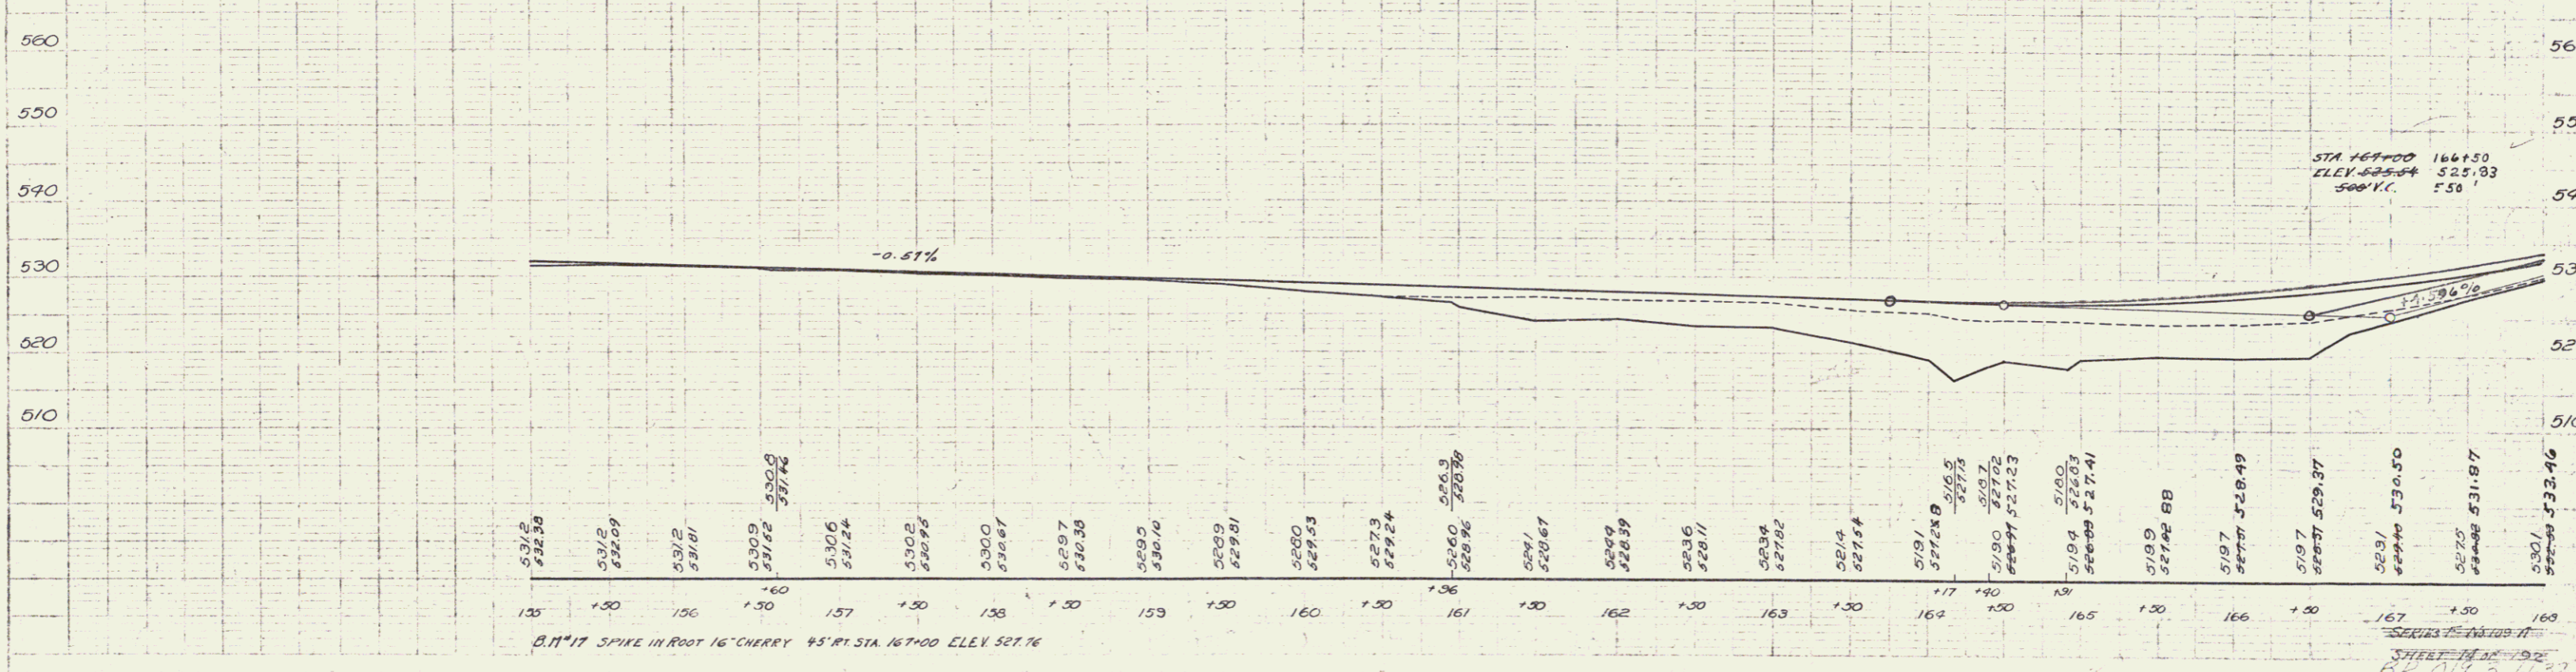

STA 167+00 166+50
 ELEV. 527.76 525.83
 500' V.C.

B.M. #17 SPIKE IN ROOT 16" CHERRY 45' RT. STA. 167+00 ELEV. 527.76

SHEET 4 OF 7

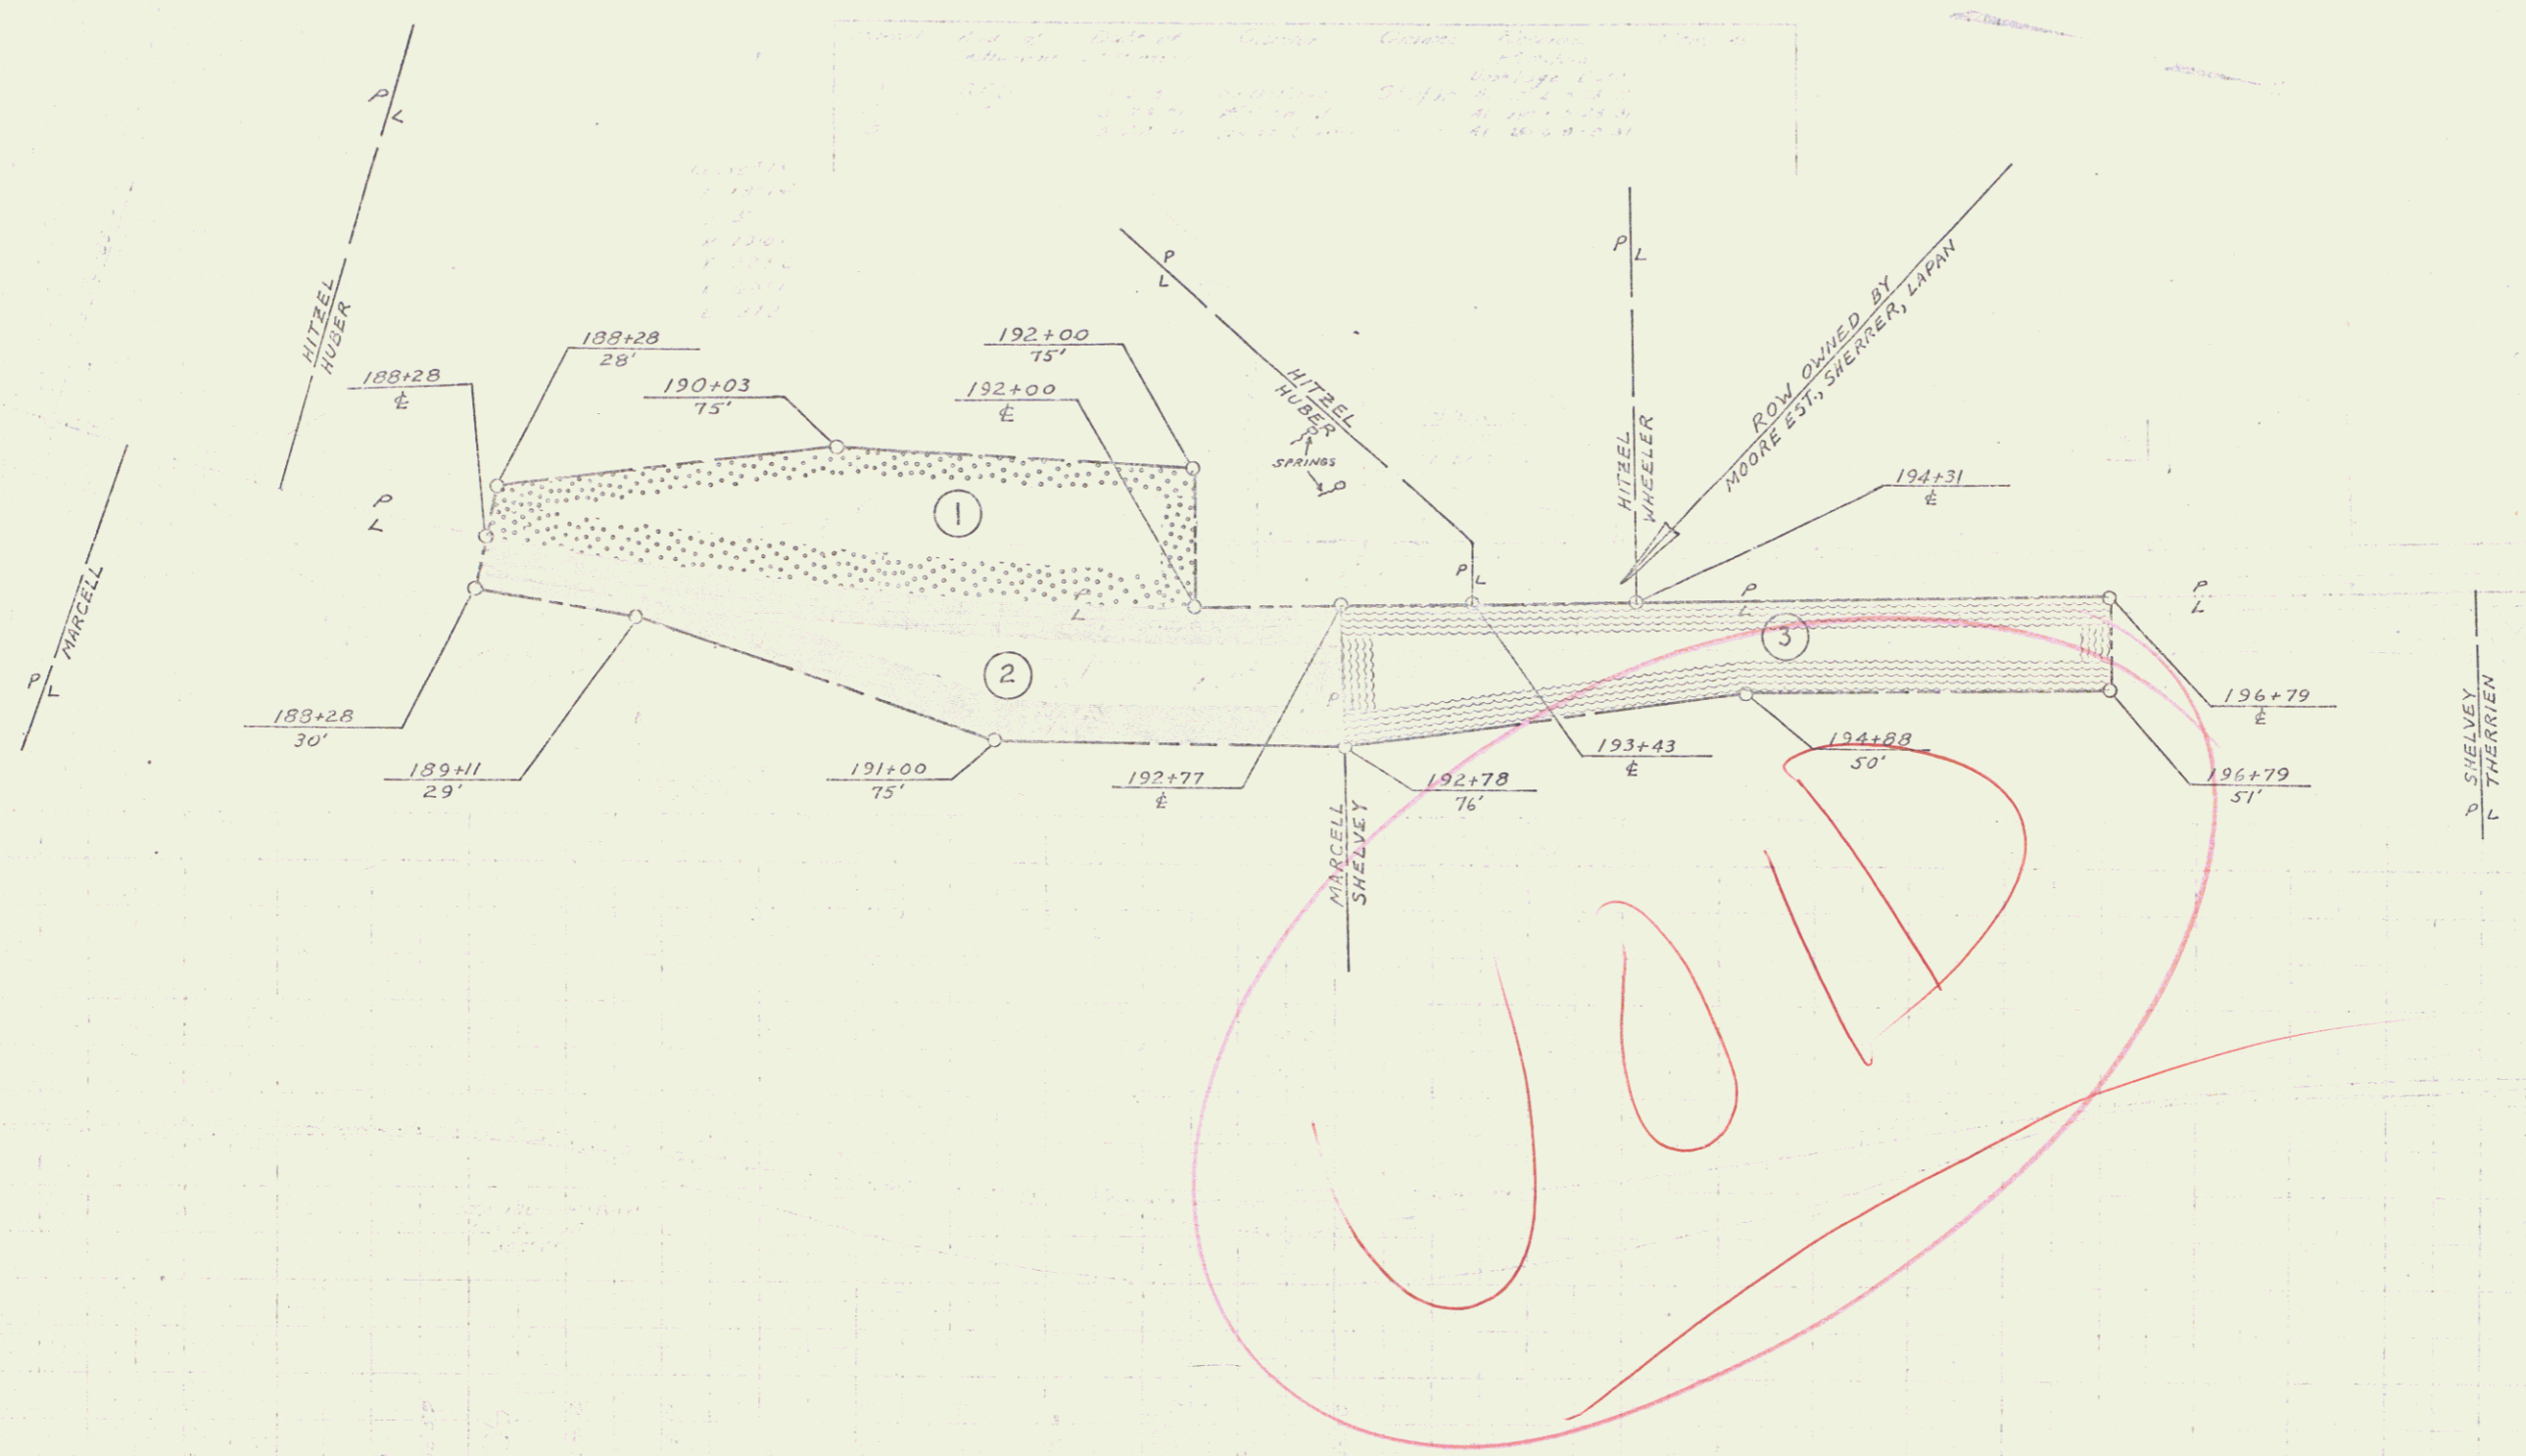

ALL INFORMATION CONTAINED
 HEREIN IS UNCLASSIFIED
 DATE 08-14-2013 BY 60322
 UNCLASSIFIED//FOR OFFICIAL USE ONLY
 DATE 08-14-2013 BY 60322

PITTSFORD
BP019-3-5632

⊙
0575

CABLE GUARD RAIL REQUIRED

STATION	LENG.	CONSTANT	RAIL LENGTH
173+00-175+00	200'	40'	240'
173+00-175+50	200'	40'	240'

NEW REINFORCED CONCRETE PIPE CULVERTS REQUIRED



STATION	DIAM.	LENG.	CONC. C.	REIN. STEEL
174+03	30"	60'	3.2 cu yd	50 lbs.

DEWISWAY PIPE CULVERTS REQUIRED

STATION	DIAM.	LENG.	CONC. C.	REIN. STEEL
177+00	12"	36'	2.3 cu yd	

ED. STATE, 109 A, 1931, 192

Force	Kind of Instrument	Date of Instrument	Grantor	Grantee	Recorded	Remarks
B	O.C.D.	1-30-31	AALE Lambis	St of Vt.	41 11375	1-3-31
A	"	5-28-31	Jennie I. Bassett	"	41 180-1	6-20-31

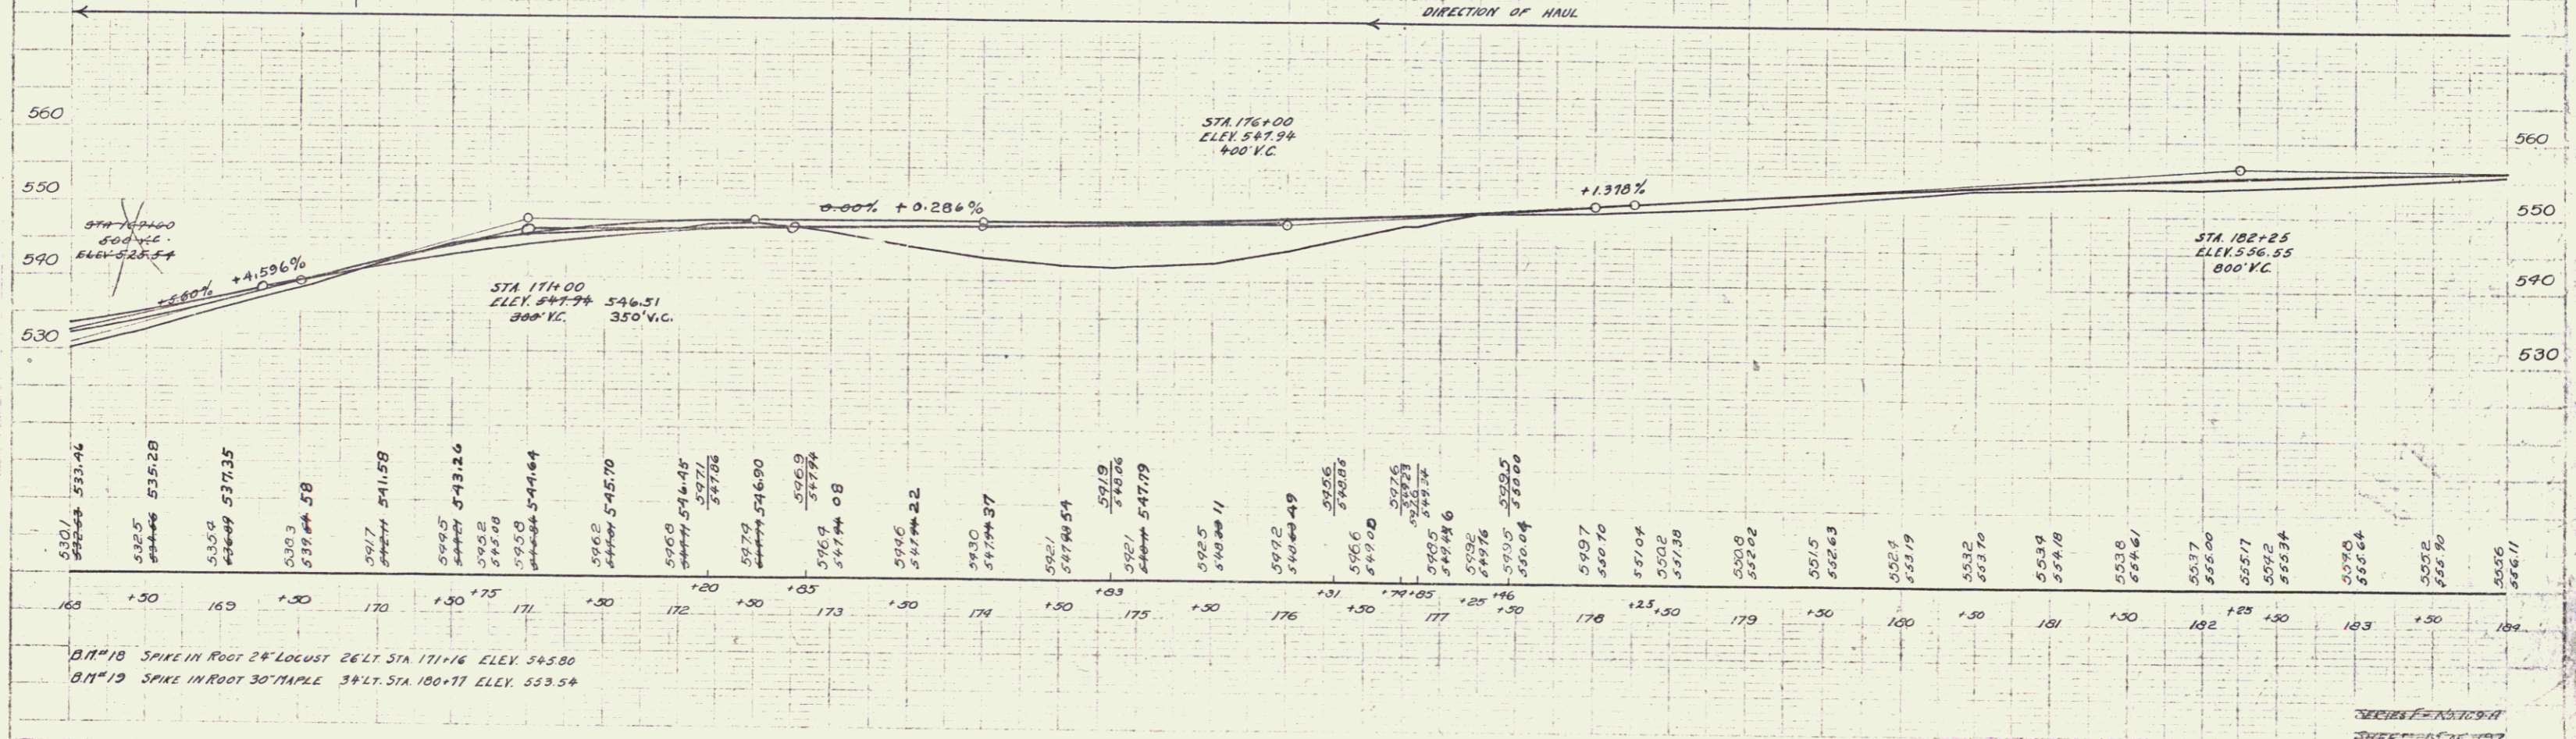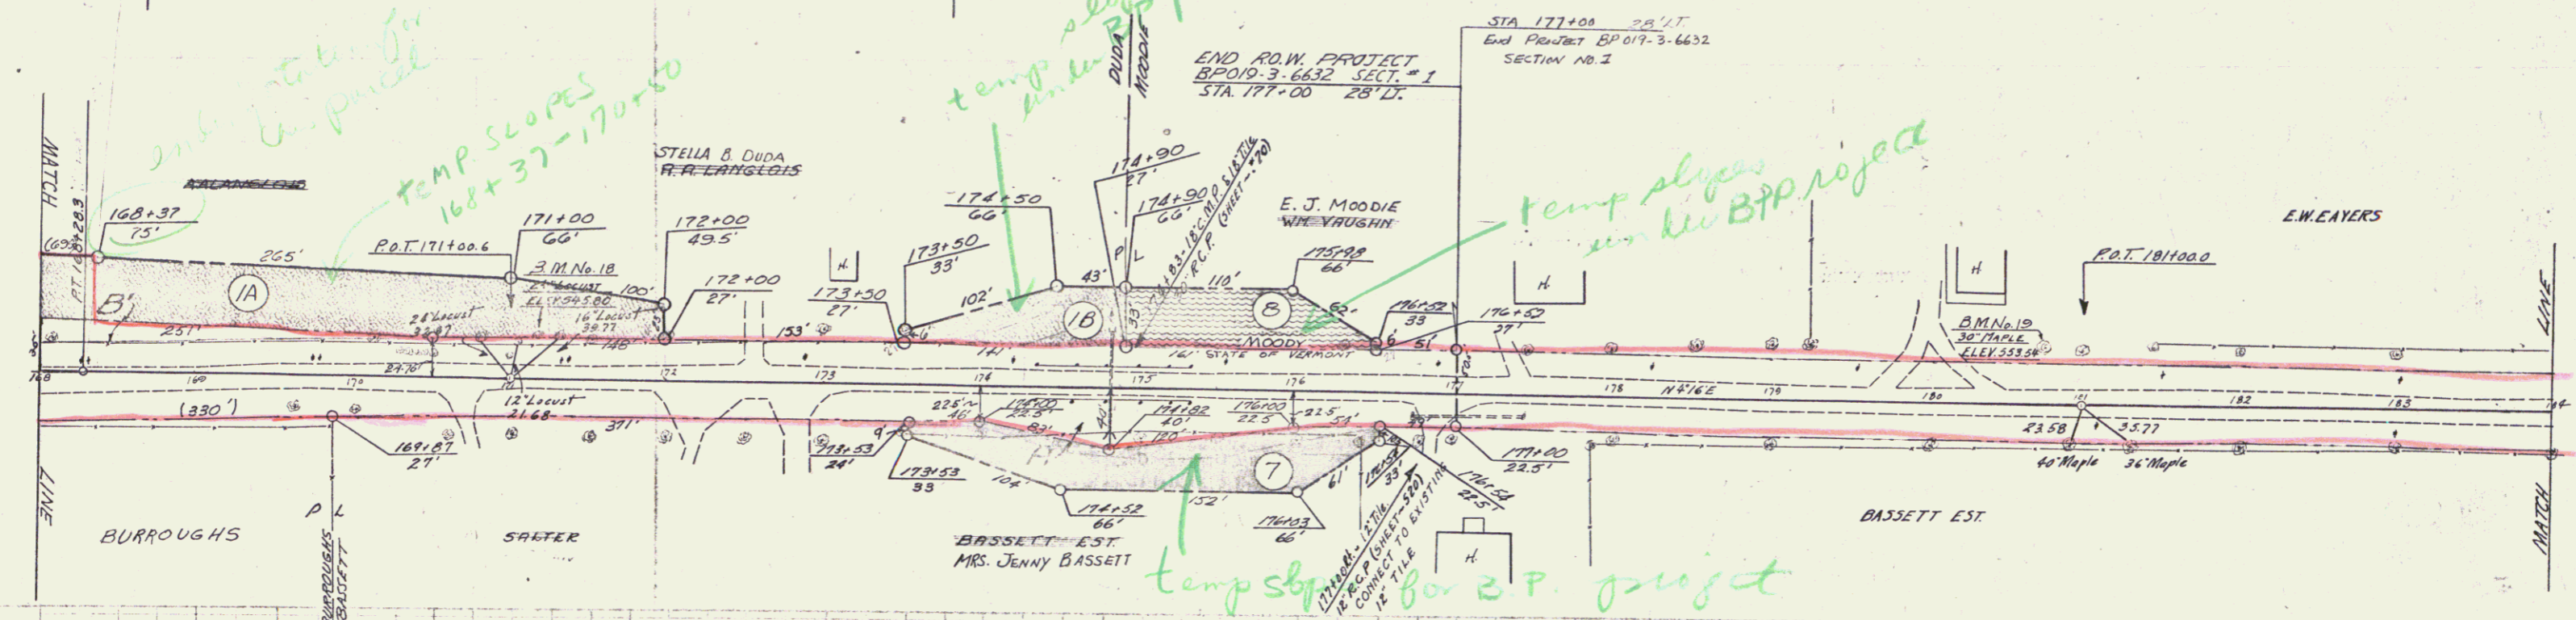

B.M. 18 SPIKE IN ROOT 24' LOCUST 26' LT. STA. 171+16 ELEV. 545.80
 B.M. 19 SPIKE IN ROOT 30' MAPLE 34' LT. STA. 180+71 ELEV. 553.54

SHEET 5 OF 76

CHOLE GUARD RAIL REQUIRED



STATIONS	LENG.	CONSTANT	NO. LENGTH
189+50-189+64 LT.	296'	40'	336'
189+50-192+50 RT.	304'	40'	344'
192+182-193+130 LT.	48'	40'	.88
192+30-194+00 RT.	160'	40'	200
193+66-194+66 LT.	80'	40'	120

NEW REIN. CONCRETE BOX CULVERT REQUIRED

STATION	SIZE	CONC.	REIN. STEEL
191+62	3x3	2444	1682 162

Parcel	Kind of Instrument	Date of Instrument	Owner	Grantee	Recorded Plat Book Page	Remarks
A	Q.C.D.	5-9-31	F.J. DeForge	Stef. H.	41 137-2	5-22-31
A'	"	5-28-31	W.F. Baird	"	41 138-1	5-28-31
B	"	5-28-31	Hubert Salter	"	41 135-6	5-28-31

appears no acquisitions were made from Hubert Marcell, Shelvey & Hutzler in 1969 for B.P. project
 E.C. WHEELER
 A. NEWMAN

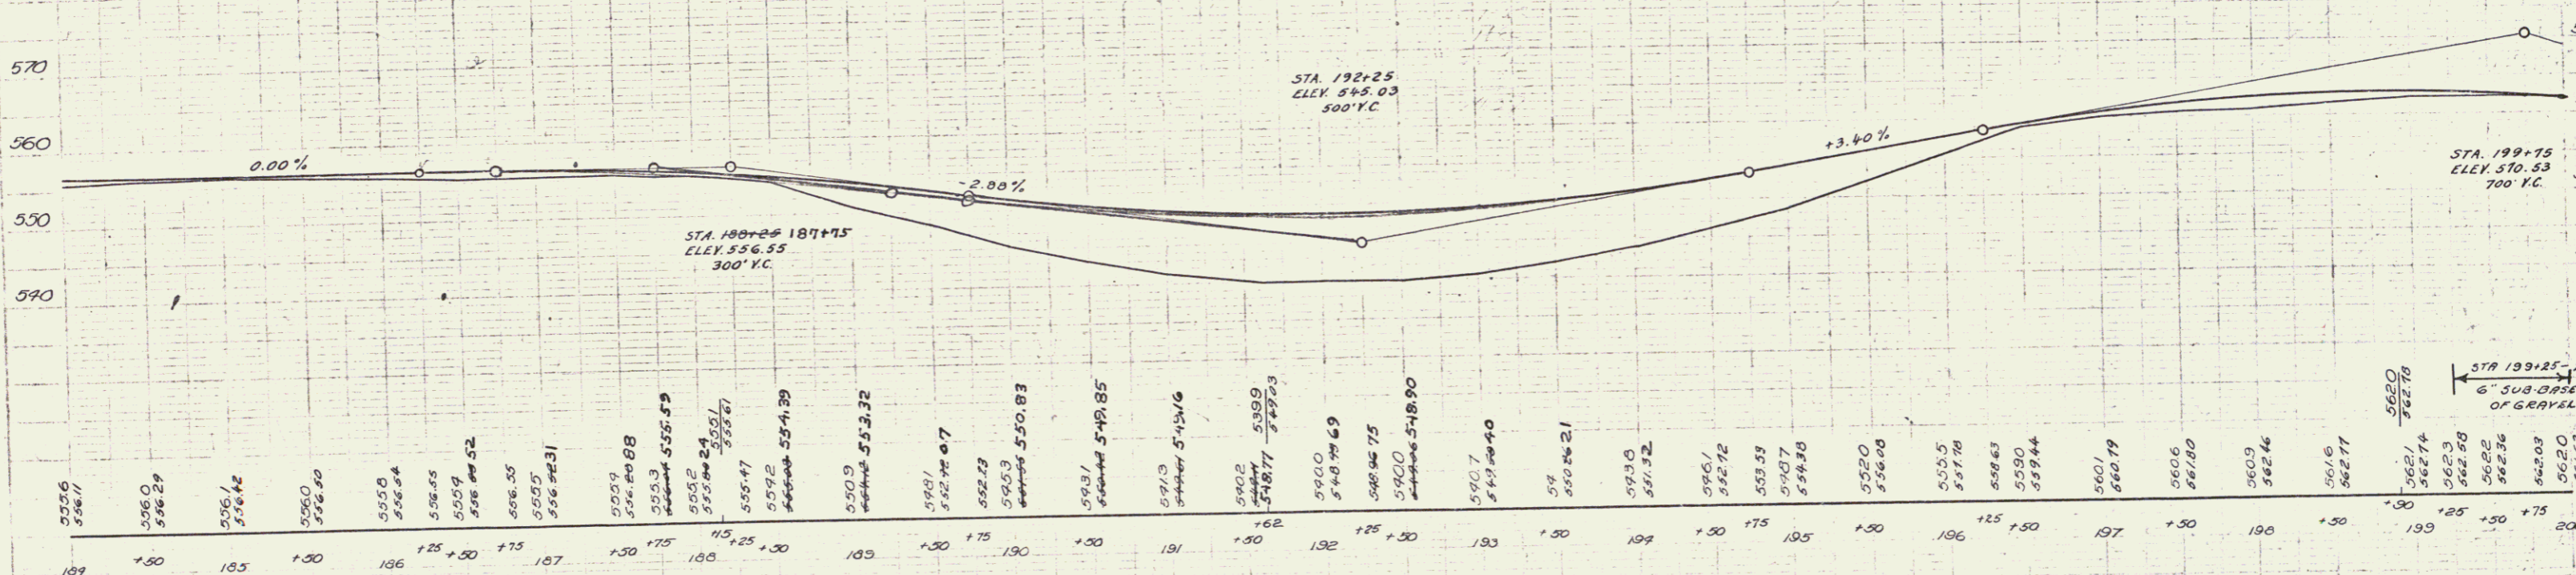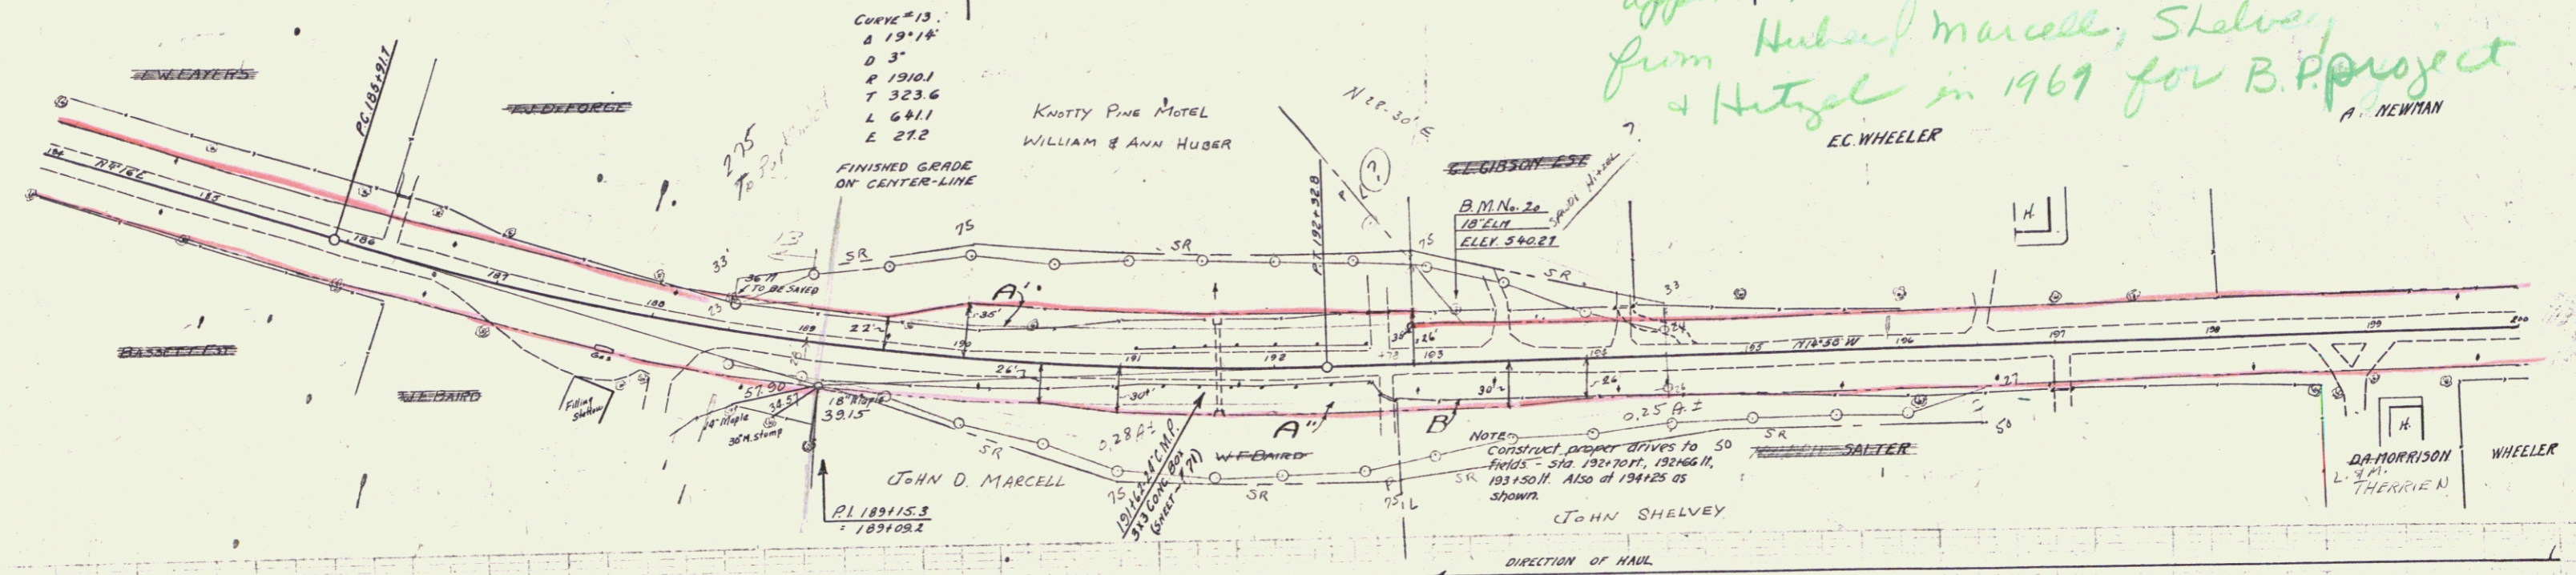

Station	Elevation
189	555.6
189+50	556.0
189+75	556.29
189+100	556.1
189+125	556.42
189+150	556.0
189+175	556.50
189+200	555.9
189+225	555.59
189+250	555.24
189+275	554.84
189+300	554.47
189+325	554.09
189+350	553.72
189+375	553.35
189+400	552.98
189+425	552.61
189+450	552.24
189+475	551.87
189+500	551.50
189+525	551.13
189+550	550.76
189+575	550.39
189+600	549.99
189+625	549.62
189+650	549.25
189+675	548.88
189+700	548.51
189+725	548.14
189+750	547.77
189+775	547.40
189+800	547.03
189+825	546.66
189+850	546.29
189+875	545.92
189+900	545.55
189+925	545.18
189+950	544.81
189+975	544.44
189+1000	544.07
190+000	543.70
190+050	543.33
190+100	542.96
190+150	542.59
190+200	542.22
190+250	541.85
190+300	541.48
190+350	541.11
190+400	540.74
190+450	540.37
190+500	539.99
190+550	539.62
190+600	539.25
190+650	538.88
190+700	538.51
190+750	538.14
190+800	537.77
190+850	537.40
190+900	537.03
190+950	536.66
191+000	536.29
191+050	535.92
191+100	535.55
191+150	535.18
191+200	534.81
191+250	534.44
191+300	534.07
191+350	533.70
191+400	533.33
191+450	532.96
191+500	532.59
191+550	532.22
191+600	531.85
191+650	531.48
191+700	531.11
191+750	530.74
191+800	530.37
191+850	529.99
191+900	529.62
191+950	529.25
192+000	528.88
192+050	528.51
192+100	528.14
192+150	527.77
192+200	527.40
192+250	527.03
192+300	526.66
192+350	526.29
192+400	525.92
192+450	525.55
192+500	525.18
192+550	524.81
192+600	524.44
192+650	524.07
192+700	523.70
192+750	523.33
192+800	522.96
192+850	522.59
192+900	522.22
192+950	521.85
193+000	521.48
193+050	521.11
193+100	520.74
193+150	520.37
193+200	519.99
193+250	519.62
193+300	519.25
193+350	518.88
193+400	518.51
193+450	518.14
193+500	517.77
193+550	517.40
193+600	517.03
193+650	516.66
193+700	516.29
193+750	515.92
193+800	515.55
193+850	515.18
193+900	514.81
193+950	514.44
194+000	514.07

0.17" x 20 SPIKE IN ROOT 18" x 1/2" 32" LT. STA. 193+18 ELEV. 540.27

SHEET 16 OF 157
 SUBJECT 5A OF 7
 B.P. 019-3-663


Parcel	Kind of Instrument	Date of Instrument	Grantor	Grantee	Recorded	Remarks
A.B.	G.C.D.	5-9-31	EMESA	Egyptus Shafiq	Book Page 4	Date 11-16-74 5-18-81

CABLE GUARD RAIL REQUIRED			
STATION	LENG.	CONSTANT	PIV. LENGTH
22700-22740 LT.	40'	40'	40'
22730-22770 RT.	40'	40'	38'

NEW REINF CONCRETE BOX CULVERT REQUIRED			
STATION	SIZE	CONC.	REINF. SECT.
230+34	4'x4'	200#	1998 lbs.

DRENAGE PIPE CULVERTS REQUIRED			
STATION	LENG.	DIAM.	CEMENT RUBBLE MASONRY
226+75	R 15'	18"	2.6 cubic yards
226+75	R 15'	18"	2.6 cubic yards
223+20	R 12'	24"	2.3 cubic yards

Sec F019-3(23)
1979

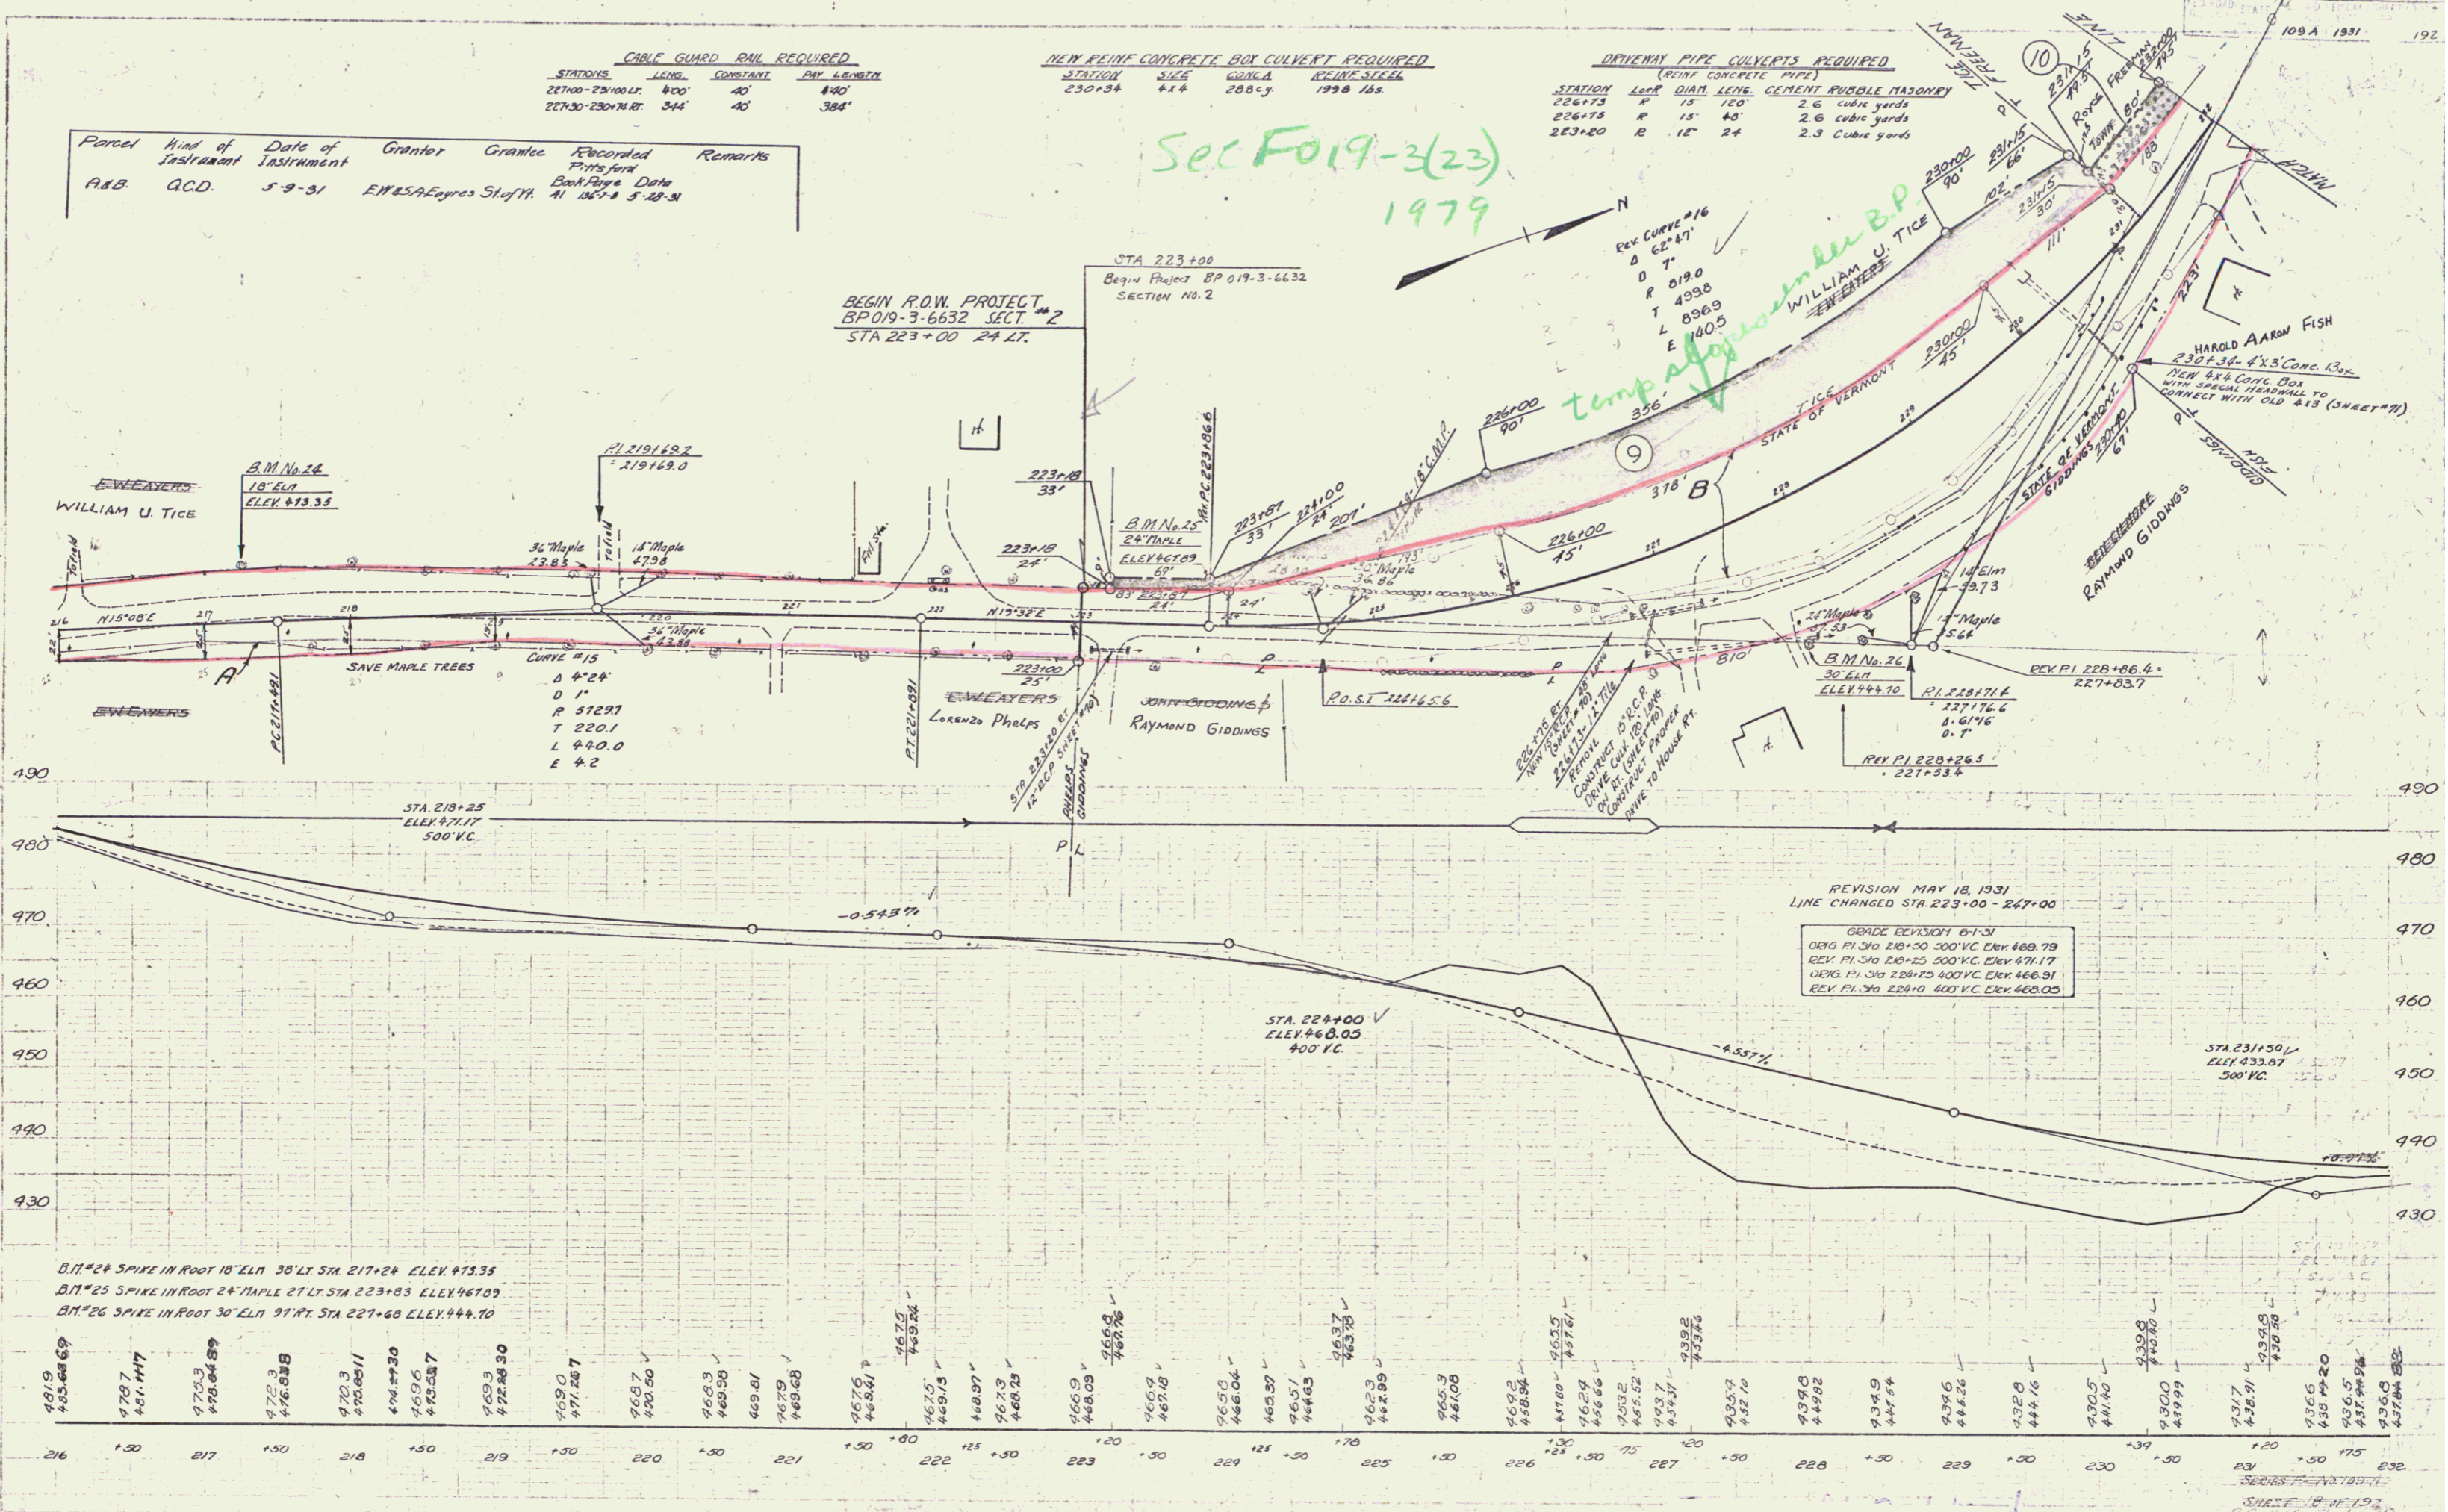

B.M. #24 SPIKE IN ROOT 18' ELN 30' LT. STA 217+24 ELEV 475.35
 B.M. #25 SPIKE IN ROOT 24' MAPLE 27' LT. STA 223+83 ELEV 467.09
 B.M. #26 SPIKE IN ROOT 30' ELN 97' RT. STA 227+68 ELEV 444.70

4919	465.68	69
4797	461.47	77
4753	470.84	89
4723	476.58	98
4703	470.85	111
4700	470.20	120
4696	470.53	127
4693	472.88	130
4690	471.28	137
4687	470.50	140
4683	469.58	147
4681	469.81	150
4679	469.68	153
4676	468.84	160
4675	469.24	163
4675	469.15	166
4687	468.97	173
4679	468.29	180
4669	468.09	187
4669	467.18	190
4659	466.04	197
4659	465.39	200
4657	464.63	203
4657	463.75	210
4653	464.88	213
4653	464.00	216
4652	463.84	219
4652	462.86	226
4652	462.59	229
4652	465.52	236
4637	464.37	243
4637	463.36	250
4637	462.10	257
4635	462.10	260
4635	461.82	263
4635	461.54	266
4635	440.26	494
4635	440.00	497
4635	439.72	500
4635	439.44	503
4635	377.84	1163



WOOD GUARD RAIL REQUIRED			
CULVERT STA	LEFT	RIGHT	
243+30	24	24	

NEW REIN CONCRETE PIPE CULVERT REQUIRED				
STATION	DIAM	LENG	CONCL	REIN STEEL
243+30	15"	56'	2.3 CY	33"

PLD ROAD DIST (MI)	STATE	PLD ROAD PROJ. NO.	PLD ROAD SECT. NO.	SHEET NO.	TOTAL SHEETS
9	VT.	109-A	1931	132	132

Parcel	Kind of Instrument	Date of Instrument	Grantor	Grantee	Recorded P.H.S. No.	Remarks
A	G.C.D.	2-26-32	ALBANE GREENE	St. of Vt.	A1 045	2-26-32
A'	"	5-16-32	Chas. H. Christian et al.	"	A1 267	5-19-32

STA 247+00
 End Project BP 019-3-6632
 SECTION No 2
 END ROW PROJECT
 BP 019-3-6632 SECT. #2
 STA 247+00 25 LT.

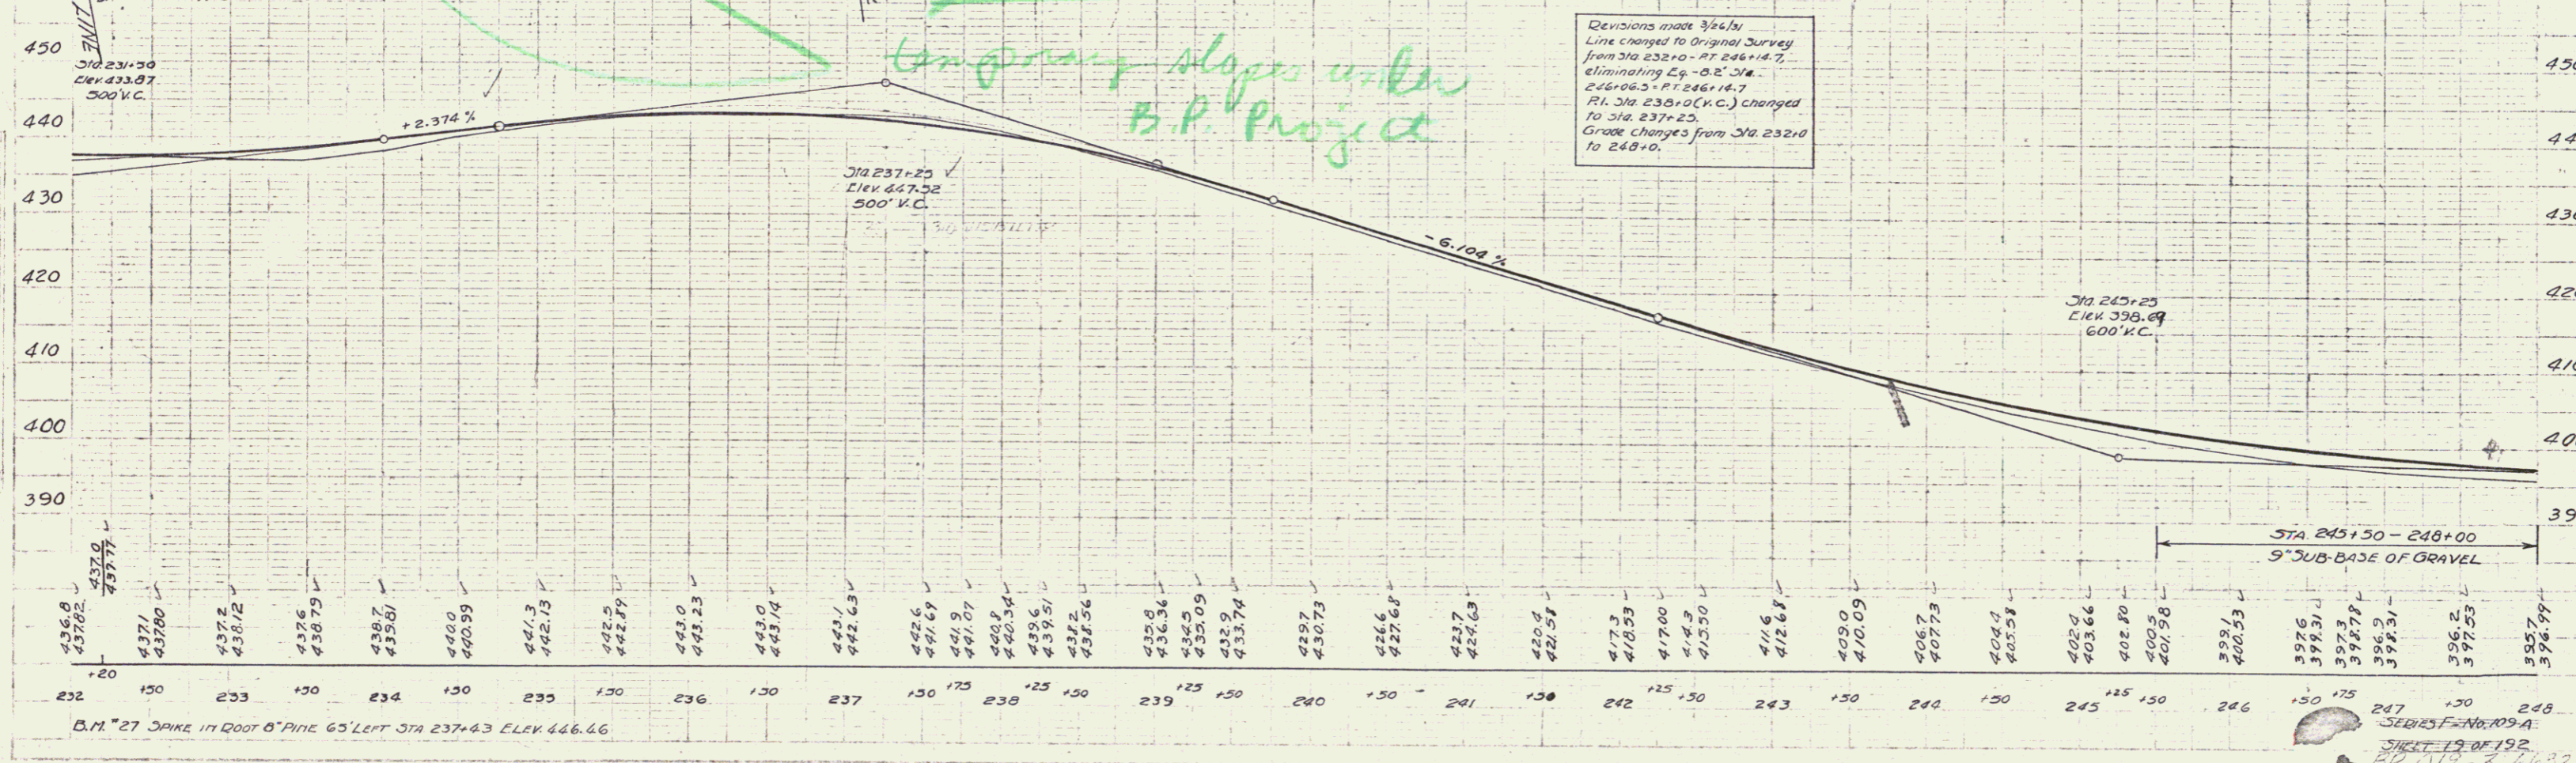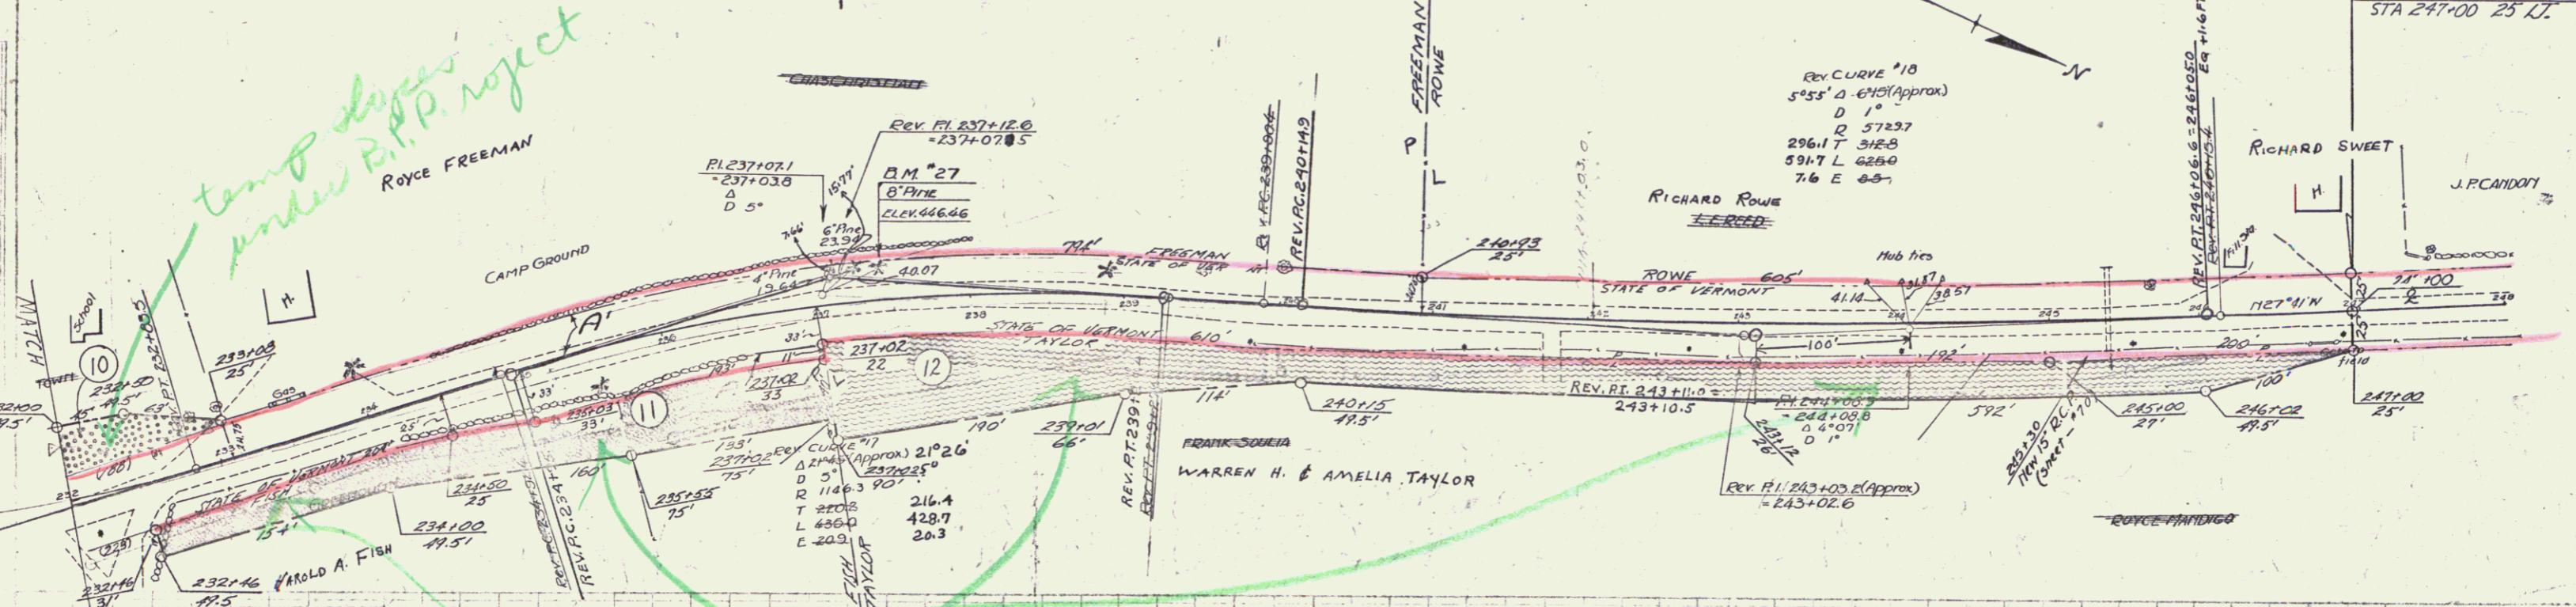

B.M. #27 SPIKE IN ROOT 6" PINE 65' LEFT STA 237+43 ELEV 446.66

Revisions made 3/5/51
 Line changed to Original Survey
 from Sta 232+10 - PT 248+14.7
 eliminating 12' - 0.2' dia.
 246+06.5 - PT 246+14.7
 PI Sta 233+0 (K.C.) changed
 to Sta 237+25
 Grade changes from Sta 232+0
 to 248+0.

temp slopes under B.P. project
 ROYCE FREEMAN

temporary slopes under B.P. Project