


PLAN
 DATE: _____
 NO. _____
 CHECKED BY: _____
 DATE: _____

FROM F-109A

PC	561+22.5
PI	561+50.8
PT	562+19.2
D	2° 23' LT
R	1149.2
T	22.92
L	420.7
E	3.3

PROFILE
 DATE: _____
 NO. _____
 CHECKED BY: _____
 DATE: _____

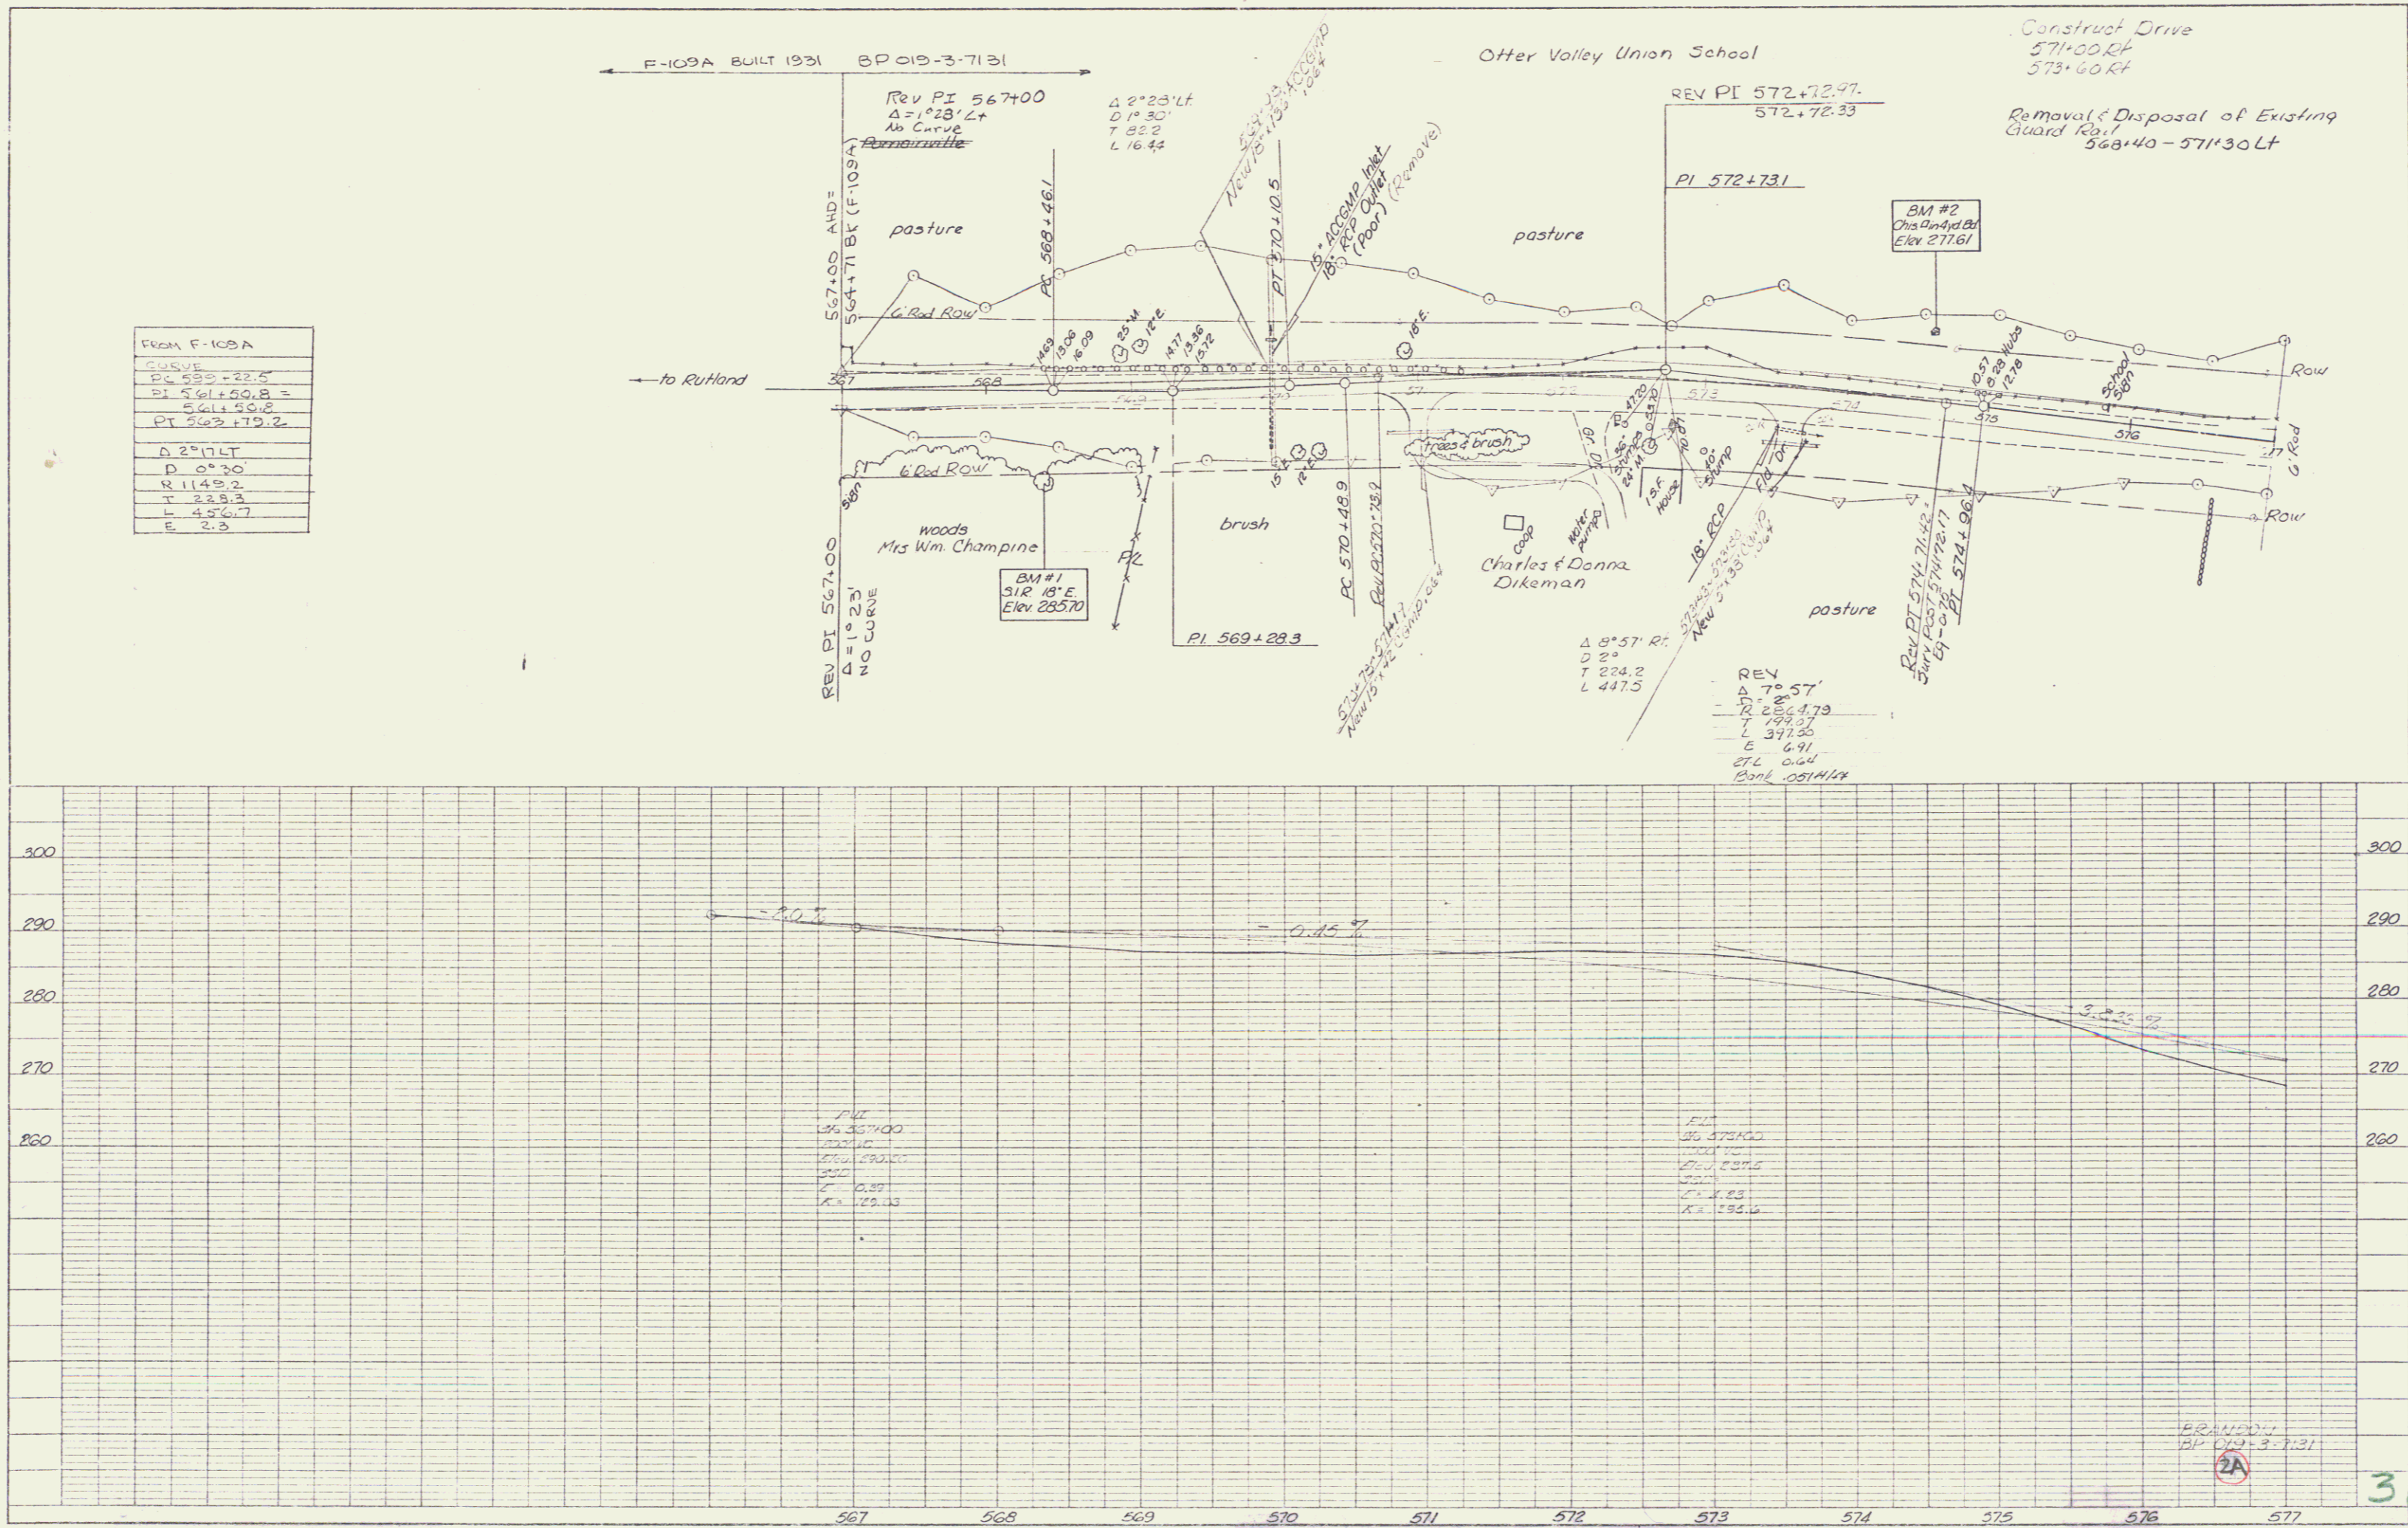

BRAND 1
 BP 019-3-7131