
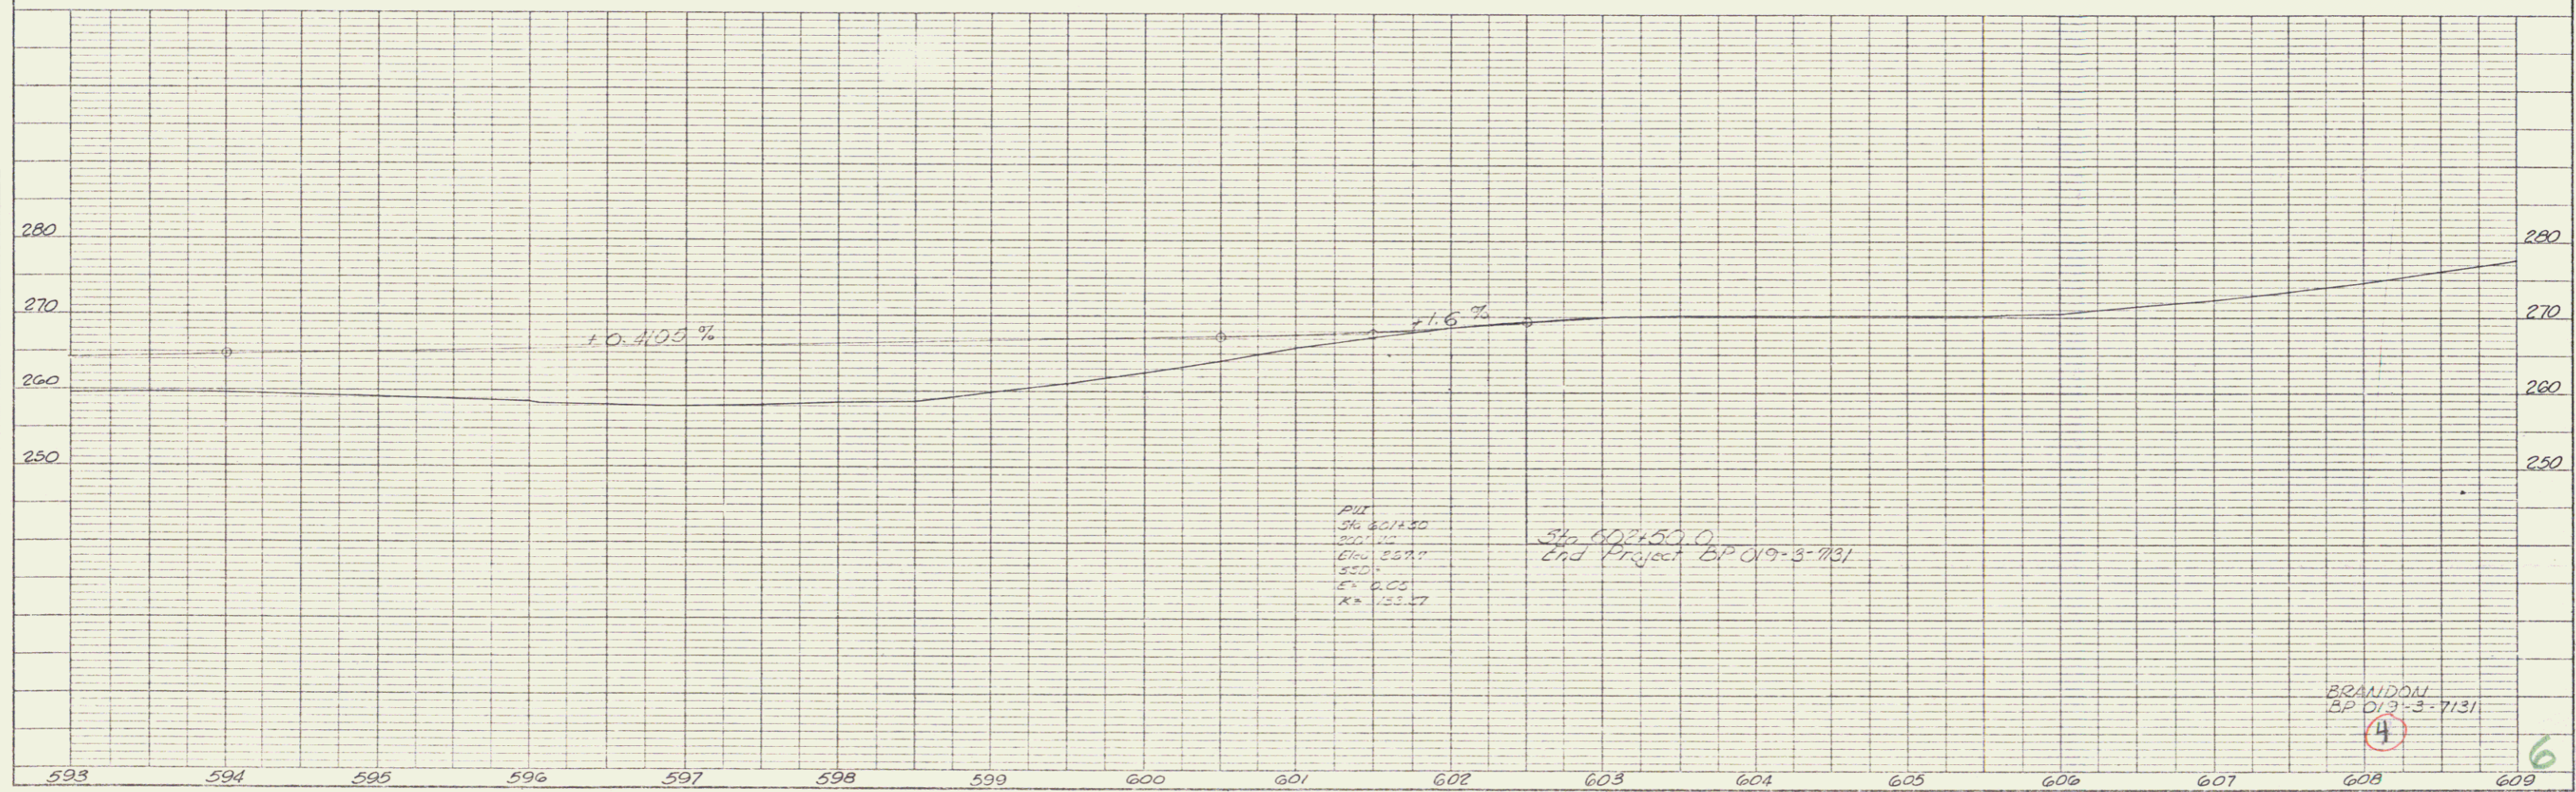


PLAN	DATE
REVISION	
BY	
CHECKED	
DATE	
SCALE	
PROJECT	
DATE	
BY	
CHECKED	
DATE	

PROFILE	DATE
REVISION	
BY	
CHECKED	
DATE	
SCALE	
PROJECT	
DATE	
BY	
CHECKED	
DATE	

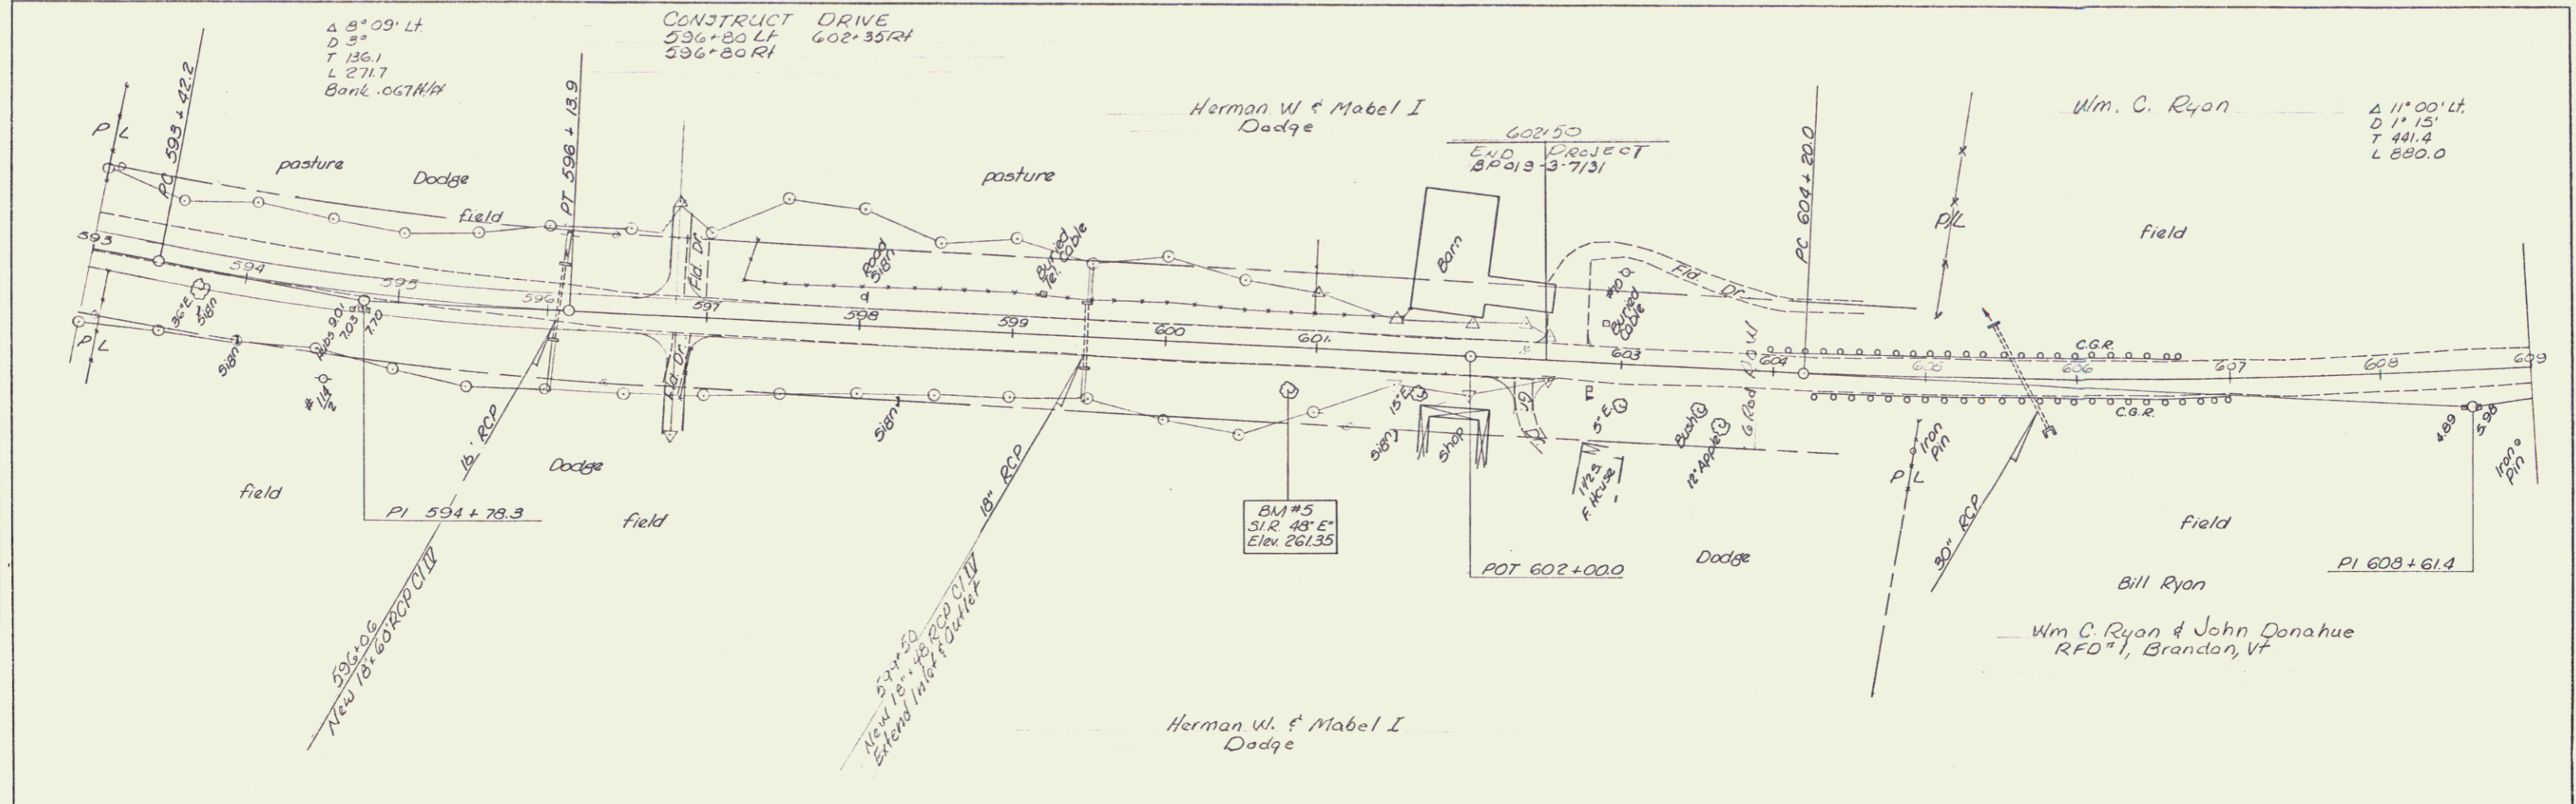

K&E PLATE 1, PLAN-PROFILE
 REUPPS & ELLER CO.
 48 7012 IMPERIAL TRADE PRINTING

BRANDON
 BP 019-3-7131
 4

6