


NOTE: Subject to the approval of the selectmen of the town of Dunbar for discontinuance of the present highway, Sta. 872+75 to Sta. 876+00 of Main Line, the contractor will be required to remove the bituminous road surface from this section of old road and use the material in embankments of project. This removal and disposal to be paid for under Item 10, Common Excavation.


CURVE
 A 15'-23' LT.
 D 37'
 R 1910.1
 T 253.7'
 L 516.1
 E 17.6

Sedding of Slopes
 Sta 881+12 To 882+80 LT

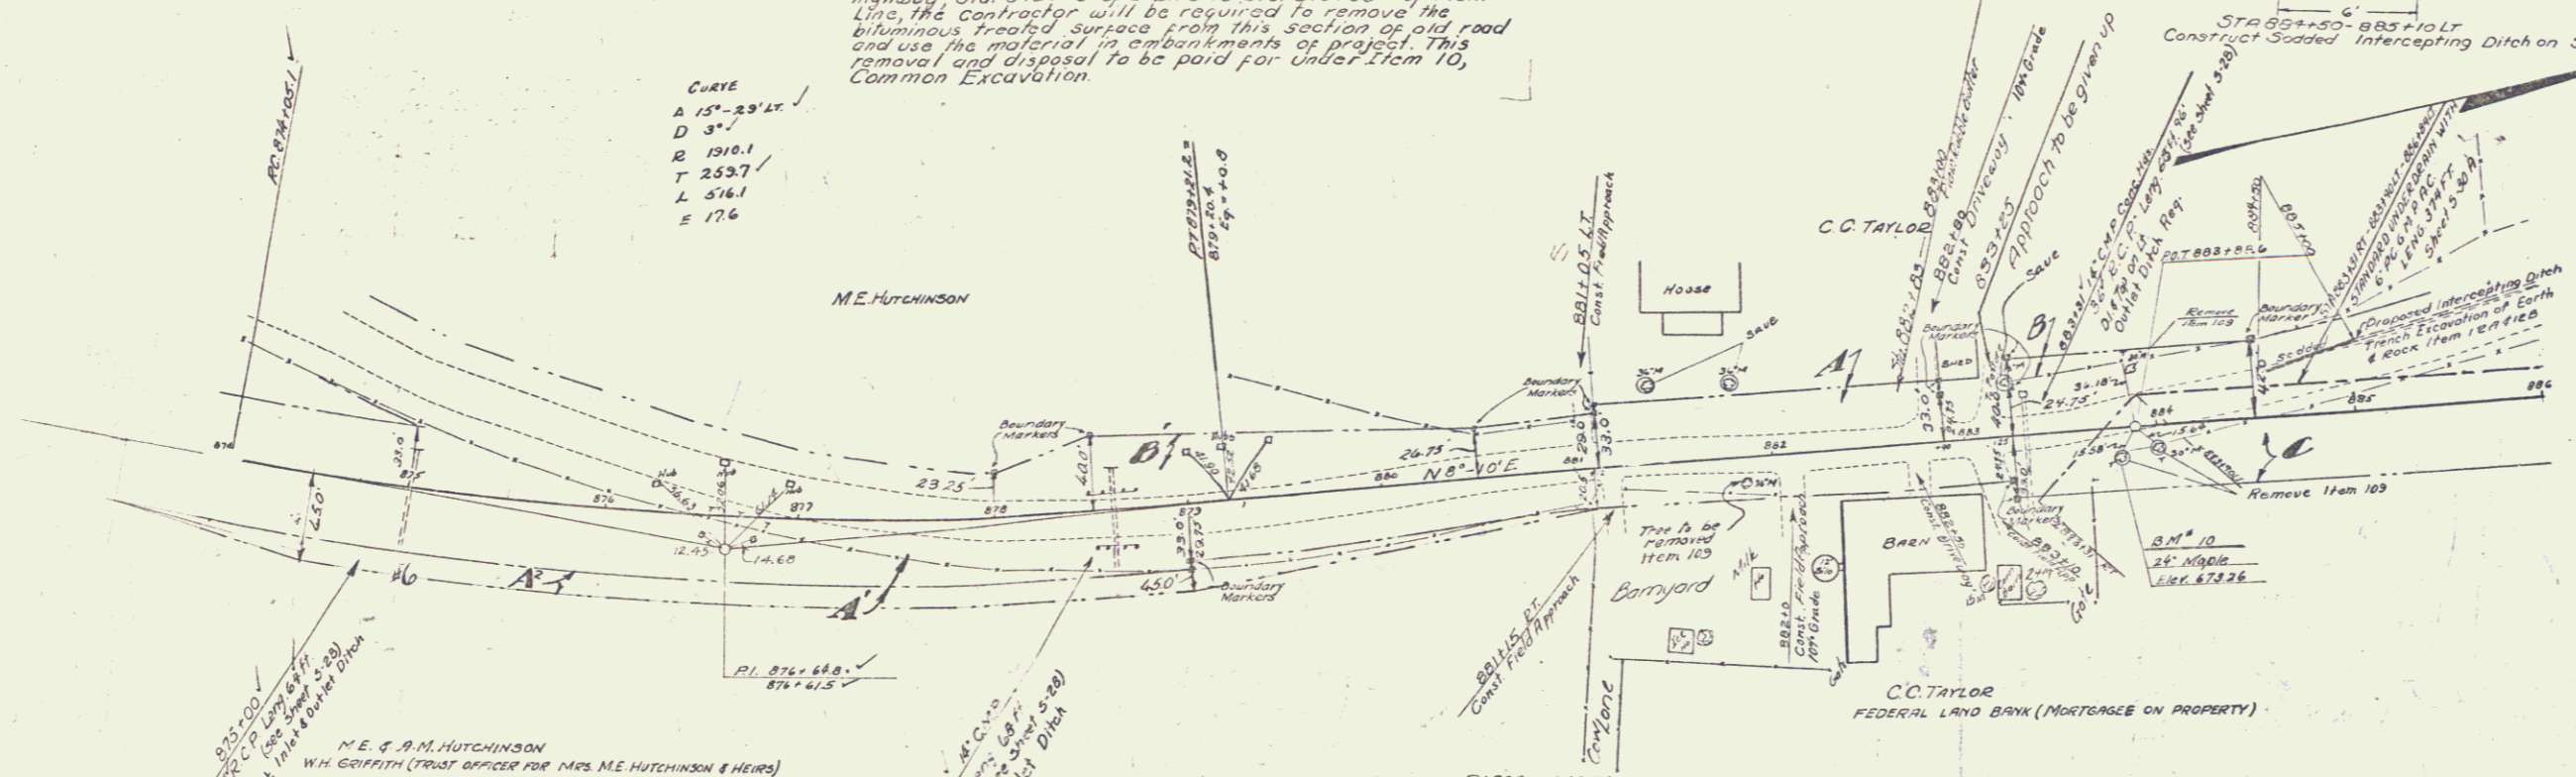

PARCEL INSTRUMENT	DATE	GRANTOR	GRANTEE	RECORDED	REMARKS
ADC W.D.	5-22-37	C.C. DARLEY (MORON TAYLOR)	STORIT	21	482-484 5-26-37 STA 880+00 to 881+50
MA RELEASE	5-6-37	FED. LAND BANK	"	21	478 5-15-37
ADC AMM. DEED	8-13-37	ANDRE MORTGAGEE	"	21	474 5-15-37
A ² W.D.O.E.	7-15-40	MILTON E. HUTCHINSON (TRUSTEE)	"	22	257-B 4-10-42

Proposed Inlet & Outlet Ditches At
 Sta. 875+00, 878+60 & 883+31
 Excavation For These Ditches To Be
 Paid For Under Bid Item For Trench
 Excav. of Earth or Rock, Item 18A(1)(B)

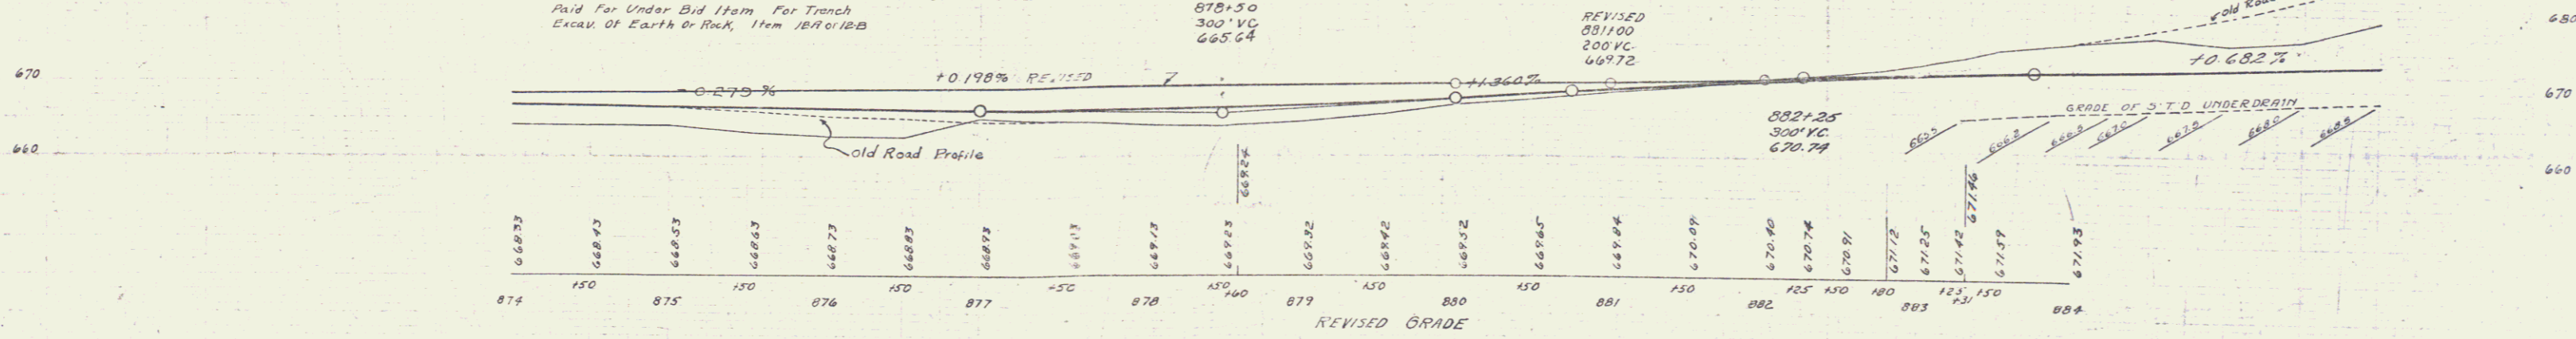

874+0 - 877+50 15' Sub base of Gravel
 877+50 - 881+25 15' Sub base of Gravel
 881+25 - 886+00 10' Sub base of Gravel

