



CREOSOTED TINDER CURB ITEMS  
 830+52 TO 833+33 LT 280 LF  
 842+24 TO 837+88 ET 416 LF  
 832+93 24

ROAD STATE FEDERAL FISCAL SHEET TO  
 DIST. NO. POST. YEAR NO. SHEET  
 12(4) 1989 12 8

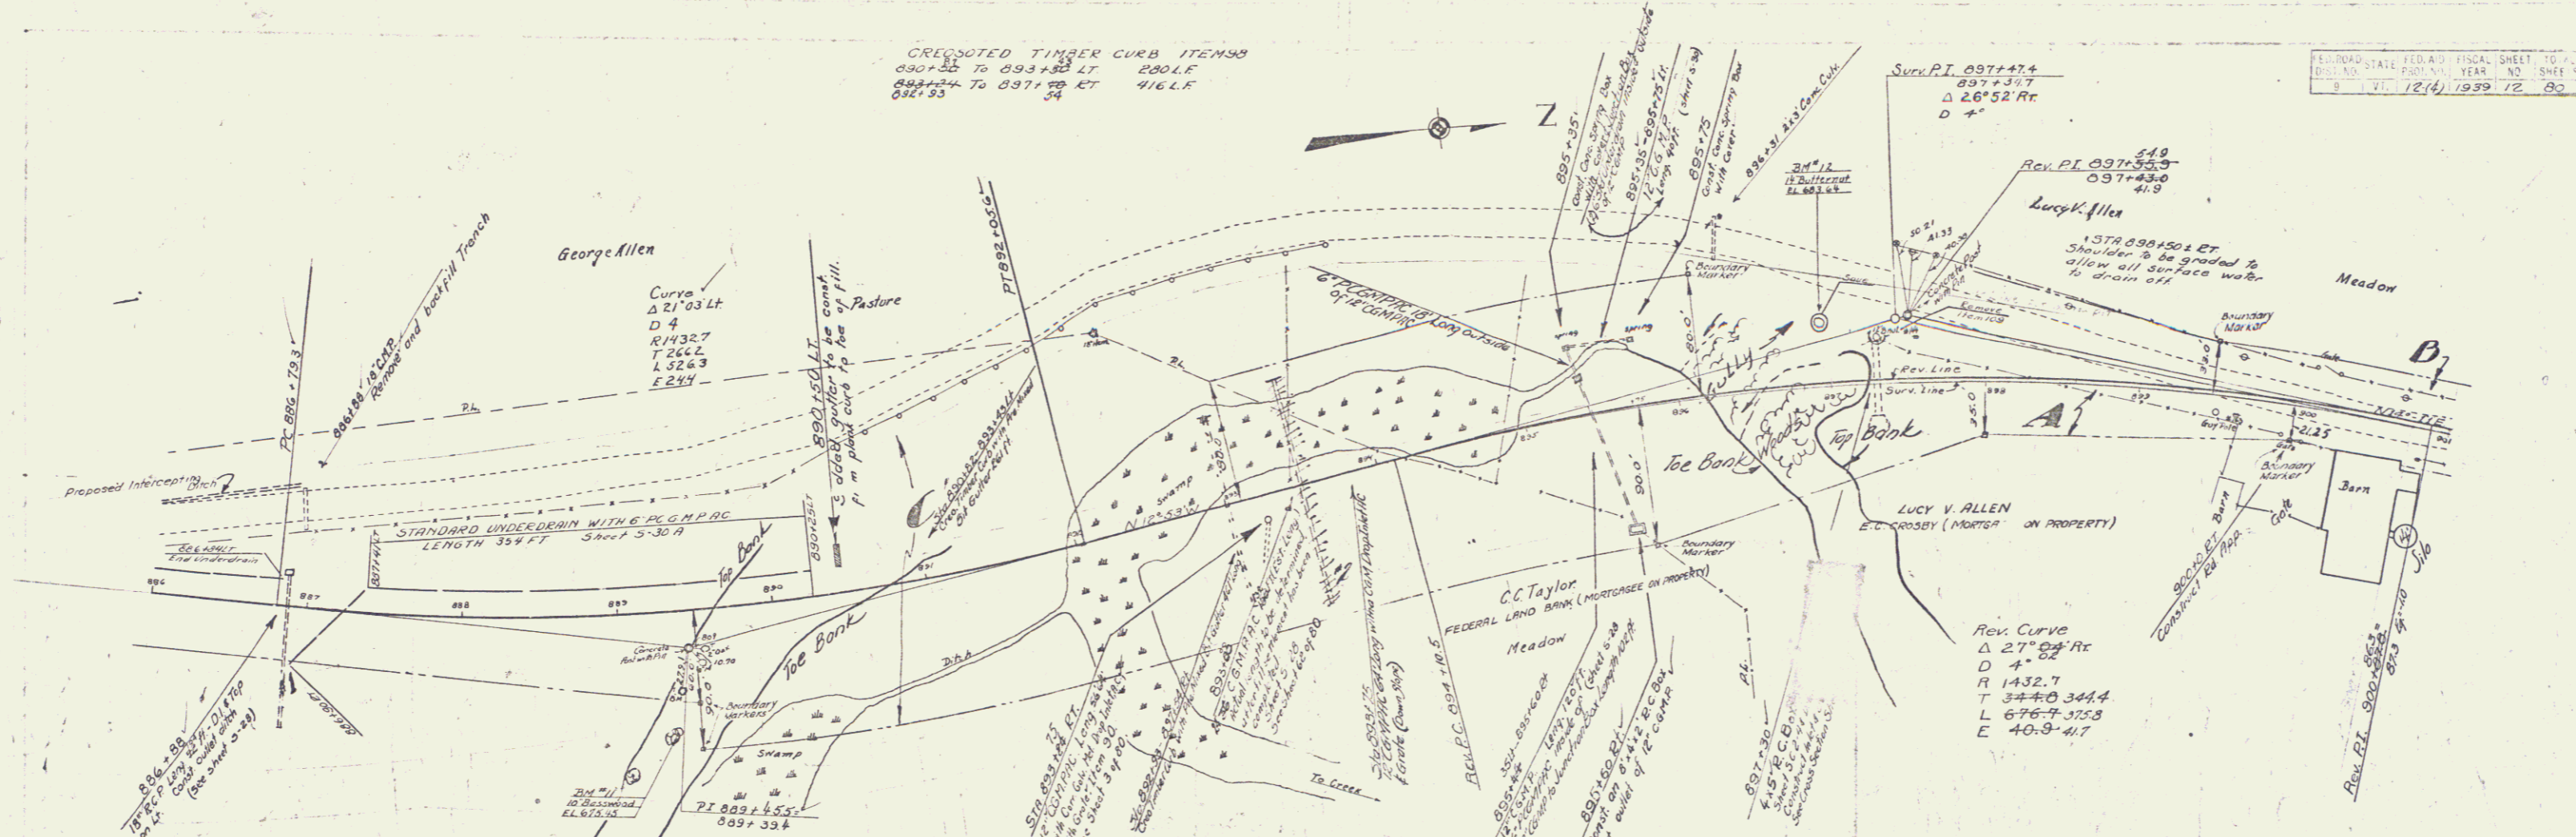

PARCEL INSTRUMENT	DATE	GRANTOR	GRANTEE	RECORDED	REMARKS
ABC	Q.C.D.	2-27-37	Geo. L. Allen	21	417 3-5-37
A.C.	W.D.	5-22-37	C.C. Oakes	21	417 3-5-37
	M.R. RELEASE	5-6-37	FED. LAND BANK	21	417 3-5-37
		5-6-37	FED. FARM MORTGAGE	21	417 3-5-37

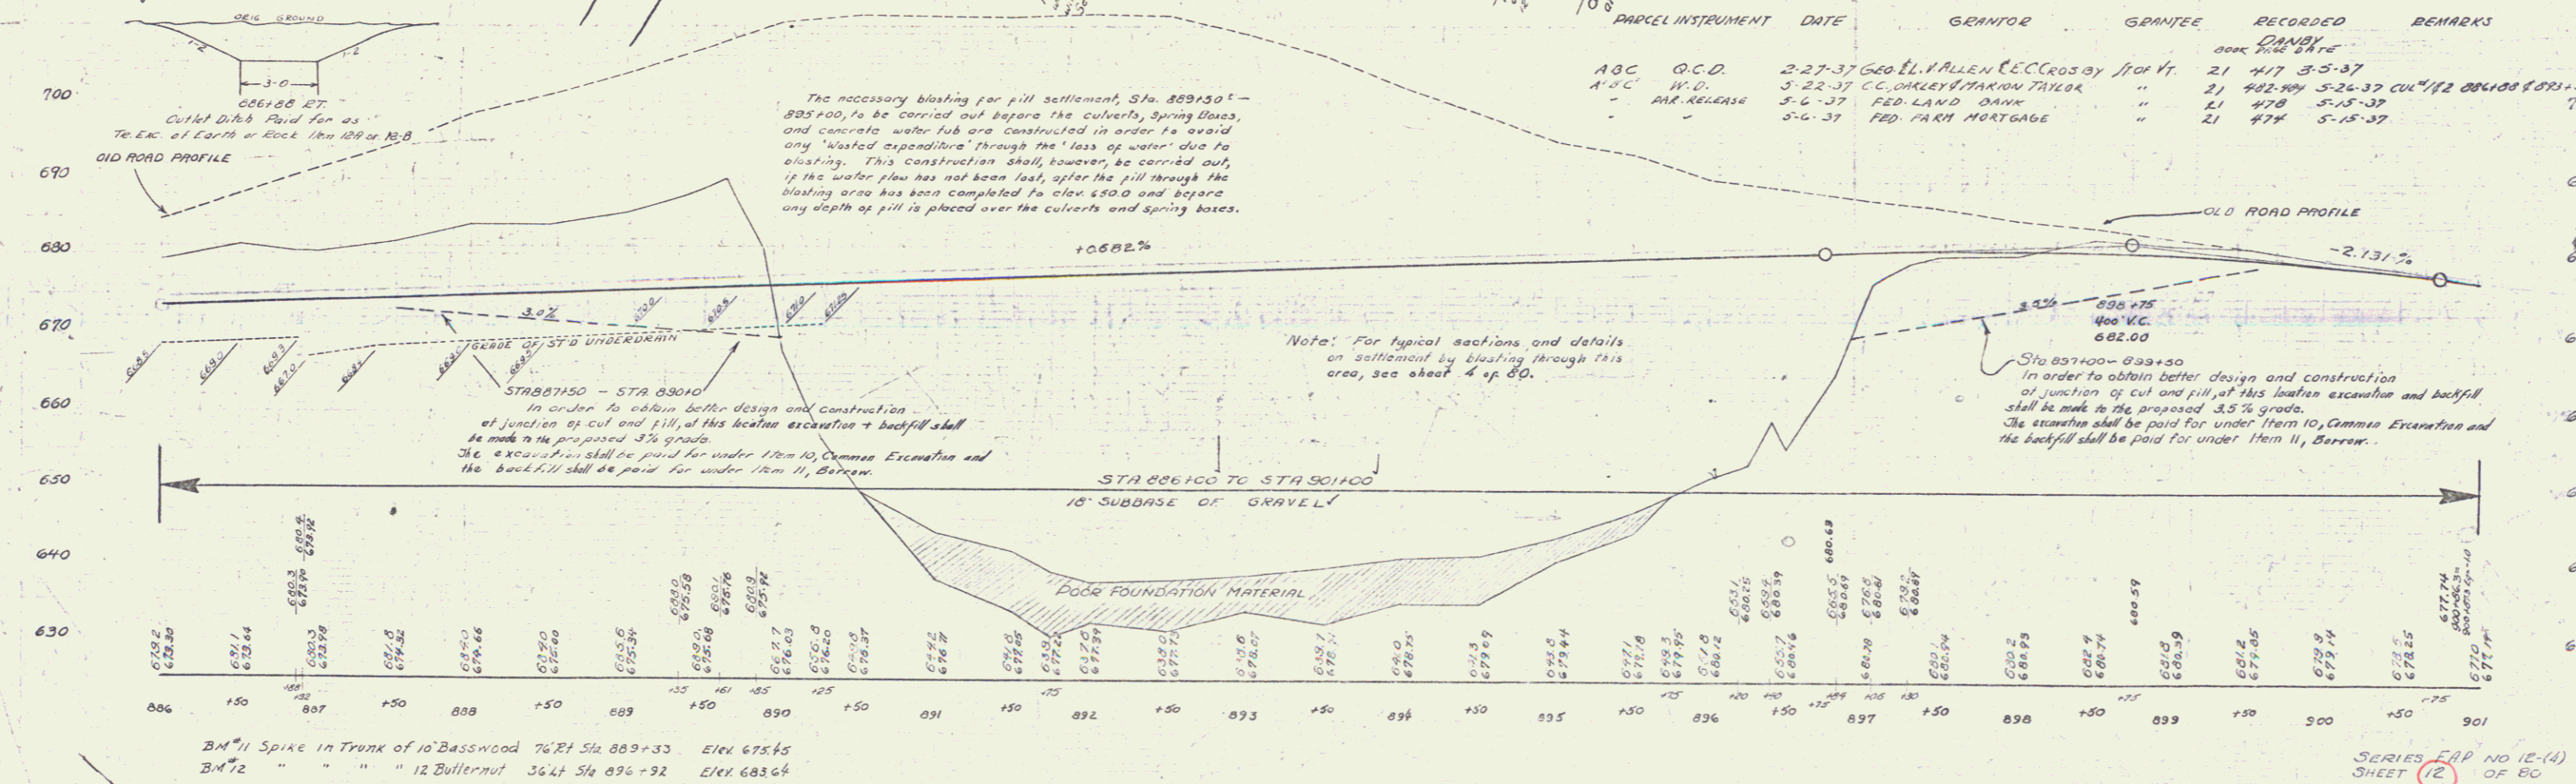

BM #1 Spike in Trunk of 10" Basswood 76' Et Sta 889+33 Elev 675.45  
 BM #2 " " " 12" Butternut 36.4' Et Sta 896+92 Elev 683.64

SERIES F&P NO 12(4)  
 SHEET 12 OF 80