
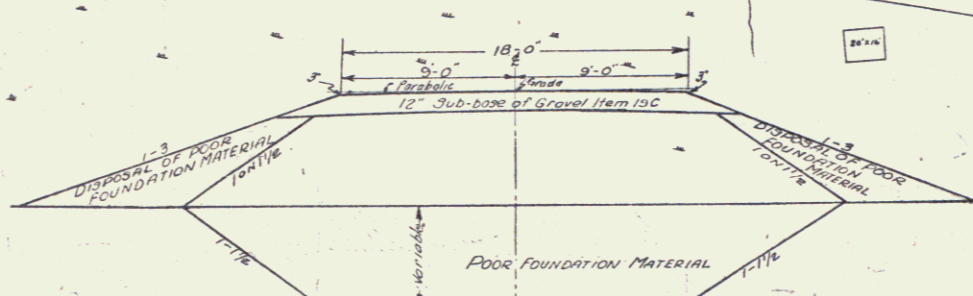




1124
 AUTUMN

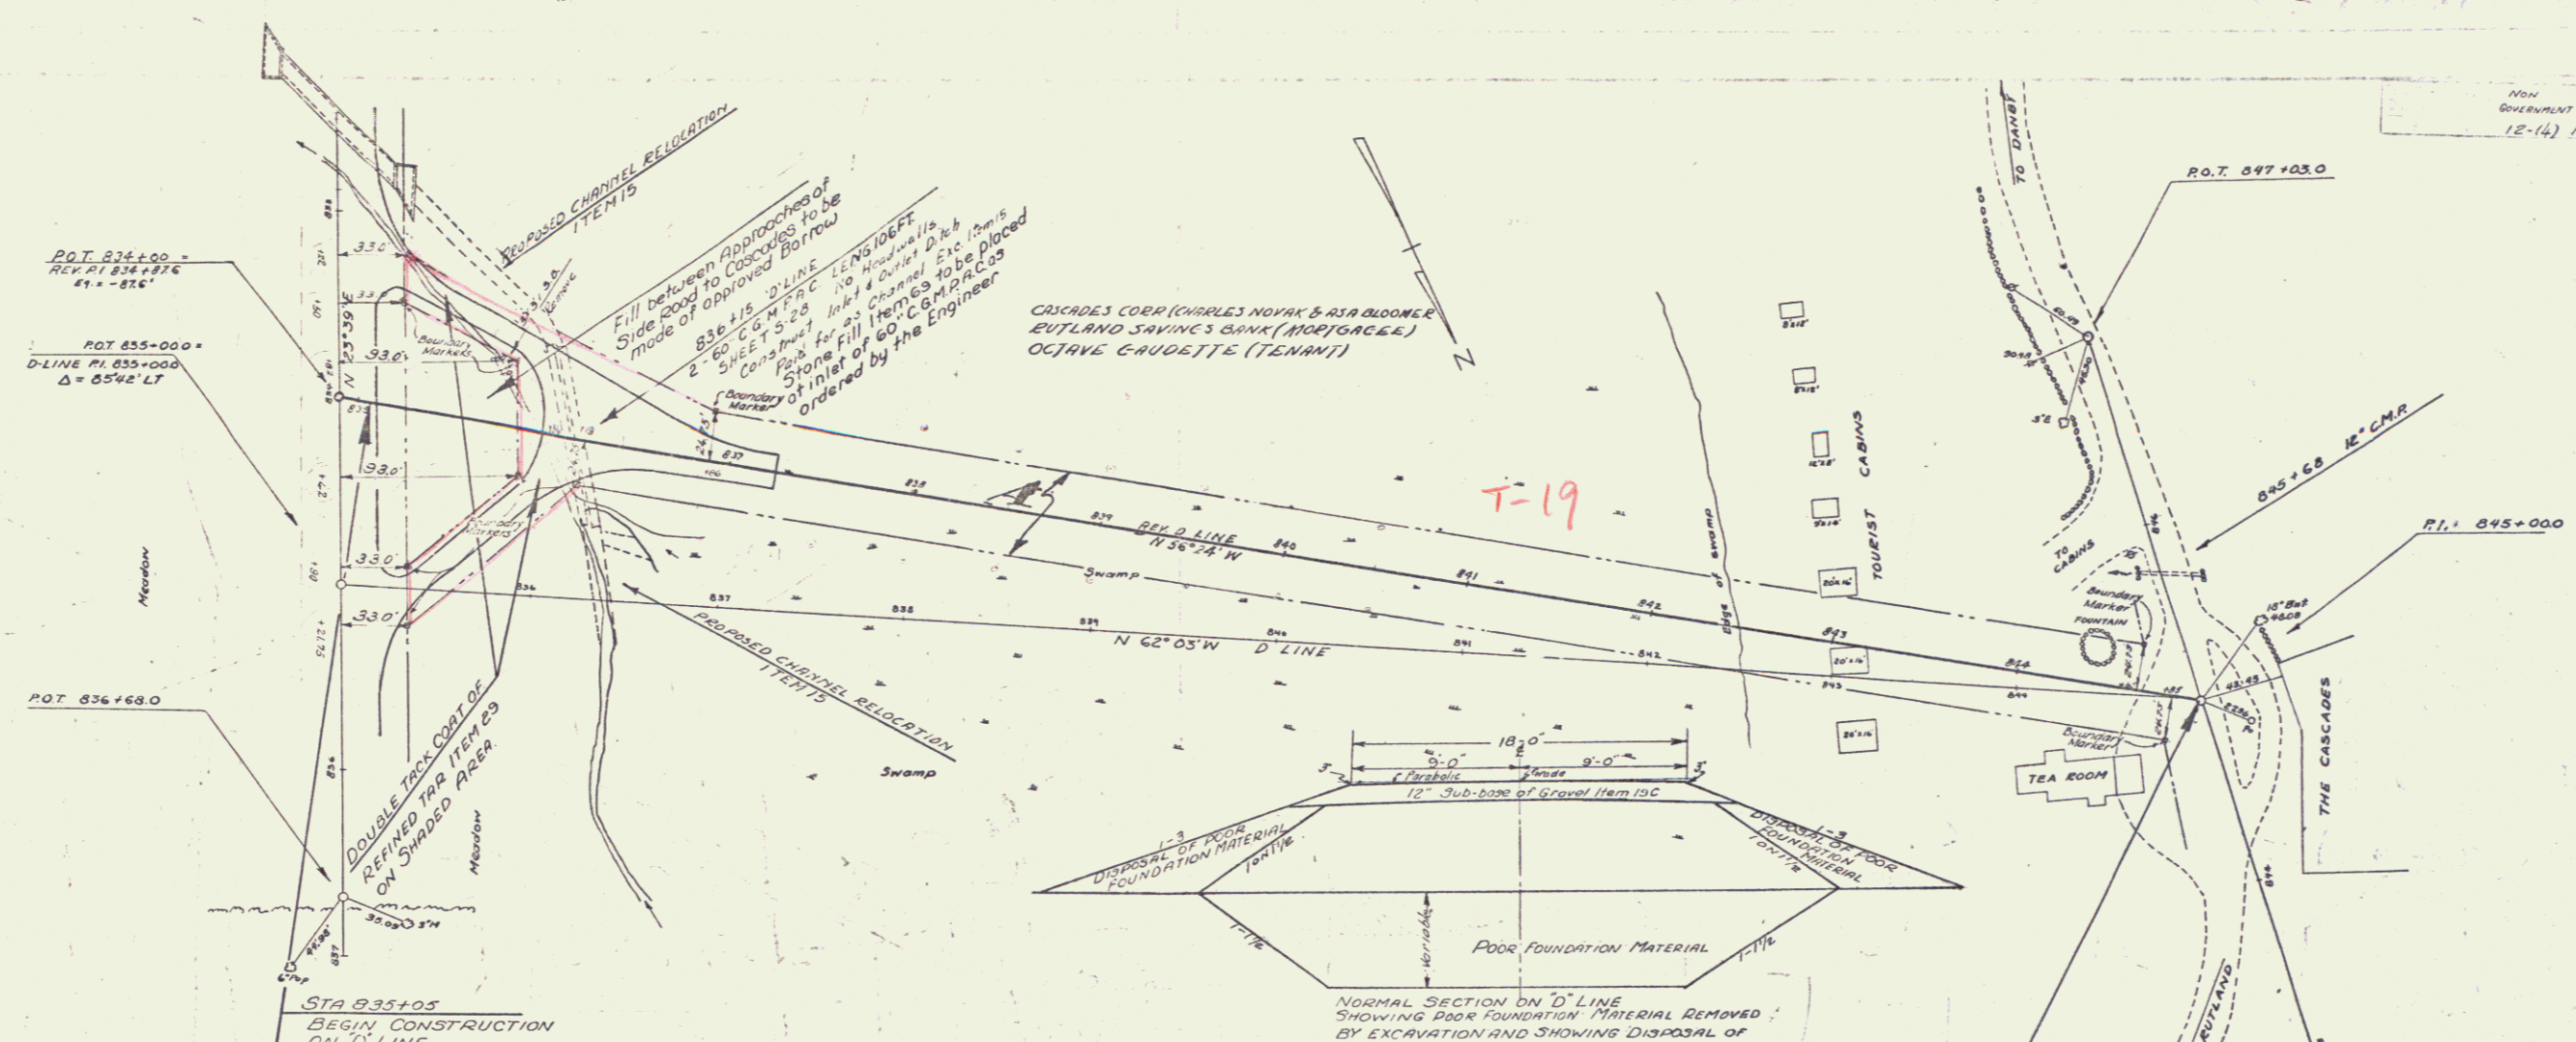

NORMAL SECTION ON 'D' LINE
 SHOWING POOR FOUNDATION MATERIAL REMOVED
 BY EXCAVATION AND SHOWING DISPOSAL OF
 POOR FOUNDATION MATERIAL BETWEEN
 1-1/2% AND 1-3% SLOPES

Such Muck as is excavated on the 'D' Line
 shall be deposited at locations on the 'D' Line
 shown on the plans after the fills have been
 made to a 1-1/2% slope. If there is an excess amount
 of Muck material after such fills as shown
 on the plans have been made, then this excess
 material shall be spread over other fill slopes
 on the contract to a depth of 6".

| PARCEL | INSTRUMENT | DATE | GRANTOR | GRANTEE | RECORDED | REMARKS |
|--------|------------|---------|-------------------|---------------|----------|---------|
| A | W.D. | 3-12-37 | THE CASCADES CORP | STA-VI 21 #43 | 3-23-37 | |

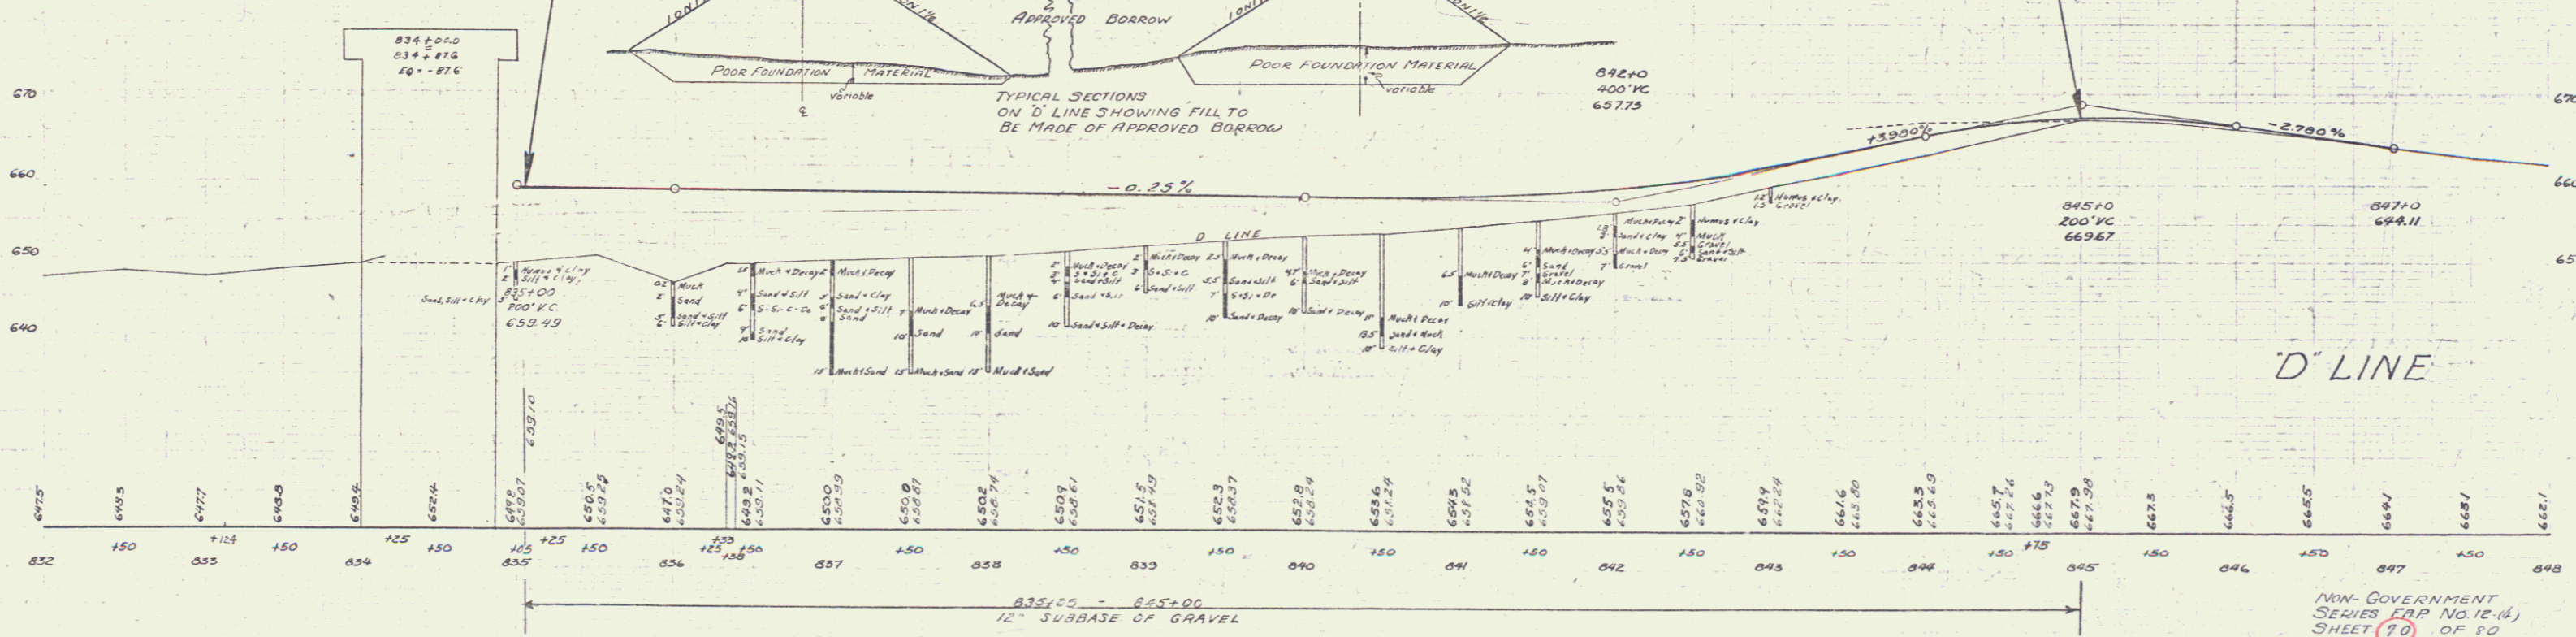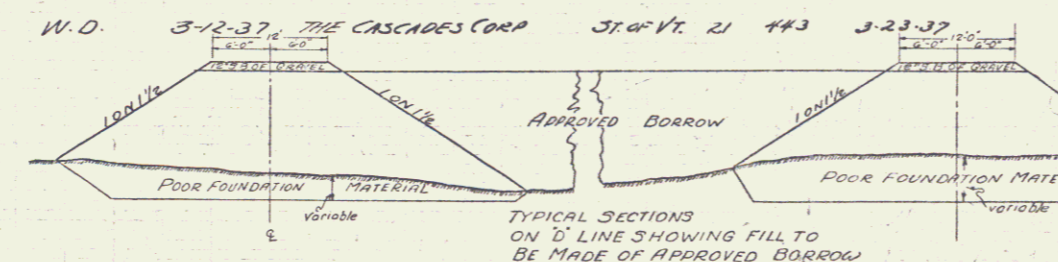

D' LINE