


BARNETT POTTS

710
700
690
680
670

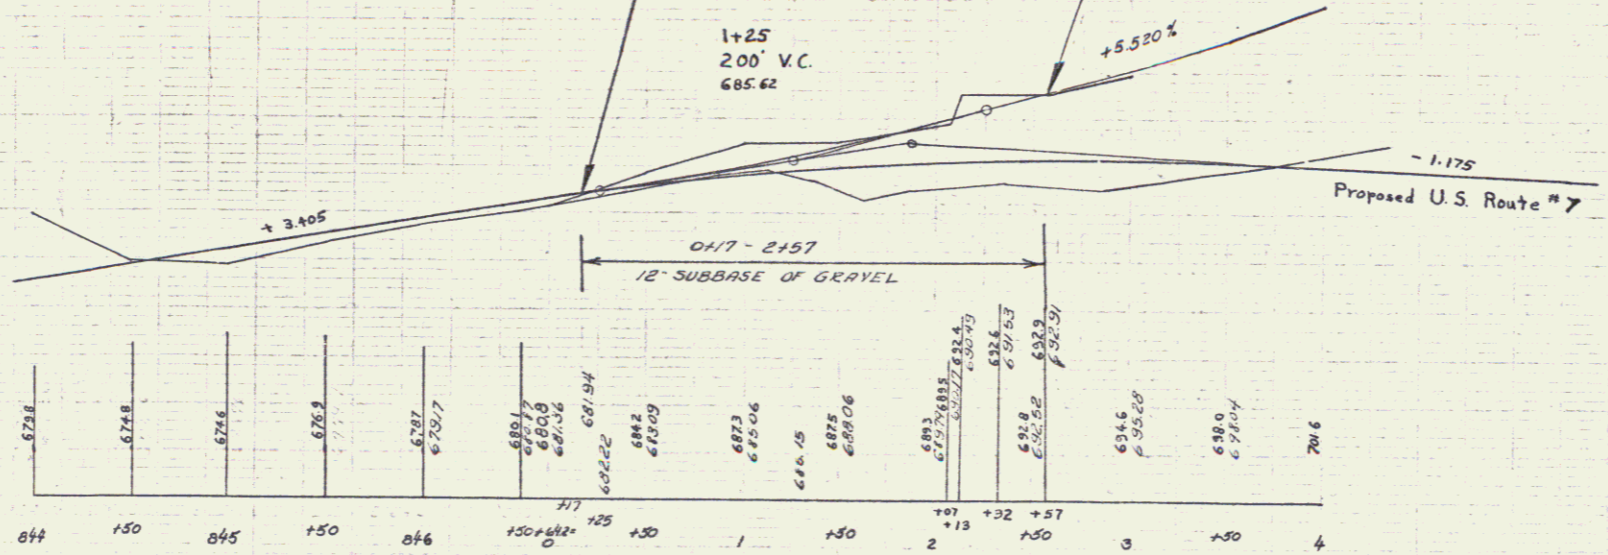

J' LINE

J' LINE
NON-GOVERNMENT PARTICIPATION
SERIES E.B.R. No 12-(4)
SHEET 71 OF 90