


Barrett  
 1/16/37  
 1/19/37

Barrett  
 1/16/37  
 1/19/37

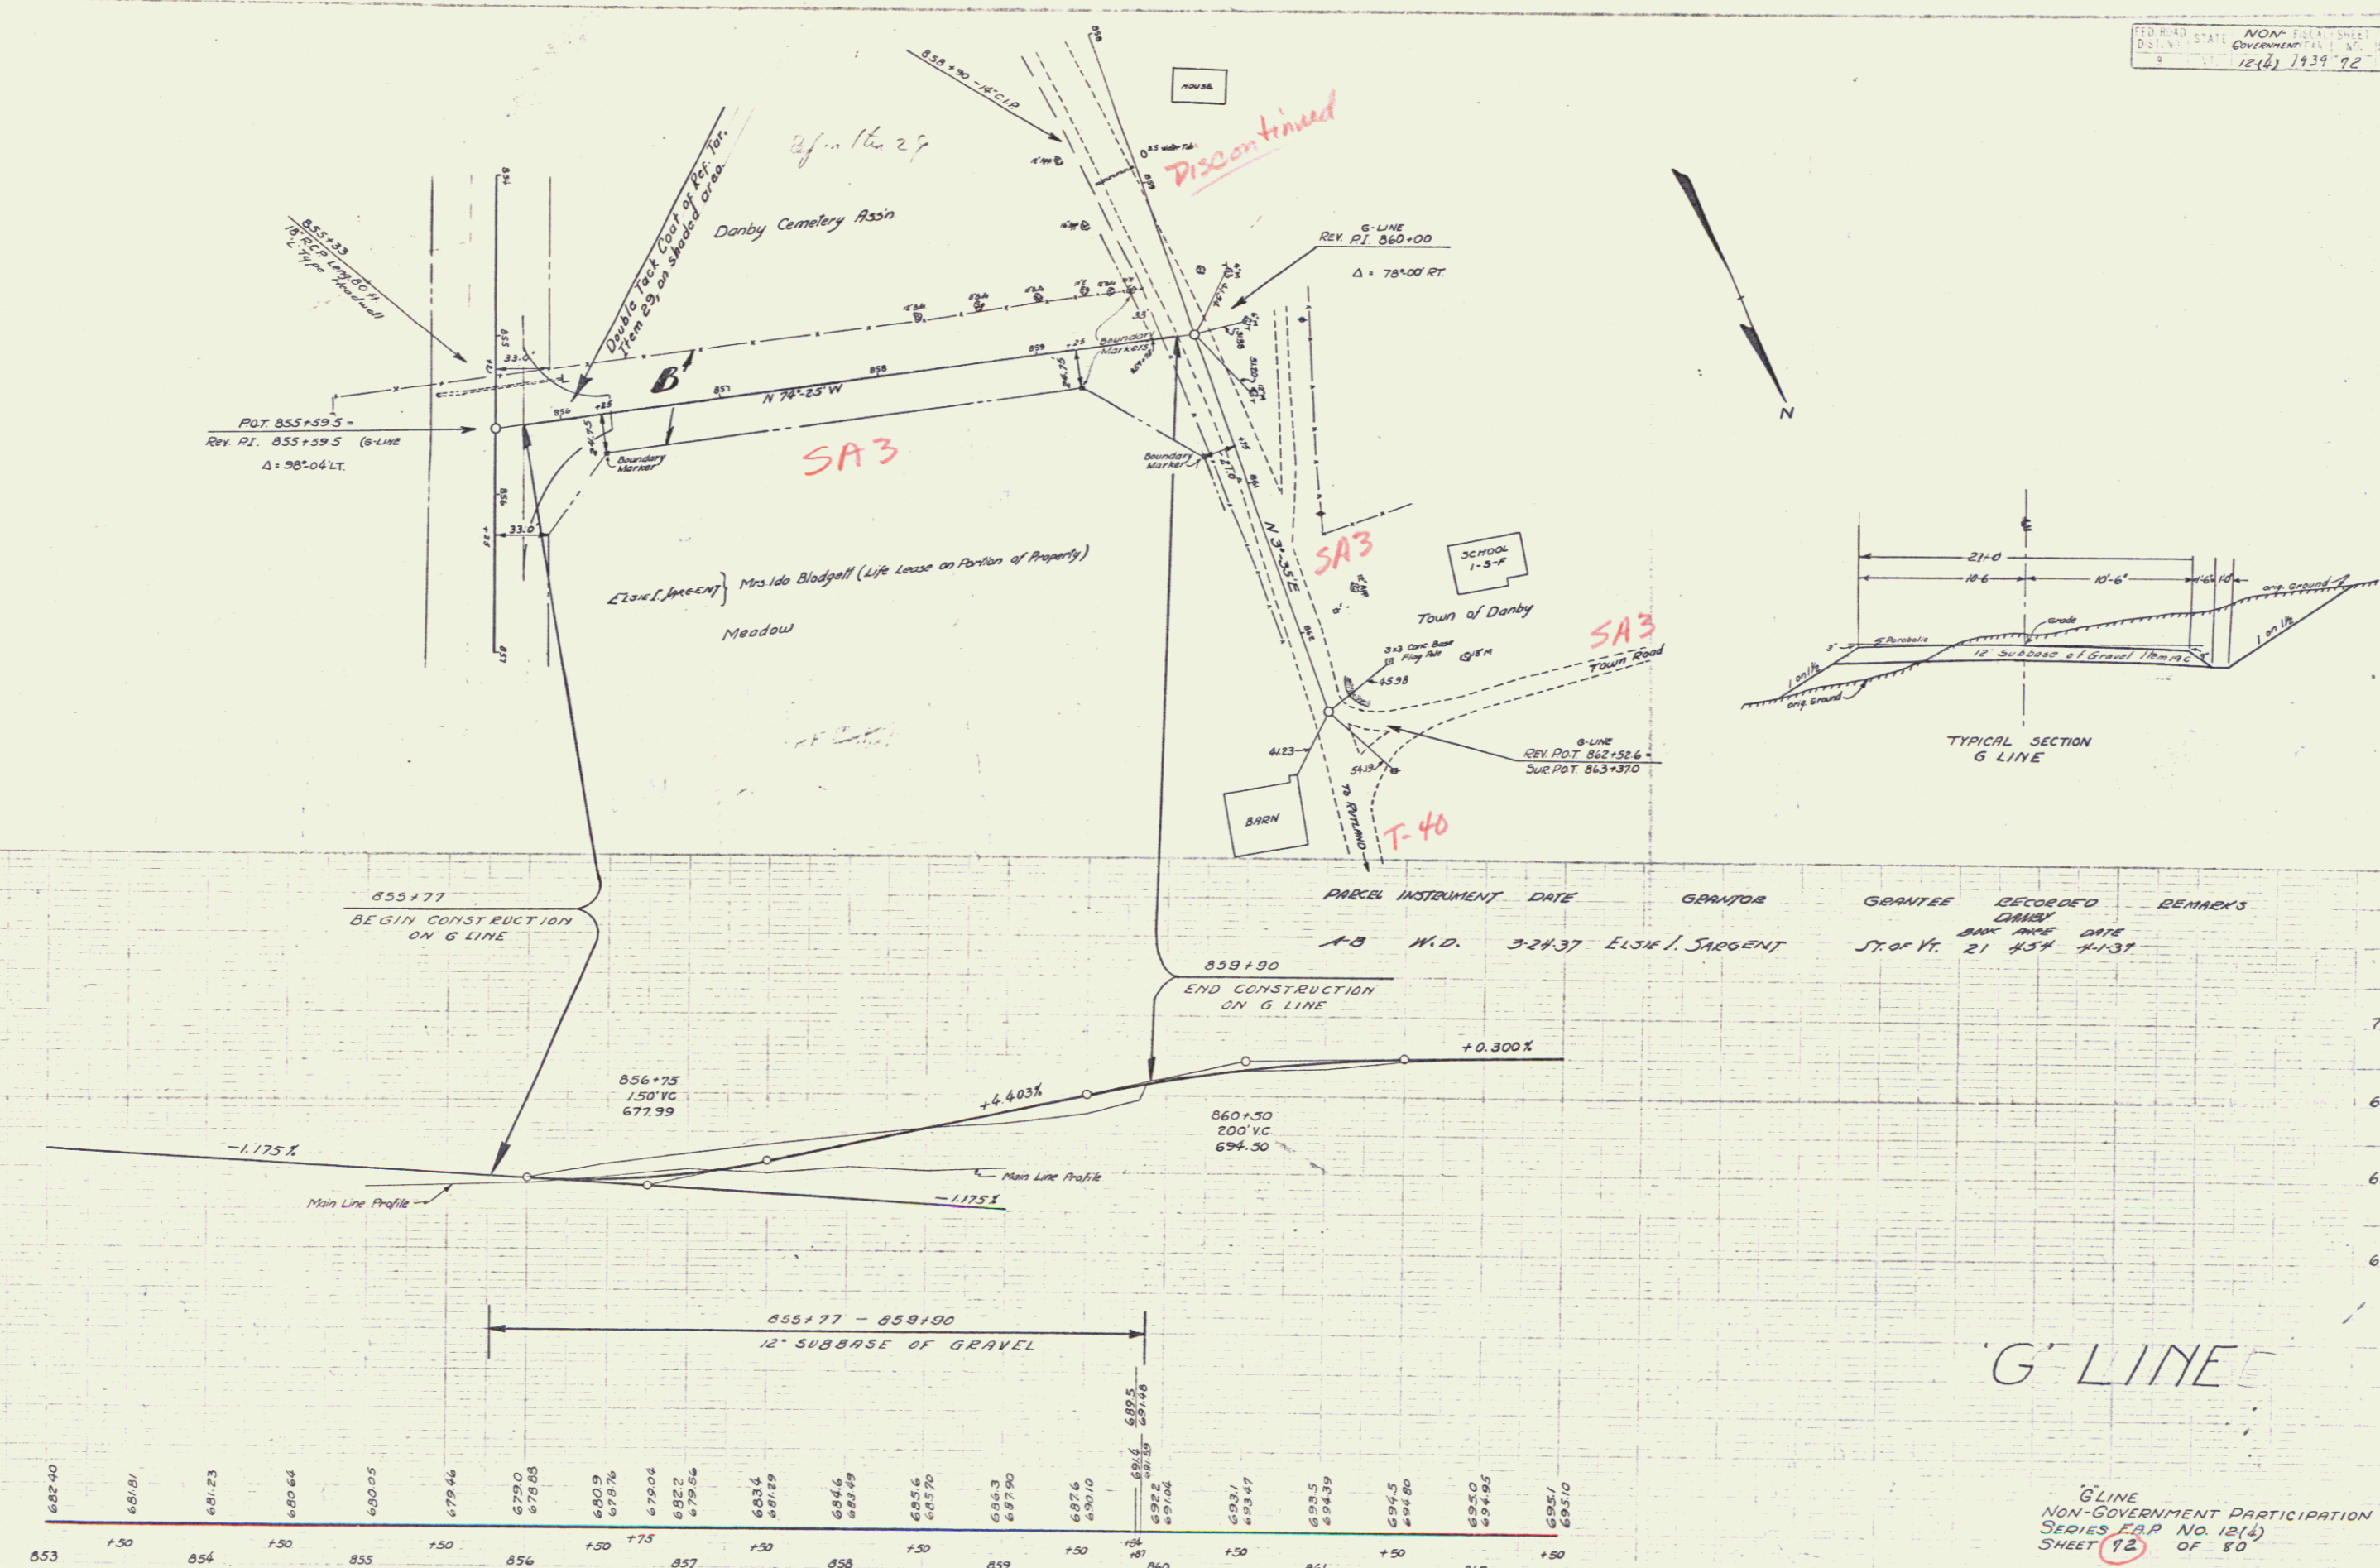

G LINE

G LINE  
 NON-GOVERNMENT PARTICIPATION  
 SERIES F.R.P. NO. 12(1)  
 SHEET 92 OF 80