

PLAN
 SCALE: AS SHOWN
 DATE: 10/60

PROFILE
 SCALE: AS SHOWN
 DATE: 10/60

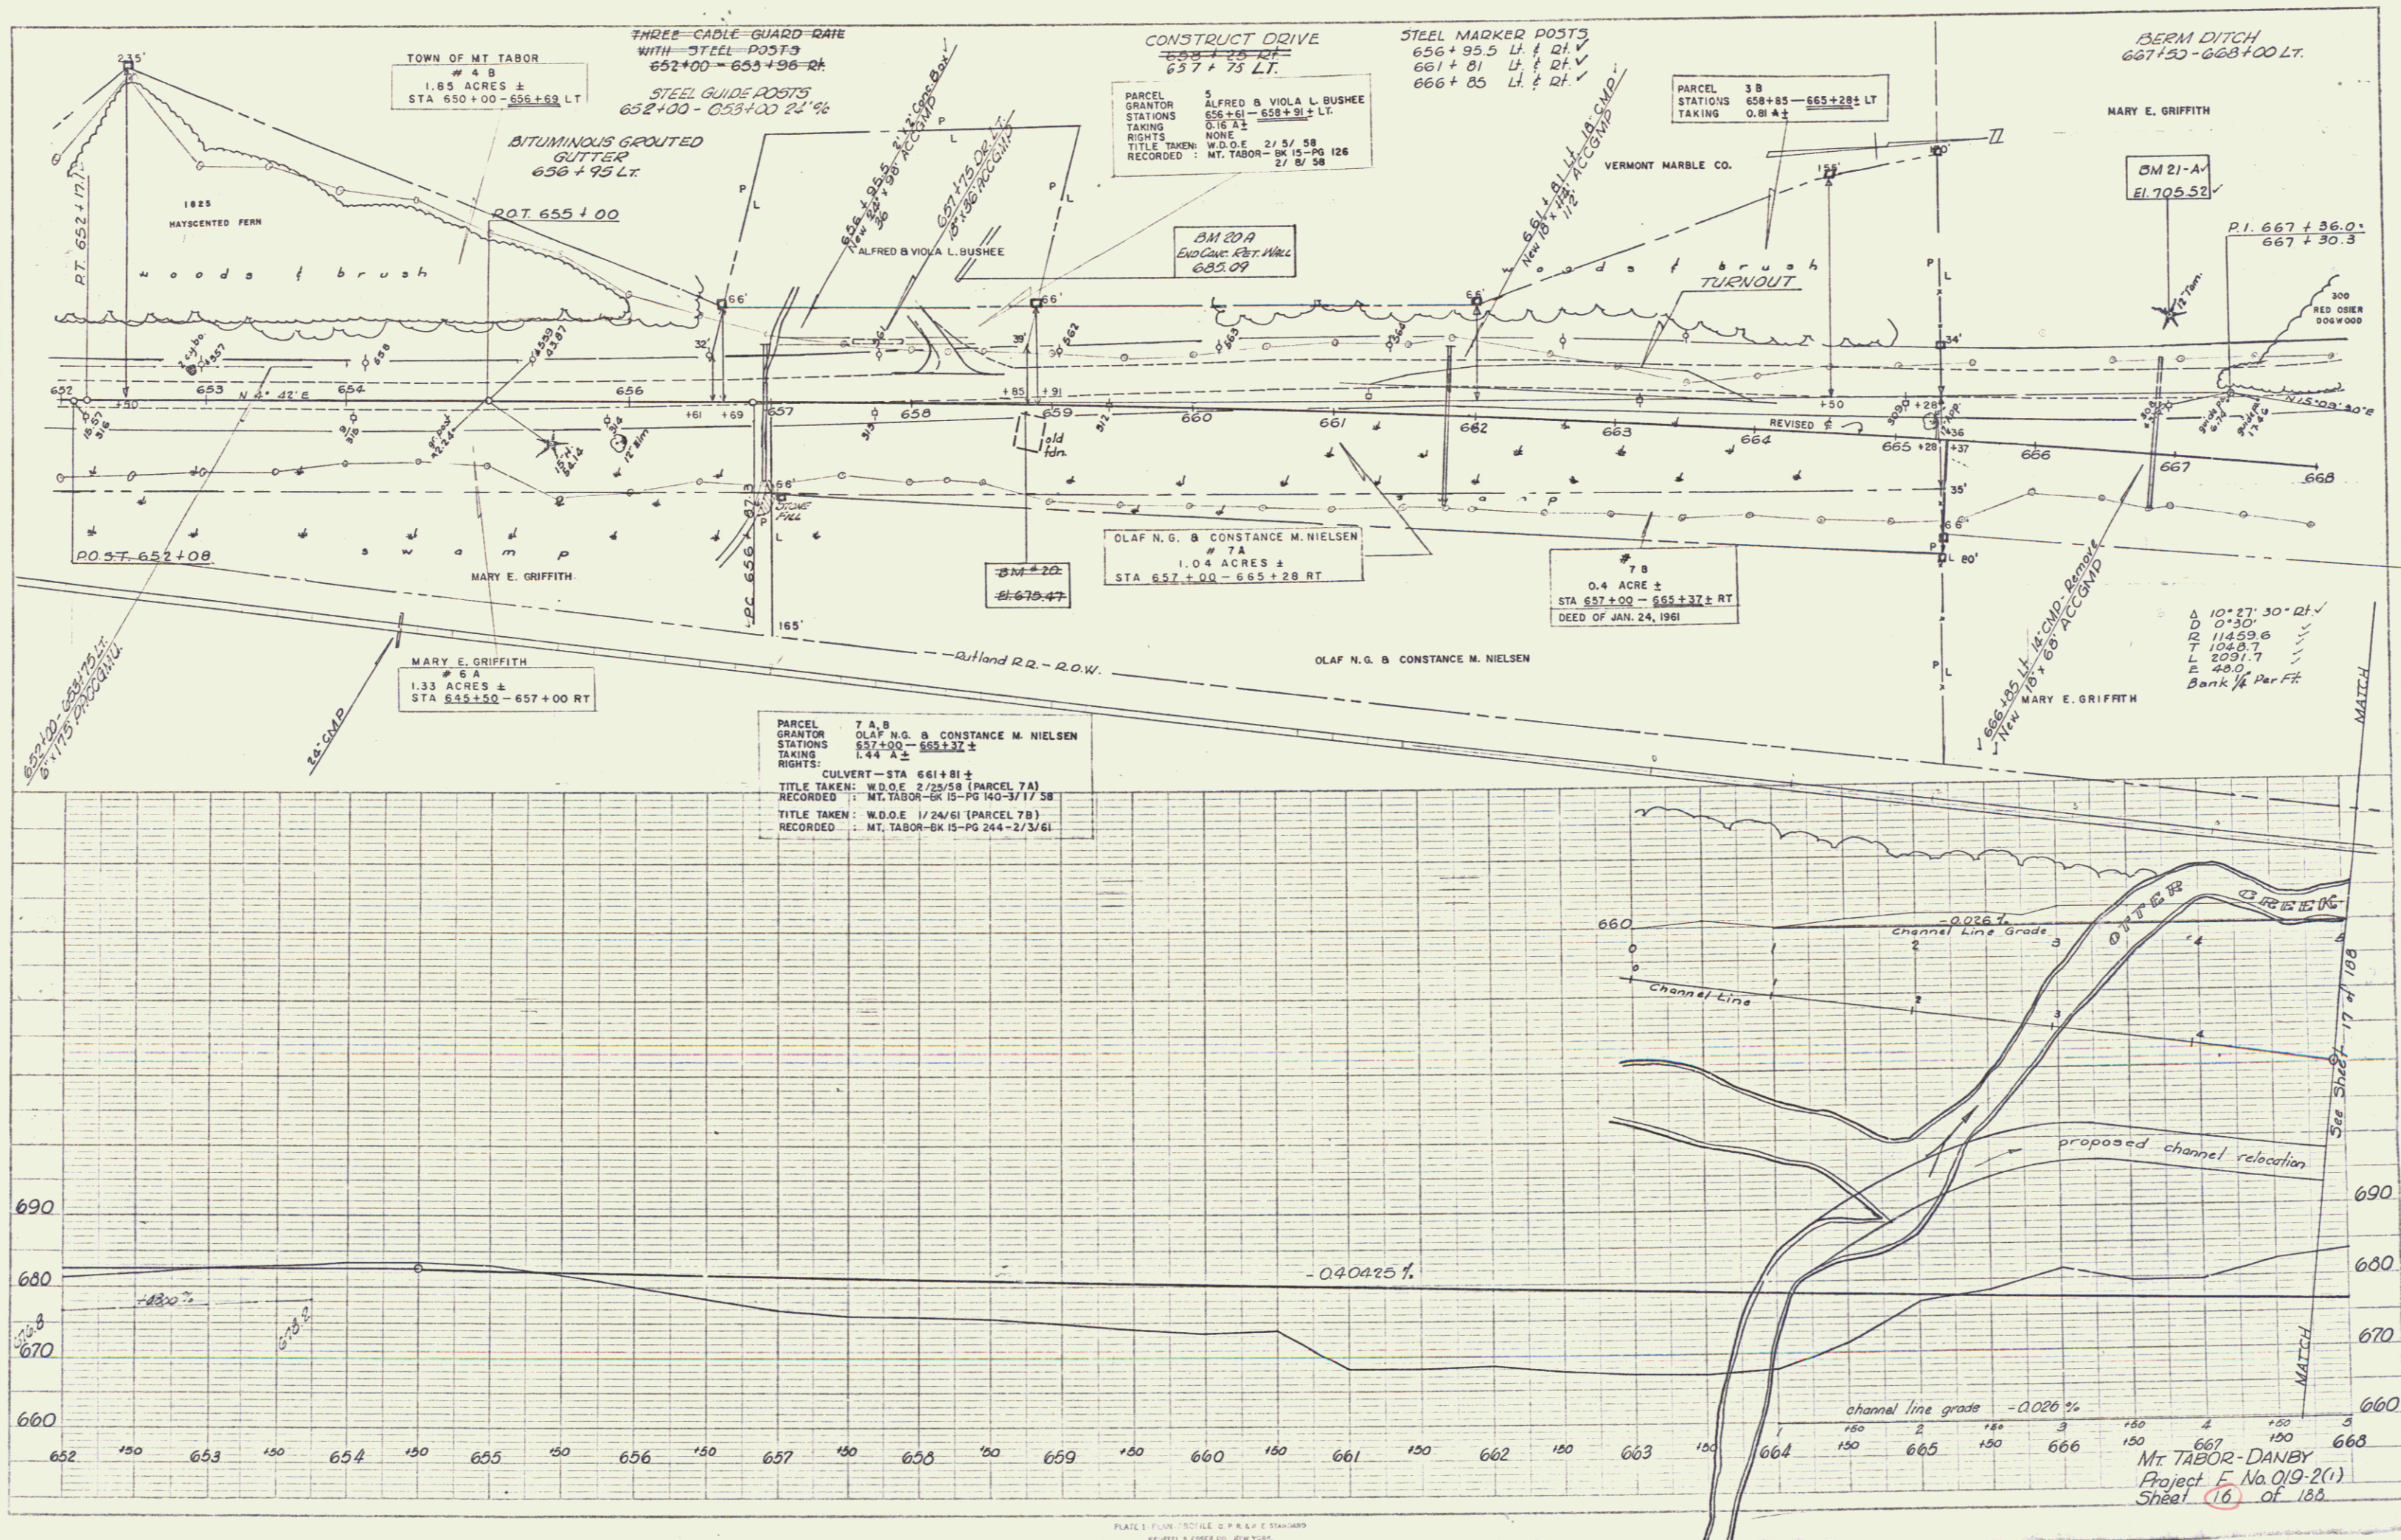


PLATE 1 - PLAN - PROFILE - P.A.S. & E. STANBARD
 KEUFFEL & ESSER CO. NEW YORK